



April 11, 2019

To: Ridgeland WRF Expansion Plan Holders

From: Paul Lewis

Re: Addendum #1
Ridgeland WRF Expansion

Below are the Addendum #1 items for the project. If you have submitted a question or comment and do not see it addressed here, please resubmit it to us.

1. Be reminded that the mandatory pre-bid meeting is at the Ridgeland Town Hall on April 16 at 2:00. A map to the sites is provided as an attachment to this addendum.
 - a. Town Hall: 1 Town Square, Ridgeland, SC 29936
 - b. Jimmy Mixson WRF: 366 Preacher, Ridgeland, SC 29936
2. Attached please find:
 - a. Section 00 41 00 C-410 Bid Form Article 5
 - b. Section 01 53 00 Temporary DAF and Pump
 - c. Section 46 51 13 Floating Mechanical Aerator
 - d. Revisions of the following drawings: G001, G002, G003 G004, G021, G022, M001, M101, M111, M201, M301, M311, M313, M401, M402, M701, M801, M802, M803, M811.
 - e. (There are other related drawings are in the works, but not ready at the time of this release. These are indicated by the asterisks (*) on the plan cover sheet.)
3. The ICEAS tank has been shifted south 21 ft in order to reduce excavation costs. It will remain at its original elevation. The construction sequence is being revised to show the ICEAS Train #1 being constructed and brought on line, then ICEAS #2 being constructed. We are working on the other drawings that show the details of this change, and will get them to you as soon as possible.

Addendum Reference #	Reference	Question / comment
1.0	Cover sheet	<ol style="list-style-type: none">1. The ESC, C, S, E, and CS revised drawings that are impacted by the addendum items below are in progress and will be issued soon.
1.1	Headworks - ESC002, M200s & S200s	<ol style="list-style-type: none">2. The discharge pipe from the headworks has been modified.
1.2	ICEAS - ESC002, M300s & S300s	<ol style="list-style-type: none">1. The pipe coming in from the headworks to the splitter box has been relocated.2. The ICEAS Tank has been shifted south 21 ft.3. The contractor has the option to construct ICEAS Tank #2 in either Phase 2 or Phase 3.

Addendum Reference #	Reference	Question / comment
1.3	Post-EQ Pond - ESC002, M400s & S400s	<ol style="list-style-type: none"> The shape of the EQ pond has been modified. The headwall has been eliminated. Use a pipe boot for the effluent pipe.
1.4	Post-EQ Pond - M400s, S400s, E013, CS001 & CS012	<ol style="list-style-type: none"> The post-EQ blowers and diffusers are being replaced with a floating aerator.
1.5		<ol style="list-style-type: none"> Reserved
1.6	UV Disinfection -G003 - Hyd profiles, ESC002, M700s & S700s, CS013	<ol style="list-style-type: none"> A second flume, second flow meter and slide gates are added, with 12-inch DIP to the existing effluent pump station.
1.7	Digester - G004 - Hyd profiles, ESC002, M800s & S800s	<ol style="list-style-type: none"> Base bid: Sludge holding pond, submersible decant pump, pump hoist Adder: Blowers, diffusers, mixers, catwalk, platform, area light
1.8	Sludge dewatering - G004 – Hyd profile, G012 – Demo, G022 – Phasing, ESC003, M800s, S800s, E002, E011, E012, CS014	<ol style="list-style-type: none"> The sludge dewatering area is being presented as an alternate. The storm drain piping is being modified.
1.9	LAS Pump Station - G012-Demo, E001 – One line	<ol style="list-style-type: none"> Capability to pump effluent to the existing Land Application System sod farm will remain functional. <ol style="list-style-type: none"> The existing LAS effluent pump station will remain functional.
1.10	ESC002	<ol style="list-style-type: none"> The Limits of Disturbance have been expanded.
1.11	Pipe schedule -- - M001	<ol style="list-style-type: none"> The following pipes shall be P-401 epoxy lined: <ol style="list-style-type: none"> 14" DIP forcemain from influent pump station to headworks 14"DIP from headworks bypass valve to splitter box 18" DIP from headworks to splitter box 18" DIP from splitter box to ICEAS General revisions to pipe schedule
1.12	Influent pump station - M101	<ol style="list-style-type: none"> The existing pump station is 17.5' x 8' x 18.5' (Top of wetwell to bottom of wetwell). You may use a 20' x 10' x 17' box if that helps you with excavation costs.

Addendum Reference #	Reference	Question / comment
1.13	Influent pump station - M101 - ESC002, ESC003, C001, C011, C012, M111	<p>1. The valve box has been eliminated and the valves will be placed above ground.</p>
1.14	ICEAS details - M313	<p>1. M313 has been reissued with better quality images.</p>
1.15	Section 00 41 00 Bid Form	<p>1. Eliminate adders #3 & #4 for concrete lining of post-EQ and digester.</p> <p>2. An alternate #3 is added for the digester and sludge processing area.</p> <p>3. Eliminated separate lines for taxes. The project is tax exempt for items related to the construction of process related equipment.</p> <p>4. A new Article 5 – Bid Form is provided.</p>
1.16	Section 01 53 00 Rental DAF unit	<p>1. Paragraph 1 General. Change North Lagoon to South Lagoon.</p> <p>2. Paragraph 2.1 Change 250 gpm to 450 gpm.</p> <p>3. Paragraph 2.2 Change 250 gpm to 450 gpm.</p> <p>4. Add Paragraph 6, which presents information regarding potential suppliers.</p> <p>5. A new spec sheet is provided.</p>
1.17	<i>Purchase Agreements for Pre-selected Equipment</i>	<p>1. The purchase agreements for the ICEAS and the Effluent Filters have been added to the website.</p>
1.18	Section 43 25 01, 01.1, 01.2 Influent and effluent pumps	<p>1. ABS is included as an approved vendor. Pete Duty Associates is the representative. Chris Caldwell chris@petedutysc.com, 864-918-1619.</p> <p>2. The spec calls for dual rail guide rail systems. The ABS standard is single rail, but we can supply dual rail if necessary. Must we provide dual rail?</p> <p style="color: red;">A. Single rail is fine if it works with your pump.</p> <p>3. The influent and effluent control panels are two separate panels, correct?</p> <p style="color: red;">A. Yes</p> <p>4. The control enclosures are to be indoor or outdoor, and painted steel or stainless steel?</p> <p style="color: red;">A. Outdoor under canopies (by others). Use stainless steel.</p> <p>5. If these are indoors, will the room have air conditioning? If outdoors or in a non-air conditioned room, should we add AC units to the controls (probably required for VFDs in the SC summer heat).</p> <p style="color: red;">A. They are outside and will need AC.</p>

Addendum Reference #	Reference	Question / comment
		<p>6. The primary level detection device is not defined in the spec, but could be a submersible pressure transducer or an ultrasonic sensor. Do you have a preference? I would recommend the ultrasonic for this application. A. Ultrasonic is fine.</p> <p>7. Section 14 of the control spec discussed full voltage NEMA contactors for motor starting, yet I think you intend all pumps to be VFD controlled. Do you want an integrated bypass system using the full voltage contactors for operating the pumps across the line in the event of VFD failure? A. Yes. Please include them.</p> <p>8. No dry contacts for connection to a SCADA system are mentioned in the spec. For these panels, I would recommend dry contacts for pump 1-2 run, pump 1-2 failure, pump 1-2 seal failure, high level, low level, phase failure. Shall we include these? A. Please include them. Also see controls and electrical diagrams.</p> <p>9. Provide a spare impeller if necessary with the spare pump if the pumps have different impellers.</p> <p>10. What is the static head for the two pump stations? A. Influent PS – 23 ft from Pump off to discharge. Effluent – 15 ft from Pump off to discharge high point.</p> <p>11. The specified Flygt pump selection is a 12" pump, but a much better selection for Sulzer-ABS is a 10" selection. Are you OK with us using the 10" pump? A. Yes.</p> <p>12. The control spec includes some Flygt proprietary control components. Can we quote the equivalent? A. Yes.</p> <p>13. The VFD spec hints at 18 pulse drivers, but never comes out and says it. Should we quote the much less expensive and perfectly suitable 6 pulse drives? A. Yes.</p>
1.19	Section 46 51 13 - Floating Aerator	1. A specification is provided. This aerator will replace the proposed Post-EQ blowers and diffusers.
1.20	00 21 13 C-200 Instructions to Bidders	1. Add the following as Paragraph 3.01.E "The contractor shall have completed at least two projects of similar scope in the last six years."

Addendum Reference #	Reference	Question / comment
1.21	Section 31 05 19 – Pond Liner	<p>1. Change Paragraph 1.09 Material Warranty to say:</p> <p>The Geomembrane manufacturer shall guarantee the geomembrane material to perform for a minimum of 10 years commencing with the date of final acceptance.</p>
1.22	Section 40 71 69	1. Change the first paragraph to reflect that 2 flumes are needed.
1.23	Section 40 60 00 – Instrumentation and Controls	<p>1. Change Paragraph 1.7 to read: “The approved CSIs are: Southern Flow (Alpharetta, GA), Lord & Company (Fort Mill, SC) and MR Systems (Norcross, GA).”</p> <p>2. Change Section 22.9 Post-EQ Pond as shown below.</p> <p>3. Change Section 22.13 Effluent flow meters as show below.</p> <p>4. Section 22.14. Though the digester is being bid as an alternate, the decant pump will be included as a base bid item. Also, if the digester blowers and mixers are not utilized, the pond will be equipped with two surface aerators which will function in the same way that the mixers do. Run status, run times, and motor faults from these aerators will be tied to the SCADA system. The surface aerators will be run by timers.</p>

22.9 Post-EQ Pond

22.9.1 Operation

22.9.1.1 The Post-EQ pond receives treated water from the ICEAS. The water is aerated by ~~two blowers and diffusers~~ a floating aerator prior to discharge to the Effluent Pump Station.

22.9.1.2 The ~~blowers have~~ aerator has the functionality to be controlled ~~off of~~ by timers.

22.9.1.3 An HOA switch shall be provided.

22.9.1.4 Blowers shall alternate each cycle.

22.9.1.5 Blower shall operate by VFD drives.

22.9.2 Functionality

Ref. #	Functionality	Provided by:
22.9.2.1	Blowers will alternate based ends of cycles or on a timed basis. <ins>Aerator will operate based on timer.</ins>	Vendor LCP
22.9.2.2	The blowers each <ins>aerator has</ins> have a hand-off-automatic (HOA) switch.	Vendor LCP
	Items to be displayed on SCADA system	

22.9.2.3	Run status of motors	CSI
22.9.2.4	Motor faults	CSI
	Items for remote control	
22.9.2.5	No remote control items.	
	Reports / trends	
22.9.2.6	Run time trends	CSI
22.9.2.7	DO trends	CSI
	Alarms	Operator Notification
22.9.2.8	Motor fault	No

22.13 Effluent flow meters

22.13.1 Operation

22.13.1.1 ~~A Two~~ flow meters measure the effluent flow in ~~a two~~ Parshall flumes. ~~One measures the flow to the stream; the other measures the flow to the LAS Pump Station.~~

22.13.1.2 The flow meters pace the UV intensity and the effluent flow ~~meter sampler. A switch shall be provided so that the active flow meter can pace the UV.~~

22.17 Generator for Influent Pump Station and Buildings LAS Pump Station

22.17.1 Operation

22.17.1.1 ~~This generator is existing and will furnish power to the influent pump station, influent flow meter and the operator buildings.~~

22.17.1.2 Functionality

Functionality Table deleted.

22.17.2 Operation

22.17.2.1 The existing LAS Pump Station will continue to function from its existing control panel.

22.17.3 Functionality

Ref. #	Functionality	Provided by:
22.17.1.3	Pumps operate according to the following levels: <ul style="list-style-type: none">• Alarm• Lag pump 1 on• Lag pump 2 on• Lead pump on	Pump vendor LCP

	<ul style="list-style-type: none"> Pumps off 	
	Items to be displayed on SCADA system	
22.17.1.4	Pump run status	CSI
22.17.1.5	Run time hours	CSI
	Reports / trends	
22.17.1.6	Pump run time trends for each pump and collectively	CSI
	Items for remote control	
22.17.1.7	None.	CSI
	Alarms	Operator Notification
22.17.1.8	Wetwell high level	Yes

If you have any questions, comments, or need further information, please email me at
paul@goldieassociates.com.

Sincerely,
Goldie Associates



Paul Lewis, PE
Project Engineer

ARTICLE 5 - BASIS OF BID

Bidder will complete the Work in accordance with the Contract Documents for the following price(s):

Bid for The Jimmy Mixson WRF Plant Expansion					
Lump Sum Items					
Item	Description	Unit	Quantity	Unit Price	Total Price
1.	Mobilization (not to exceed 3% of bid)	LS	1	\$	\$
2.	Sediment and Erosion Control	LS	1	\$	\$
3.	Sitework & Demolition	LS	1	\$	\$
	Grading, earthwork, paving, etc.				
4.	Operations Building				
	Construct the operations building, including appliances.				
	Allowances:				
	- Dishwasher	EA	1	\$700	\$700
	- Microwave	EA	1	\$300	\$300
	- Refrigerator	EA	2	\$2500	\$5000
	- Washer / dryer	EA	1	\$1400	\$1400
	- Furniture	EA	1	\$2000	\$2000
	- Tax on allowances	LS	1	\$756	\$756
	Balance of Operations Building	LS	1	\$	\$
5.	Division A – Influent Area				
	Description: Purchase and install Influent Pump Station, Flow Meter and associated piping and				

	forcemain, concrete work, electrical and controls. Purchase and install the bulk storage tanks, transfer pump, concrete work, piping at the tanks and to the influent pump station, canopy, and all appurtenances related to the Bulk Chemical Storage tanks.			
	Influent Area	LS	1	\$
6.	Division B – Headworks			
	Purchase and install the headworks (influent screen and grit removal system), with blower, vendor supplied controls, associated piping, concrete work, canopy and appurtenances. Taxes on headworks equipment.			
	Assigned purchase of headworks (taxes not included)	LS	1	\$182,402.00
	Balance of Division B	LS	1	\$
7.	Division C – ICEAS biological treatment system and Post – EQ basin			
	Description: Purchase and install the ICEAS with blowers, pumps, vendor supplied controls, flow junction boxes, associated piping, concrete work, and blower area canopy. Construct Post EQ Basin with blowers, liner and blower area canopy. Taxes on ICEAS equipment.			
	Assigned purchase of ICEAS (taxes not included)	LS	1	\$345,085.00
	Balance of Division C	LS	1	\$
8.	Division D- Effluent Pump Station, UV disinfection and Effluent Pipe.			
	Construct Effluent PS, UV, canopy, effluent pipe, creek discharge and all appurtenances.			
	Assigned purchase of UV equipment (taxes and import duties not included)	LS	1	\$121,000.00
	Balance of Division D	LS	1	\$
9.	Electrical			

	Purchase and install electrical panels (not supplied with equipment), conduit, wiring and emergency generator.				
	Electrical	LS	1	\$	\$
10.	Instrumentation, monitoring and controls				
	Purchase and install instrumentation and controls, samplers, and all associated wiring, programming and appurtenances related to the instrumentation and control system				
	Instrumentation	LS	1	\$	\$

Unit Price Items					
11.	Excavate unsuitable material	CY	300	\$	\$
12.	Replace unsuitable material with stone underneath structures	Ton	200	\$	\$
13.	Replace unsuitable material with soil from off-site borrow pit underneath structures	CY	150	\$	\$
14.	Removal of rock	CY	50	\$	\$
15.	Mobilization for removal of sludge to landfill	EA	1	\$	\$
16.	Removal of sludge to landfill	DRY TONS	175	\$	\$
17.	Fencing	LF	165	\$	\$
18.	Paving	SY	1214	\$	\$
19.	Total Bid Price (Items 1-19)			\$	\$
				<i>Bid price (in numerals)</i>	
					\$

<i>Bid price (in words)</i>					
	Quantities provided are estimates only. The Bidder must satisfy themselves with the accuracy of the estimated quantities listed in the bid by examination of the site and a review of the drawings and contract documents.				
	5.02 Alternates. Provide a cost for each of the alternates below				
1.	DAF and Pump Rental during construction of ICEAS #1	LS	1	\$	\$
2.	Purchase and install Effluent Filters with associated piping, electrical, controls and expanded canopy				
	Assigned purchase of effluent filters	LS	1	\$224,832.00	\$224,832.00
	Balance of work for effluent filters	LS	1	\$	\$
3.	Division E. - Digester and Geotube area				
	Construct digester, Geotube area and all appurtenances, including purchase of 4 Geotubes.				
	Division E	LS	1	\$	\$
4.	Spare influent / effluent pump	LS	1	\$	\$

SECTION 01 53 00
TEMPORARY DAF AND PUMP SYSTEM

Revision #	Date	Comments
1	4/3/19	Added rental information and changed system capacity.

1. GENERAL

This section presents the requirements for temporarily installing a Dissolved Air Flotation system and temporary pump at Lagoon 1 (south lagoon) during the construction of the ICEAS.

2. EQUIPMENT

2.1. DAF unit shall be capable of 450 gpm and shall be manufactured by FRC or approved equal. The unit shall be capable of producing an effluent quality of <5 mg/L TSS. The DAF should come with the necessary chemical tanks and mixing equipment for coagulant and polymer addition.

2.2. The pump shall be an electric suction lift pump capable of 450 gpm.

3. INSTALLATION

3.1. Supply all the necessary temporary piping for the DAF and pump system.

3.2. Provide hook ups to owner supplied power. You will need to supply your own disconnects, etc. The Owner is only providing the capability to tie in to the Owner's system.

3.3. Provide a functional system.

3.4. Make repairs to the system, if required.

4. OWNER'S RESPONSIBILITIES

4.1. The Owner will:

4.1.1. Purchase chemicals.

4.1.2. Operate the DAF / pump system.

4.1.3. Provide power for the system.

5. MEASUREMENT & PAYMENT

5.1. See Section 01 22 00 – Measurement and Payment for payment terms.

6. RENTAL

6.1. Rental DAF's are available from JWC Environmental Inc. in Cumming, GA.

6.2. For rental details contact Adriaan van der Beek

Office: (770) 534-3681

Cell: (678) 983-6422

adriaanv@jwce.com

6.3. Contractor may use approved alternate supplier.

[END OF SECTION]

SECTION 46 51 13

FLOATING MECHANICAL AERATOR

1. GENERAL

Furnish two (2) and install one (1) fully functioning and operable floating aerators. Each aerator shall consist of a motor, a direct drive impeller driven at a constant speed, and an integral flotation unit and capable of oxygenating water to a minimum of 6.0 mg/L.

Submitted bids shall be based on the aerator equipment meeting these specifications. Any other equal must meet the approval of the Engineer through the process as described in Submissions Procedures (Section 00 26 00). Equals must at a minimum be a one-piece stainless steel casting for the diffusion head. Fiberglass will not be accepted. The Supplier must also have a minimum of 10 installations of the same model & horsepower aerator in service.

2. AERATOR DRIVE MOTOR

- 2.1 Aerator shall transfer oxygen to satisfy 6.0 mg/L.
- 2.2 The motor shall be wired for 460 volt, 60 cycle, 3 phase service.
- 2.3 The motor shall be totally enclosed; fan cooled, and generally rated for severe chemical duty, and shall have a 1.15 service factor.
- 2.4 The motor windings shall be non-hydroscopic, and insulation shall equal or exceed NEMA Class "F".
- 2.5 A condensate drain shall be located at the lowest point in the lower end-bell housing.
- 2.6 All motor frame parting surfaces shall be deep registered and Permatex (or equal) sealed.
- 2.7 All through bolts, nuts, and screws shall be of type 18-8 stainless steel.
- 2.8 Each motor will have a raincap constructed of cast iron or non-corrosive 304 stainless steel. Painted or plated carbon steel rain caps will not be acceptable.
- 2.9 A stainless steel nameplate shall be provided with each motor and shall be securely fastened thereto. The voltage, speed, insulation class, amperage, service

factor, wiring diagram, motor serial number, and the manufacturer's name and address shall be steel stamped or otherwise permanently marked.

3. **MOTOR SHAFT**

Unit shall have a one-piece motor shaft continuous from the top motor bearing, through the lower bearing and down to, and through, the propeller. This shaft will have a minimum diameter of 1-3/4-inch and be manufactured from 17-4 PH stainless steel, or comparable stainless steel having a minimum yield strength of 100,000 psi on units 3 HP and larger.

4. **RPM**

Units shall operate at the lowest RPM offered in this size by the manufacturer. In no case shall nominal RPM exceed 1800 for units meeting the one-piece shaft specified above. Units featuring one-piece shaft shall operate nominally at 1800 RPM in the size range of 3 to 15 HP, or at a nominal maximum speed of 1200 RPM for units in the 20 to 75 HP size range.

5. **MOTOR BEARING**

- 5.1 Motor bearings shall be regreasable. Sealed bearings are not acceptable. Top bearing shall be shielded on the bottom side only. Bottom bearing shall be open.
- 5.2 The top and bottom motor bearings shall be of the combined radial and axial thrust type and shall be packed at the factory with a "high performance" grease.
- 5.3 The lower motor bearing inner race shall be locked to the motor shaft via a special washer and locking nut arrangement. The shaft shall be threaded just below the lower bearing and shall have a keyway cut into the motor shaft. This key shall accept a tab from the I.D. of the locking washer, and the locking nut shall have recesses to accept a tab from the O.D. of the locking washer to prevent the nut from backing off. Snap ring type bearing retainers are not acceptable.

6. **DIFFUSION HEAD**

- 6.1 The design of the diffusion head shall be such that the liquid spray will discharge at an angle of 90° to the motor shaft, and over a 360° pattern in the horizontal plane, and shall be a stainless steel monolithic casting.

- 6.2 The diffusion head casting shall act as a base for the aerator motor, and alignment of the motor to this base shall be controlled by machined index fittings that engage the P-base of the motor. Diffusion head/motor arrangements that are dependent upon boltholes only for alignment will not be acceptable. All diffusion head hardware will be 304 stainless steel and safety wired.
- 6.3 The diffusion head casting shall act as a thrust block to deflect the high velocity, pumped volume of the aerator from the vertical to the horizontal direction. In order to minimize vibration, and to provide adequate strength, the diffusion head casting shall weigh no less than 85 lbs. The bottom side of this casting shall have a 90°-radiused transition to effect the hydraulic change in direction with a minimum of head loss.
- 6.4 The diffusion head shall absorb all normal and shock loads encountered by the propeller and transmitted to the diffusion head via the motor shaft and lower motor end-bell. The diffusion head shall distribute these forces into the float via webs that terminate in a flange or ring that is an integral part of the diffusion head. This flange shall mate with a similar flange that is an integral part of the float/volute to spread the stresses generated by the propeller uniformly around the float so that no point loading of the float is allowed. These flanges shall be machined flat to provide proper bearing surfaces. The alignment of the diffusion head flange to the float/volute shall be by use of a 360° index pilot.
- 6.5 Specifically, diffusion head designs that employ studs and spacers, shoulder bolts or fiberglass are not allowed. Load bearing, machined flat, flange-to-flange connections will be mandatory.
- 6.6 The diffusion head shall contain an anti-deflection journal insert to limit the radial deflection of the motor shaft.
- 6.7 This anti-deflection journal insert shall be located in the lower extremity of the diffusion head, approximately one-half the distance between the motor base and the lower end of the shaft.
- 6.8 The journal insert shall be machined from Delrin or molded from moly-filled urethane and shall be a minimum of 0.060-inch diameter or larger through the bore than the diameter of the motor shaft.
- 6.9 Units featuring a one-piece unsupported shaft will not be acceptable.

6.10 There shall be a fluid deflector located on the motor shaft immediately below the anti-deflection journal, which shall cover completely the anti-deflection journal insert and the lower portion of the diffusion head.

6.11 This fluid deflector shall be molded from black neoprene and shall be press fit onto the motor shaft.

7. **FLOTATION**

7.1 Each aerator shall have 965 lbs. reserve buoyancy to ensure stability and to provide support flotation required during aerator servicing. Floats shall be one piece, i.e.; segmented floats are not acceptable.

7.2 Flotation stability will be mandatory. Under no circumstances will unstable floatation designs requiring counter balancing, liquid ballast, solid mass, or submerged major fabricated assemblies to stabilize the operation of the aerator be allowed. Only aerators demonstrating stable operational characteristics, without rocking or oscillating will be acceptable.

7.3 The float shall be a minimum of 71-inch in diameter and 12-inch thick, and shall be fabricated of approved fiberglass construction as later described herein.

7.4 All floats shall be constructed so that the internal void can be filled full of closed cell polyurethane foam having a minimum 2.0 lbs/ft³ density and shall be completely sealed water tight.

7.5 All floats shall have six mooring points, spaced for 3 or 4-point mooring around the outer circumference. No mooring connections will be allowed to be attached to the upper or lower float covers. Only tension type connections perpendicular to the outer sidewall will be approved. All mooring connections shall be stainless steel.

7.6 Floats shall be constructed of polyester fiberglass resins and shall have a resin/glass content of 70 percent resin and 30 percent glass. A minimum 0.014-inch thick gel coat shall cover the entire outer float shell.

7.7 A moisture inhibitor, such a N.P.G. (neopentyl glycol) or equal, and an ultraviolet inhibitor, such a UV9 or equal, shall be used to protect the float from moisture and sunlight damage.

- 7.8 The construction of the float shall be such that no under-water joints shall be used. Joints used to connect the top coverlid shall be overlapped a minimum of 1-1/2-inches, both parts of all joints shall be ground to glass fiber and a resin/glass adhesive shall be applied to complete a 100 percent monolithic glass-to-glass bond.
- 7.9 The float construction shall be such that the volute will distribute the load of the entire motor, drive, diffusion head, and volute static load plus, the entire dynamic load from the propeller thrust and radial forces by spreading these forces uniformly around the full 360° circumference of the float's central core. Point connected joints or point stressed connections will not be accepted.
- 7.10 The minimum flexural strength of the fiberglass construction materials shall be 26,000 psi and the minimum tensile strength shall be 10,000 psi.

8. PROPELLER

- 8.1 The propeller shall be a two-blade, left-handed, marine type precision casting of 316 stainless steel, 11-1/2-inch diameter, and shall be specifically designed for the application intended. It shall be a self-cleaning type that will not accumulate fibers, rags, stringy materials, etc. The propeller will have a diameter not allowing a greater clearance with the volute of 1/4-inch.
- 8.2 Each propeller blade shall be pitched so that the pitch angle and rake angle are within \pm 2 percent of the other blade(s).
- 8.3 The propeller shall be pitched so that the drive motor is loaded between 88 percent and 94 percent of full load nameplate horsepower.
- 8.4 Units using inclined screw impellers will not be acceptable.
- 8.5 The propeller must be attached to the motor shaft with a hardened stainless steel pin and set screw. No tapered, threaded shafts with nut fasteners will be acceptable.

9. VOLUTE

- 9.1 The propeller shall operate in a volute made of 304 stainless steel and shall be a minimum of 12-inch in diameter. It shall be round and true so that propeller blade tip clearance is uniform within the volute as it rotates. The volute shall have a minimum of 3/16-inch wall thickness, and a minimum of four full-length stainless

steel gussets shall be welded on a 90° spacing around the circumference of the volute between the top and bottom flanges.

- 9.2 The volute shall have a large machined flange at its top extremity that completely encircles the volute, and this flange shall match a similar flange on the bottom of the diffusion head to provide for a bolted, machined flange-to-flange fit to provide uniform distribution of the dynamic loads generated by the propeller and the static weight of the motor and drive. A 360° machined index in the upper flange shall provide concentric alignment of the propeller in the volute by engaging the inside diameter of the mating flange on the diffusion head. Bolt holes alone will not be acceptable to locate the important alignment of the propeller.
- 9.3 Fiberglass volutes, or carbon steel volutes that are fiberglass, steel or stainless steel lined are not acceptable.

10. INTAKE CONE

- 10.1 The intake cone shall be fabricated from .075-inch 304 stainless steel having a gradually expanding opening outward to the intake end. The length and inlet diameter shall be sufficient to provide uniform inlet hydraulics so that no increase in vibration is caused due to its shape or size. The minimum acceptable length is 8-inches and minimum inlet diameter is 16-1/4-inches.
- 10.2 The material used to fabricate the intake cone shall be structurally sufficient to support the weight of the entire aerator assembly when the aerator is freestanding on dry ground.
- 10.3 For maximum in-depth mixing efficiency, the intake cone shall be designed so that the suction lift from the aerator propeller is vertical from the liquid depth below the aerator. Unless specifically required for anti-erosion requirements, side or angle entry suction inlets will not be approved. Fiberglass intake cones are not allowed. All aerators 20 HP and larger must provide anti-vortex crosses welded inside the cones. Anti-erosion devices, if required, must be welded to the crosses.

11. BALANCING

- 11.1 The entire rotating assembly including the motor rotor, shaft, shaft accessories, and impeller shall be dynamically balanced to within 2.0 mils peak-to-peak horizontal displacement measured at the upper and lower motor bearing. Measurements shall be taken at a frequency equivalent to the motor RPM.

11.2 Measurements shall be taken with the motor in a vertical, shaft down position and with the entire power section mounted on resilient pads.

12. **STABILIZER CROSS ASSEMBLY AND ANTI-EROSION ASSEMBLY**

12.1 Each unit shall be furnished with a 304 stainless steel stabilizer cross assembly.

12.2 Each unit shall be furnished with an anti-erosion assembly.

13. **MOORING**

13.1 To allow for water level variation, a 304 stainless steel restrained mooring frame shall be utilized. A triangular, or delta, mooring frame shall be fastened to the bottom of the aerator float, and will consist of 304 stainless steel mooring arms to which are attached removable U-bolts which shall fit around 304 stainless steel posts (posts provided by Contractor/Purchaser) 4-inch diameter, which shall permit the unit to rise and fall with the varying water level. Mooring arms attached to side skins of the float are not acceptable.

13.2 A 304 stainless "J" bolt shall be utilized to connect the frame to the flotation unit. A minimum of three (3) connections is required.

14. **ELECTRICAL SERVICE CABLE**

14.1 Electrical service cable shall be provided and shall be a continuous length; that is non-spliced. The cable shall have three power conductors and a ground conductor.

14.2 Conductors shall be flexible type annealed copper stranded. Each conductor, including the ground conductor, shall be insulated. Cables containing an uninsulated ground conductor will not be acceptable.

14.3 The insulated conductors shall be assembled together with a non-hygroscopic filler material.

14.4 The outer jacket shall be high quality CPE, PVC, TPE or equal, and shall be rated at a conductor operating temperature of not less than 90°C.

14.5 The cable shall be rated for hard usage, outdoor service and shall be resistant to oil, sunlight, ozone, grease, acids, water, abrasion, and impact.

15. INSTALLATION, OPERATING, AND MAINTENANCE MANUALS

- 15.1 The aerator manufacturer shall provide three copies of a detailed manual that shall include specific instructions for receiving and handling, assembly, mooring, wiring, installation, repair and service, storage, troubleshooting, detailed exploded drawings of the unit, and a full parts list.
- 15.2 In addition, the manual shall contain complete detailed instructions on the balancing procedure to be used for rebalancing to the propeller after it has been in service for an extended period of time. These instructions shall include, a general procedural description, a detailed explanation of preparing the unit for balancing, and the balancing procedure for propellers.
- 15.3 These manuals shall be submitted for review, along with other general submittal information, including detailed drawings, brochures, cut-sheets, motor data sheets, etc., as a part of the approval process.

16. MANUFACTURER

The aerator shall be manufactured by Aqua-aerobics or Aerator Solutions. Equals must be approved by the Engineer as previously specified.

The aerator specified herein shall incorporate design enhancements that provide operation for five years without routine maintenance (greasing).

17. WARRANTY

The aerator shall be warranted for three years for defects in materials and workmanship.

18. SERVICE

In order to provide prompt service response to the owner, a factory-trained technician must be available 24 hours per day within one (1) hour response time to the wastewater treatment plant (WWTP).

JIMMY MIXSON WASTEWATER RECLAMATION FACILITY (WRF) EXPANSION

TOWN OF RIDGELAND, JASPER COUNTY, SOUTH CAROLINA



Town of Ridgeland
Joseph N. Malphrus, Mayor
Josephine Boyles, Councilwoman
Chris Dubose, Councilman
Tommy Rhodes, Councilman
Grady Woods, Councilman
Dennis Averkin, Town Administrator

TABLE OF CONTENTS



VICINITY MAP

TOWN HALL

The purpose of this project is to replace the existing wastewater lagoons with an SBR treatment system. The capacity of the plant is also being expanded, and a new operator building is being constructed. Presently, the system discharges to a sod farm; the new facility will discharge to nearby Captain Bill's Creek.

RELEASE HISTORY

RELEASE	SHEETS INCLUDED IN RELEASE	DATE
<i>A</i>	<i>Cover, General, Civil, Mechanical, and Control Systems to DHEC</i>	<i>8/1/18</i>
<i>B</i>	<i>Cover, G011 & G012, E&SC, and Civil to DHEC Stormwater</i>	<i>8/27/18</i>
<i>C</i>	<i>Cover, E&SC, and Civil to DHEC Stormwater</i>	<i>10/29/18</i>
<i>D</i>	<i>Complete set to RD for review</i>	<i>12/12/2018</i>
<i>E</i>	<i>Release for Bid - Complete Set</i>	<i>4/2/2019</i>
<i>F</i>	<i>Addendum #1 - As Noted "/*"</i>	<i>4/11/2019</i>





210 West North Second Street 324 6th Ave North,
Seneca, SC 29678 Jacksonville Beach, FL 32250
www.goldieassociates.com www.4weng.com

 DENOTES A CHANGE IN THE PLANS FROM THE ADDENDA
THE FIRST NUMBER REFERENCES THE ADDENDUM NUMBER WHILE
THE SECOND NUMBER REFERENCES THE ADDENDUM ITEM NUMBER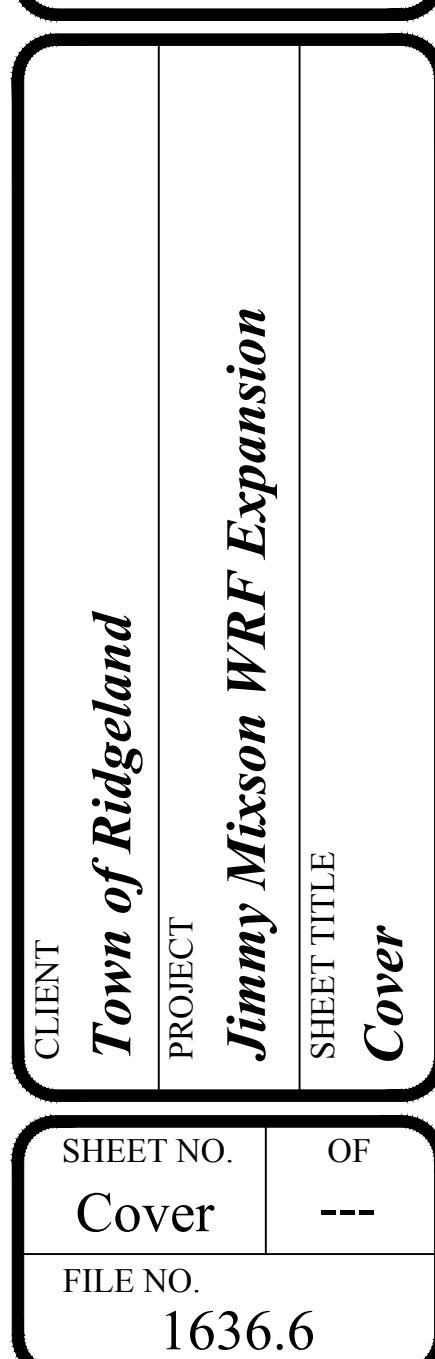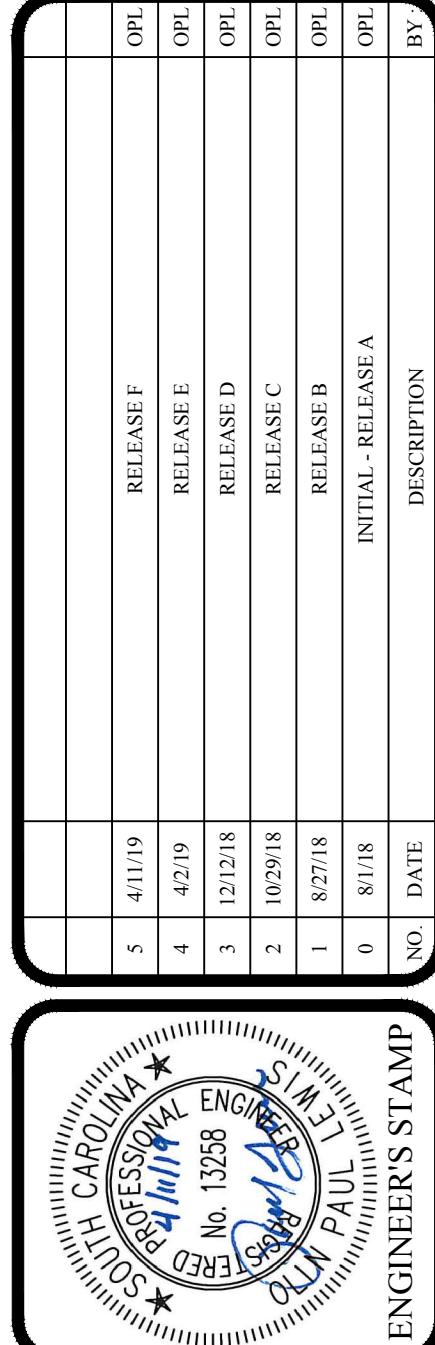

CONTROL SYSTEM FUNCTION IDENTIFICATION					CONTROL SYSTEM AND MECHANICAL SYMBOLS	GENERAL ABBREVIATIONS	GENERAL LEGEND	
FIRST LETTER(S)		SUCCEEDING LETTERS					EXISTING	PROPOSED
MEASURED OR INITIATING VARIABLE	MODIFIER	READOUT OR PASSIVE FUNCTION	OUTPUT FUNCTION	MODIFIER			X 000.00	X 000.00
A ANALYSIS		ALARM				GATE VALVE	AC ASBESTOS CEMENT	
B BURNER (FLAME)						GLOBE VALVE	ARV AIR RELEASE VALVE	
C CONDUCTIVITY			CONTROL			PLUG VALVE	ASP ASPHALT	
D DENSITY	DIFFERENTIAL					BALL VALVE	AVG AVERAGE	
E POTENTIAL (ELEC)		PRIMARY ELEMENT				BUTTERFLY VALVE	B BACK OF CURB	
F FLOW RATE	RATIO					CHECK VALVE	BW BACKWASH	
G FIRE, SMOKE		GLASS				STRAINER	CIFG CURB INLET FRAME & GRATE	
H HAND				HIGH		REDUCER	CF CUBIC FEET	
I CURRENT (ELEC)		INDICATE				PRESSURE REGULATING VALVE	CMP CORRUGATED METAL PIPE	
J POWER	SCAN					SOLENOID OPERATED VALVE	CP CONTROL PANEL	
K TIME	TIME RATE CHANGE		CONTROL STATION			RELIEF VALVE	CS CAUSTIC SODA	
L LEVEL		PILOT LIGHT		LOW		STATIC MIXER	CV CONTROL VALVE	
M MOISTURE	MOMENTARY			MIDDLE		VARIABLE AREA FLOW METER (ROTAMETER)	CY CUBIC YARDS	
N HYDROGEN-ION						AIR INLET FILTER-SILENCER	D DRAIN	
O DISSOLVED OXYGEN		ORIFICE				VARIABLE FREQUENCY DRIVE (ELEC)	DIST DISTANCE	
P PRESSURE		TEST CONNECTION				METERING PUMP	DS DIGESTED SLUDGE	
Q QUANTITY	INTEGRATE					ROTARY LOBE COMPRESSOR	DW DISTILLED WATER	
R RADIATION		RECORD				CENTRIFUGAL PUMP	EFF EFFLUENT	
S SPEED, FREQUENCY	SAFETY		SWITCH			CONTINUED ON SHEET CS013	ELEV ELEVATION	
T TEMPERATURE			TRANSMIT			CONTINUED FROM SHEET CS014	EOP EDGE OF PAVEMENT	
U MULTIVARIABLE		MULTIFUNCTION	MULTIFUNCTION	MULTIFUNCTION			FE FILTERED EFFLUENT	
V VIBRATION			VALVE, DAMPER				FF FINISHED FLOOR	
W WEIGHT, FORCE		WELL					FG FINISHED GRADE	
X UNCLASSIFIED		UNCLASSIFIED	UNCLASSIFIED				FM FORCE MAIN	
Y EVENT, STATUS			RELAY, COMPUTE				FOC FACE OF CURB	
Z POSITION			MISC ACTUATOR				GICB GRATE INLET CATCH BASIN	
GENERAL DRAWING SYMBOLS								
SECTION LETTER IDENTIFICATION SHEET WHERE THE SECTION IS DRAWN SECTION LETTER IDENTIFICATION SHEET WHERE THE SECTION IS CALLED OUT DETAIL NUMBER IDENTIFICATION SHEET WHERE THE DETAIL IS DRAWN DETAIL NUMBER IDENTIFICATION SHEET WHERE THE DETAIL IS CALLED OUT								
CONTINUED ON SHEET CS013 CONTINUED FROM SHEET CS014								



1.9 JUNCTION BOX
LAS LOCAL CONTROL PANEL
LCP LAND APPLICATION SYSTEM

SPOT GRADE	EXISTING
POWER POLE	X 000.00
BENCHMARK	
GUY WIRE	
IRON PIN	
CATCH BASIN	
JUNCTION BOX/STORM DRAIN LID	
STORM DRAINAGE FLOW	
TRAFFIC FLOW	
STONE CHECK DAM	
RIP RAP INLET/OUTLET PROTECTION PAD	
WATER METER	
HYDRANT	
WATER VALVE	
ARV	
BLOWOFF	
TREE	
BUSH	
MAILBOX	
SEWER MANHOLE	
GAS VALVE	
LIGHT POLE	
SIGN	
MINOR CONTOUR	
MAJOR CONTOUR	
EDGE OF PAVEMENT	
CURB AND GUTTER	
PROPERTY LINE	
RIGHT-OF-WAY	
EASEMENT	
SETBACK	
FENCE	
STORM DRAIN	
OVERHEAD POWER	
UNDERGROUND POWER	
UNDERGROUND TELEPHONE	
SANITARY SEWER	
SANITARY SEWER LATERAL	
FORCE MAIN	
WASTE ACTIVATED SLUDGE	
RETURN ACTIVATED SLUDGE	
PROCESS AIR	
GAS LINE	
WATERLINE	
SILT FENCE	
DISTURBED AREA BOUNDARY	
WETLANDS LIMIT	
WETLANDS BUFFER	
UNKNOWN UTILITY	
TREELINE	
ELECTRIC SIGNAL (DISCRETE)	
ELECTRIC SIGNAL (ANALOG)	
POWER (CONTROL SYSTEM)	
HYDRAULIC	
SOFTWARE OR DATA LINK	

THIS DRAWING AND THE DESIGN SHOWN THEREON ARE THE PROPERTY OF GOLDIE ASSOCIATES. THE REPRODUCTION, COPYING OR USE OF THIS DRAWING WITHOUT WRITTEN CONSENT IS PROHIBITED AND ANY INFRINGEMENT WILL BE SUBJECT TO LEGAL ACTION.
 DENOTES A CHANGE IN THE PLANS FROM THE ADDENDA
 THE FIRST NUMBER REFERENCES THE ADDENDUM NUMBER WHILE THE SECOND NUMBER REFERENCES THE ADDENDUM ITEM NUMBER

SHEET NO. G001 OF 1
FILE NO. 1636.6
Legends, Symbols, and Abbreviations

CLIENT Town of Ridgeland
PROJECT Jimmy Mixson WRF Expansion
SHEET TITLE Legend, Symbols, and Abbreviations
SHEET NUMBER 1
FILE NUMBER 1636.6



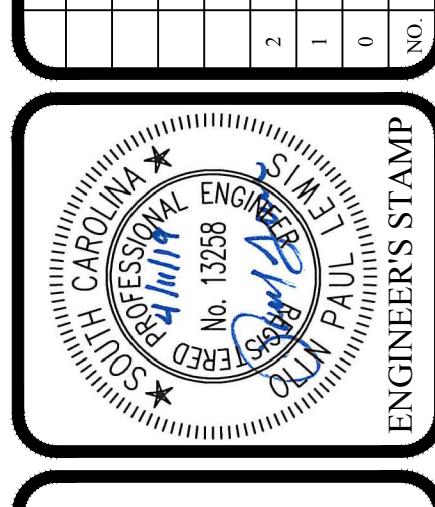
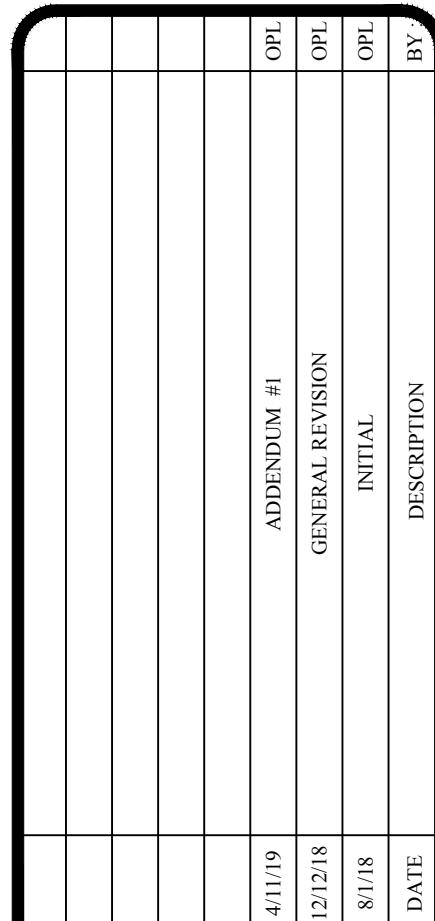



210 W. North Second Street
Seneca, SC 29678
Phone: (864) 882-8194
Civil and Environmental Engineering
Utility Operations
Environmental Laboratory




www.goldieassociates.com
WE LISTEN. WE SERVE.

ADDITIONAL INFORMATION
ADDITIONAL #1
4/10/19
12/2/18
GENERAL REVISION
INITIAL
NO. DATE
0 8/1/18
NO. DATE
1 12/2/18
ADDITIONAL #2
13258
4/10/19
GENERAL REVISION
INITIAL
NO. DATE
0 8/1/18
ADDITIONAL #3
13258
4/10/19
GENERAL REVISION
INITIAL
NO. DATE
0 8/1/18
ADDITIONAL #4
13258
4/10/19
GENERAL REVISION
INITIAL
NO. DATE
0 8/1/18
ADDITIONAL #5
13258
4/10/19
GENERAL REVISION
INITIAL
NO. DATE
0 8/1/18
ADDITIONAL #6
13258
4/10/19
GENERAL REVISION
INITIAL
NO. DATE
0 8/1/18
ADDITIONAL #7
13258
4/10/19
GENERAL REVISION
INITIAL
NO. DATE
0 8/1/18
ADDITIONAL #8
13258
4/10/19
GENERAL REVISION
INITIAL
NO. DATE
0 8/1/18
ADDITIONAL #9
13258
4/10/19
GENERAL REVISION
INITIAL
NO. DATE
0 8/1/18
ADDITIONAL #10
13258
4/10/19
GENERAL REVISION
INITIAL
NO. DATE
0 8/1/18
ADDITIONAL #11
13258
4/10/19
GENERAL REVISION
13258
4/10/19
GENERAL REVISION
INITIAL
NO. DATE
0 8/1/18
ADDITIONAL #46
13258
4/10/19
GENERAL REVISION
INITIAL
NO. DATE
0 8/1/18
ADDITIONAL #47
13258
4/10/19
GENERAL REVISION
INITIAL
NO. DATE
0 8/1/18
ADDITIONAL #48
13258
4/10/19
GENERAL REVISION
INITIAL
NO. DATE
0 8/1/18
ADDITIONAL #49
13258
4/10/19
GENERAL REVISION
INITIAL
NO. DATE
0 8/1/18
ADDITIONAL #50
13258
4/10/19
GENERAL REVISION
INITIAL
NO. DATE
0 8/1/18
ADDITIONAL #51
13258
4/10/19
GENERAL REVISION
INITIAL
NO. DATE
0 8/1/18
ADDITIONAL #52
13258
4/10/19
GENERAL REVISION
INITIAL
NO. DATE
0 8/1/18
ADDITIONAL #53<br

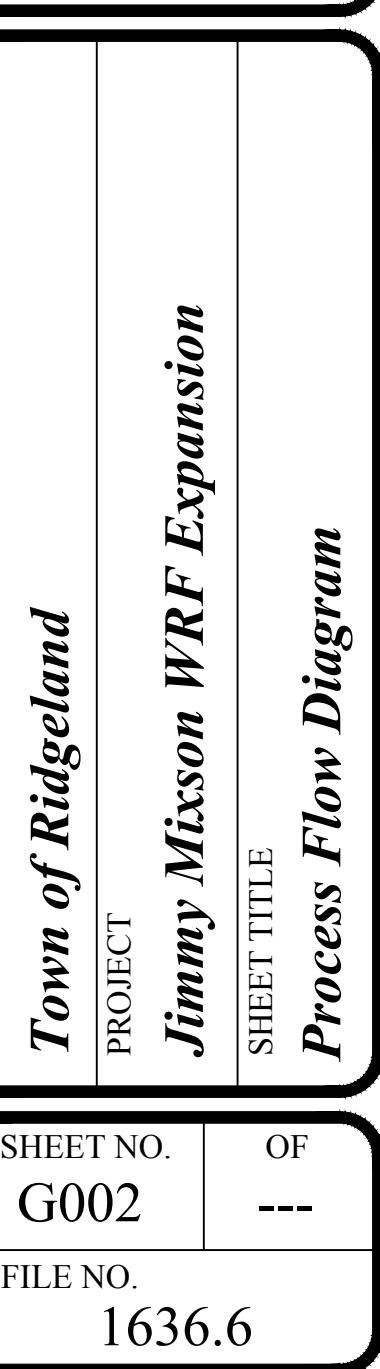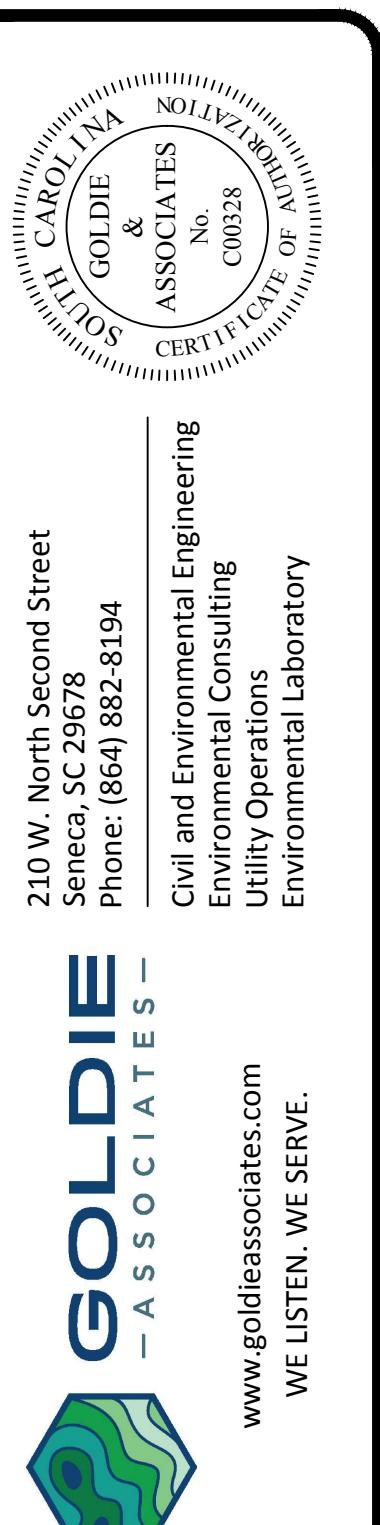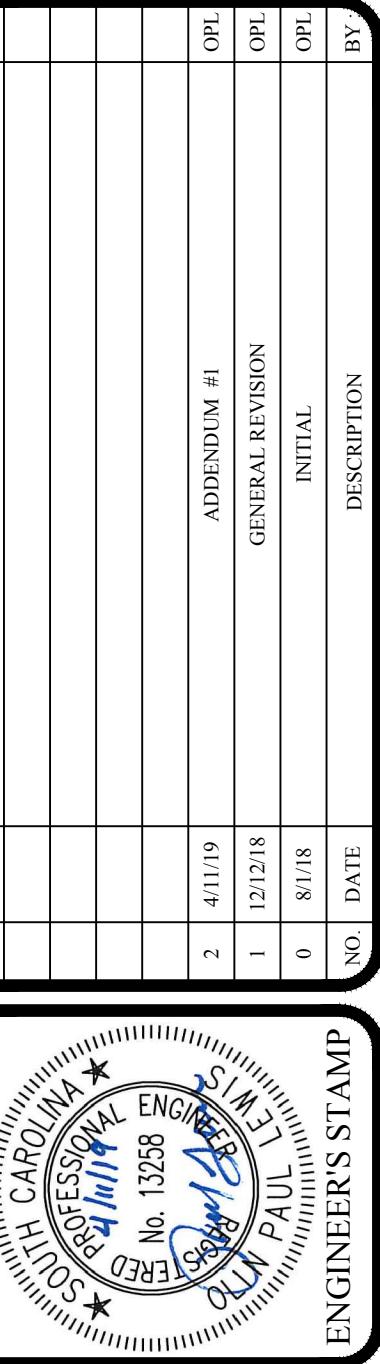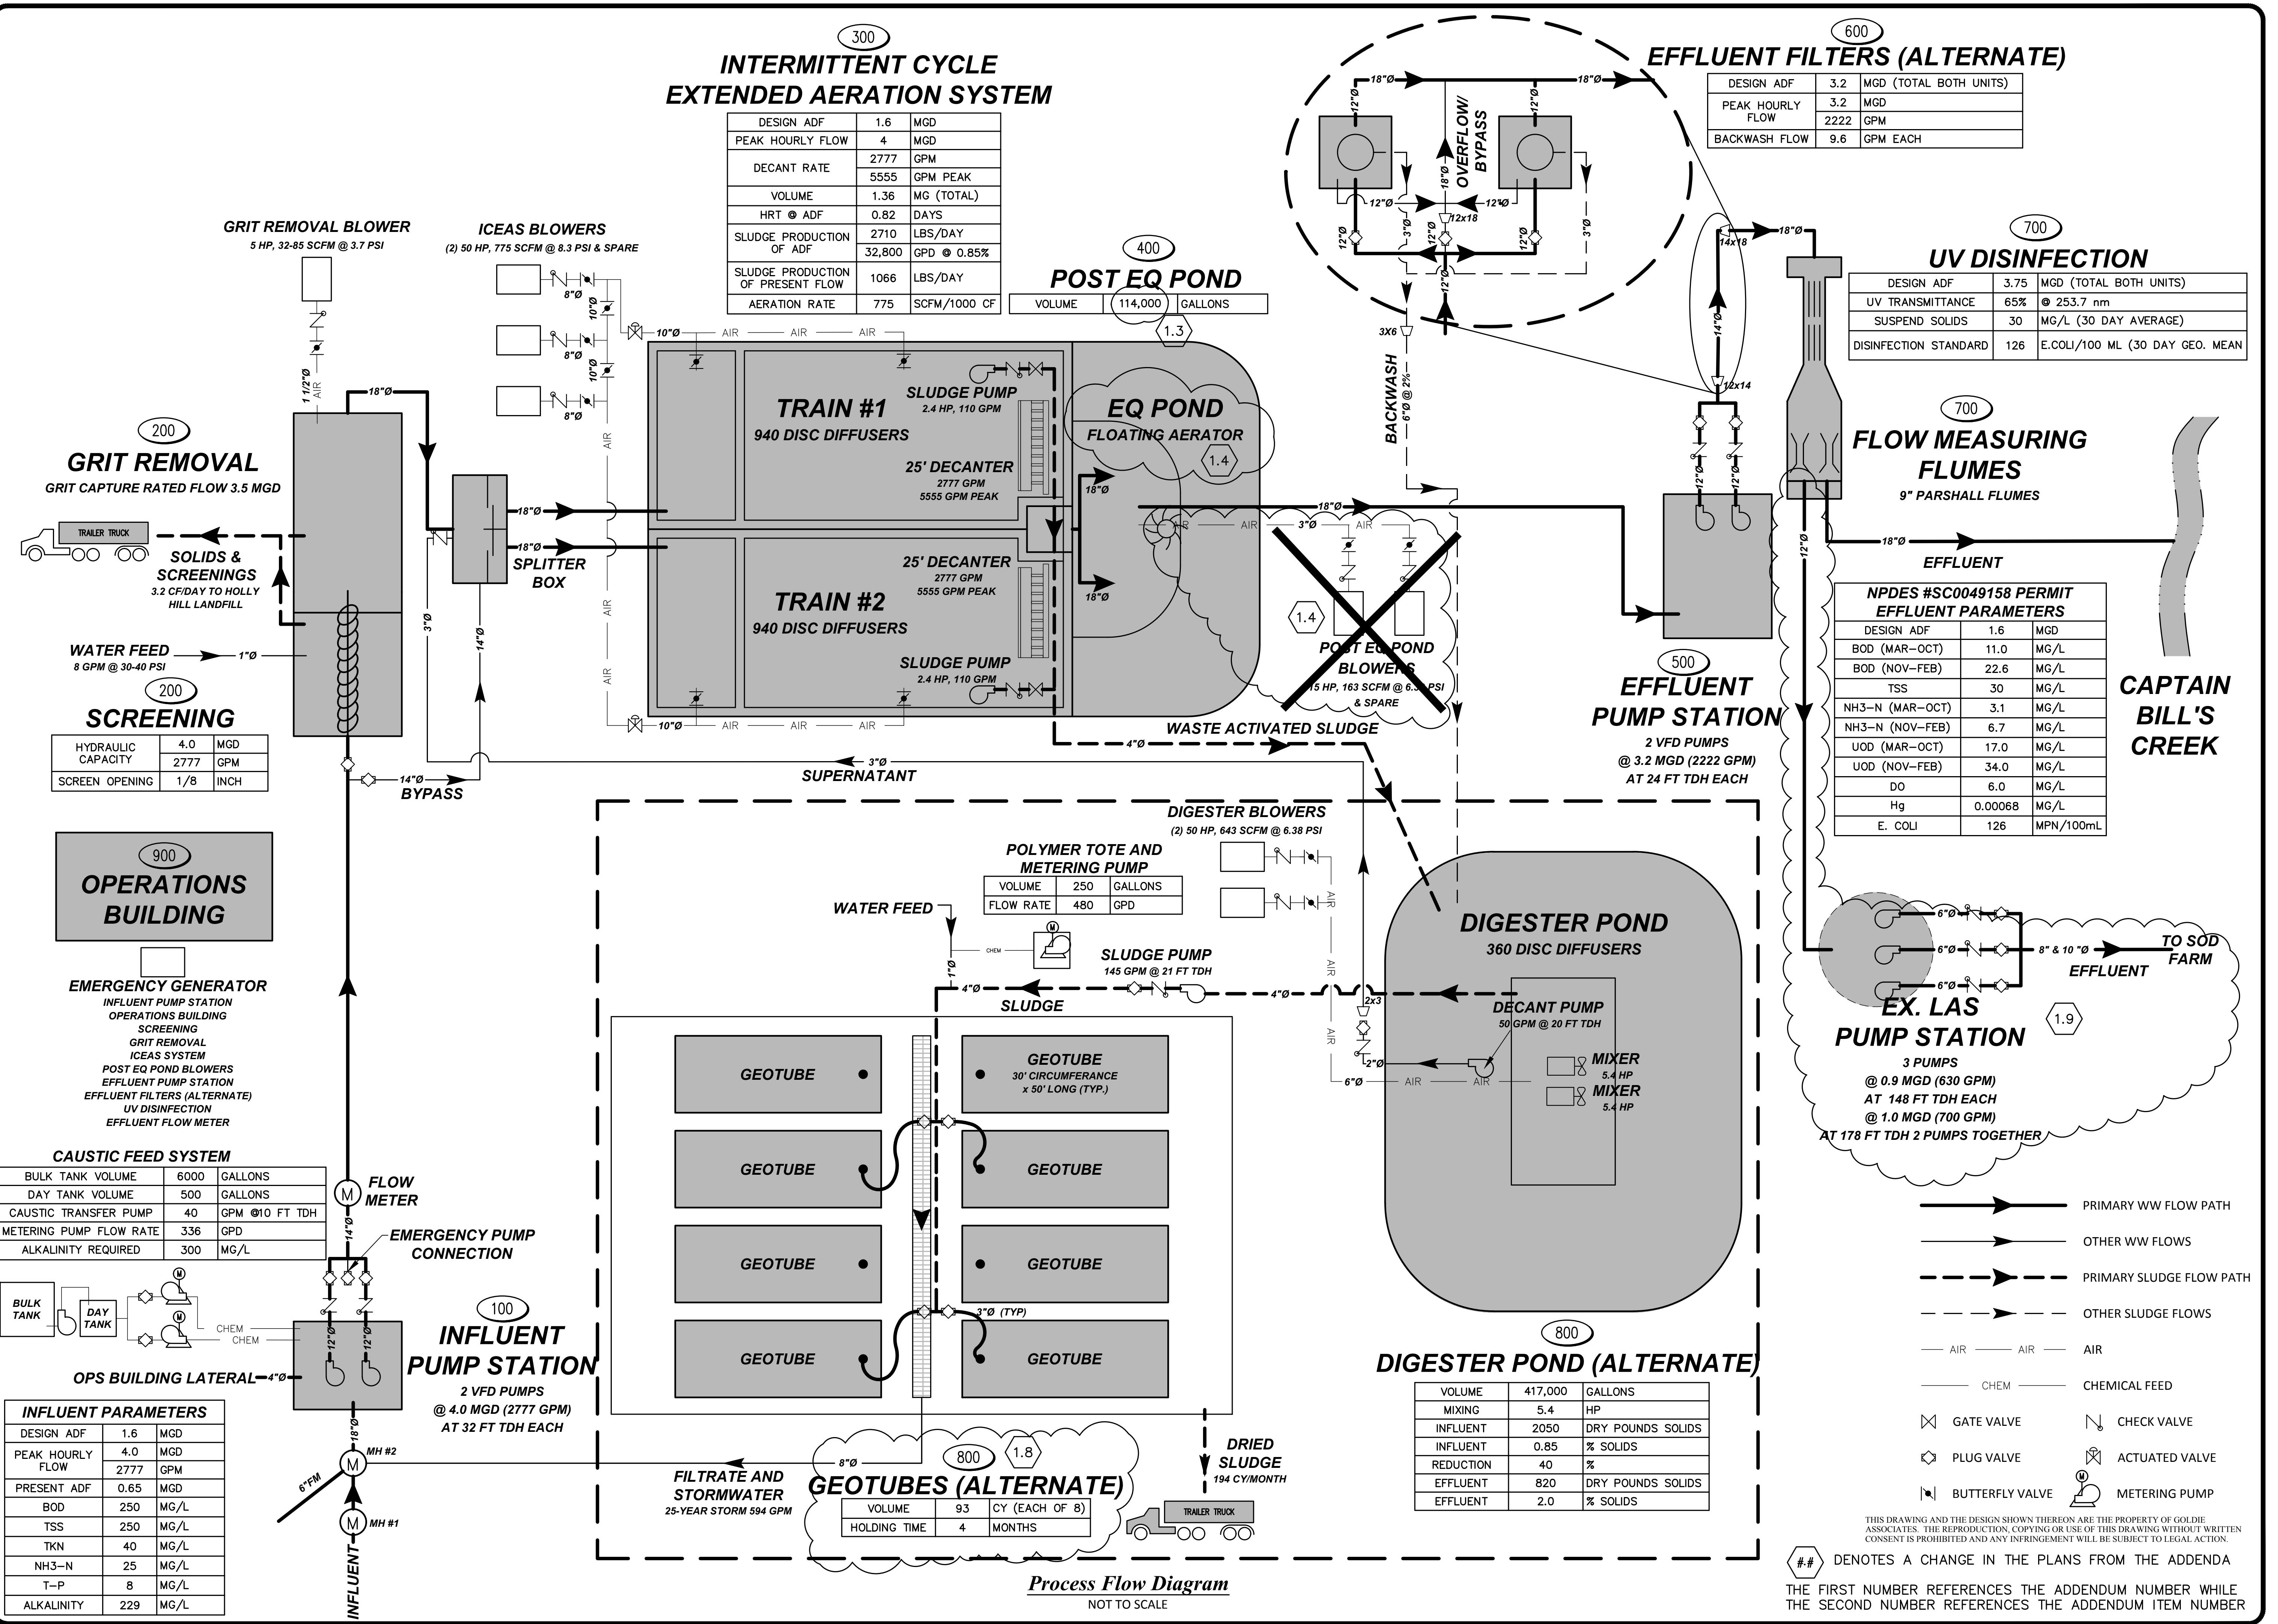

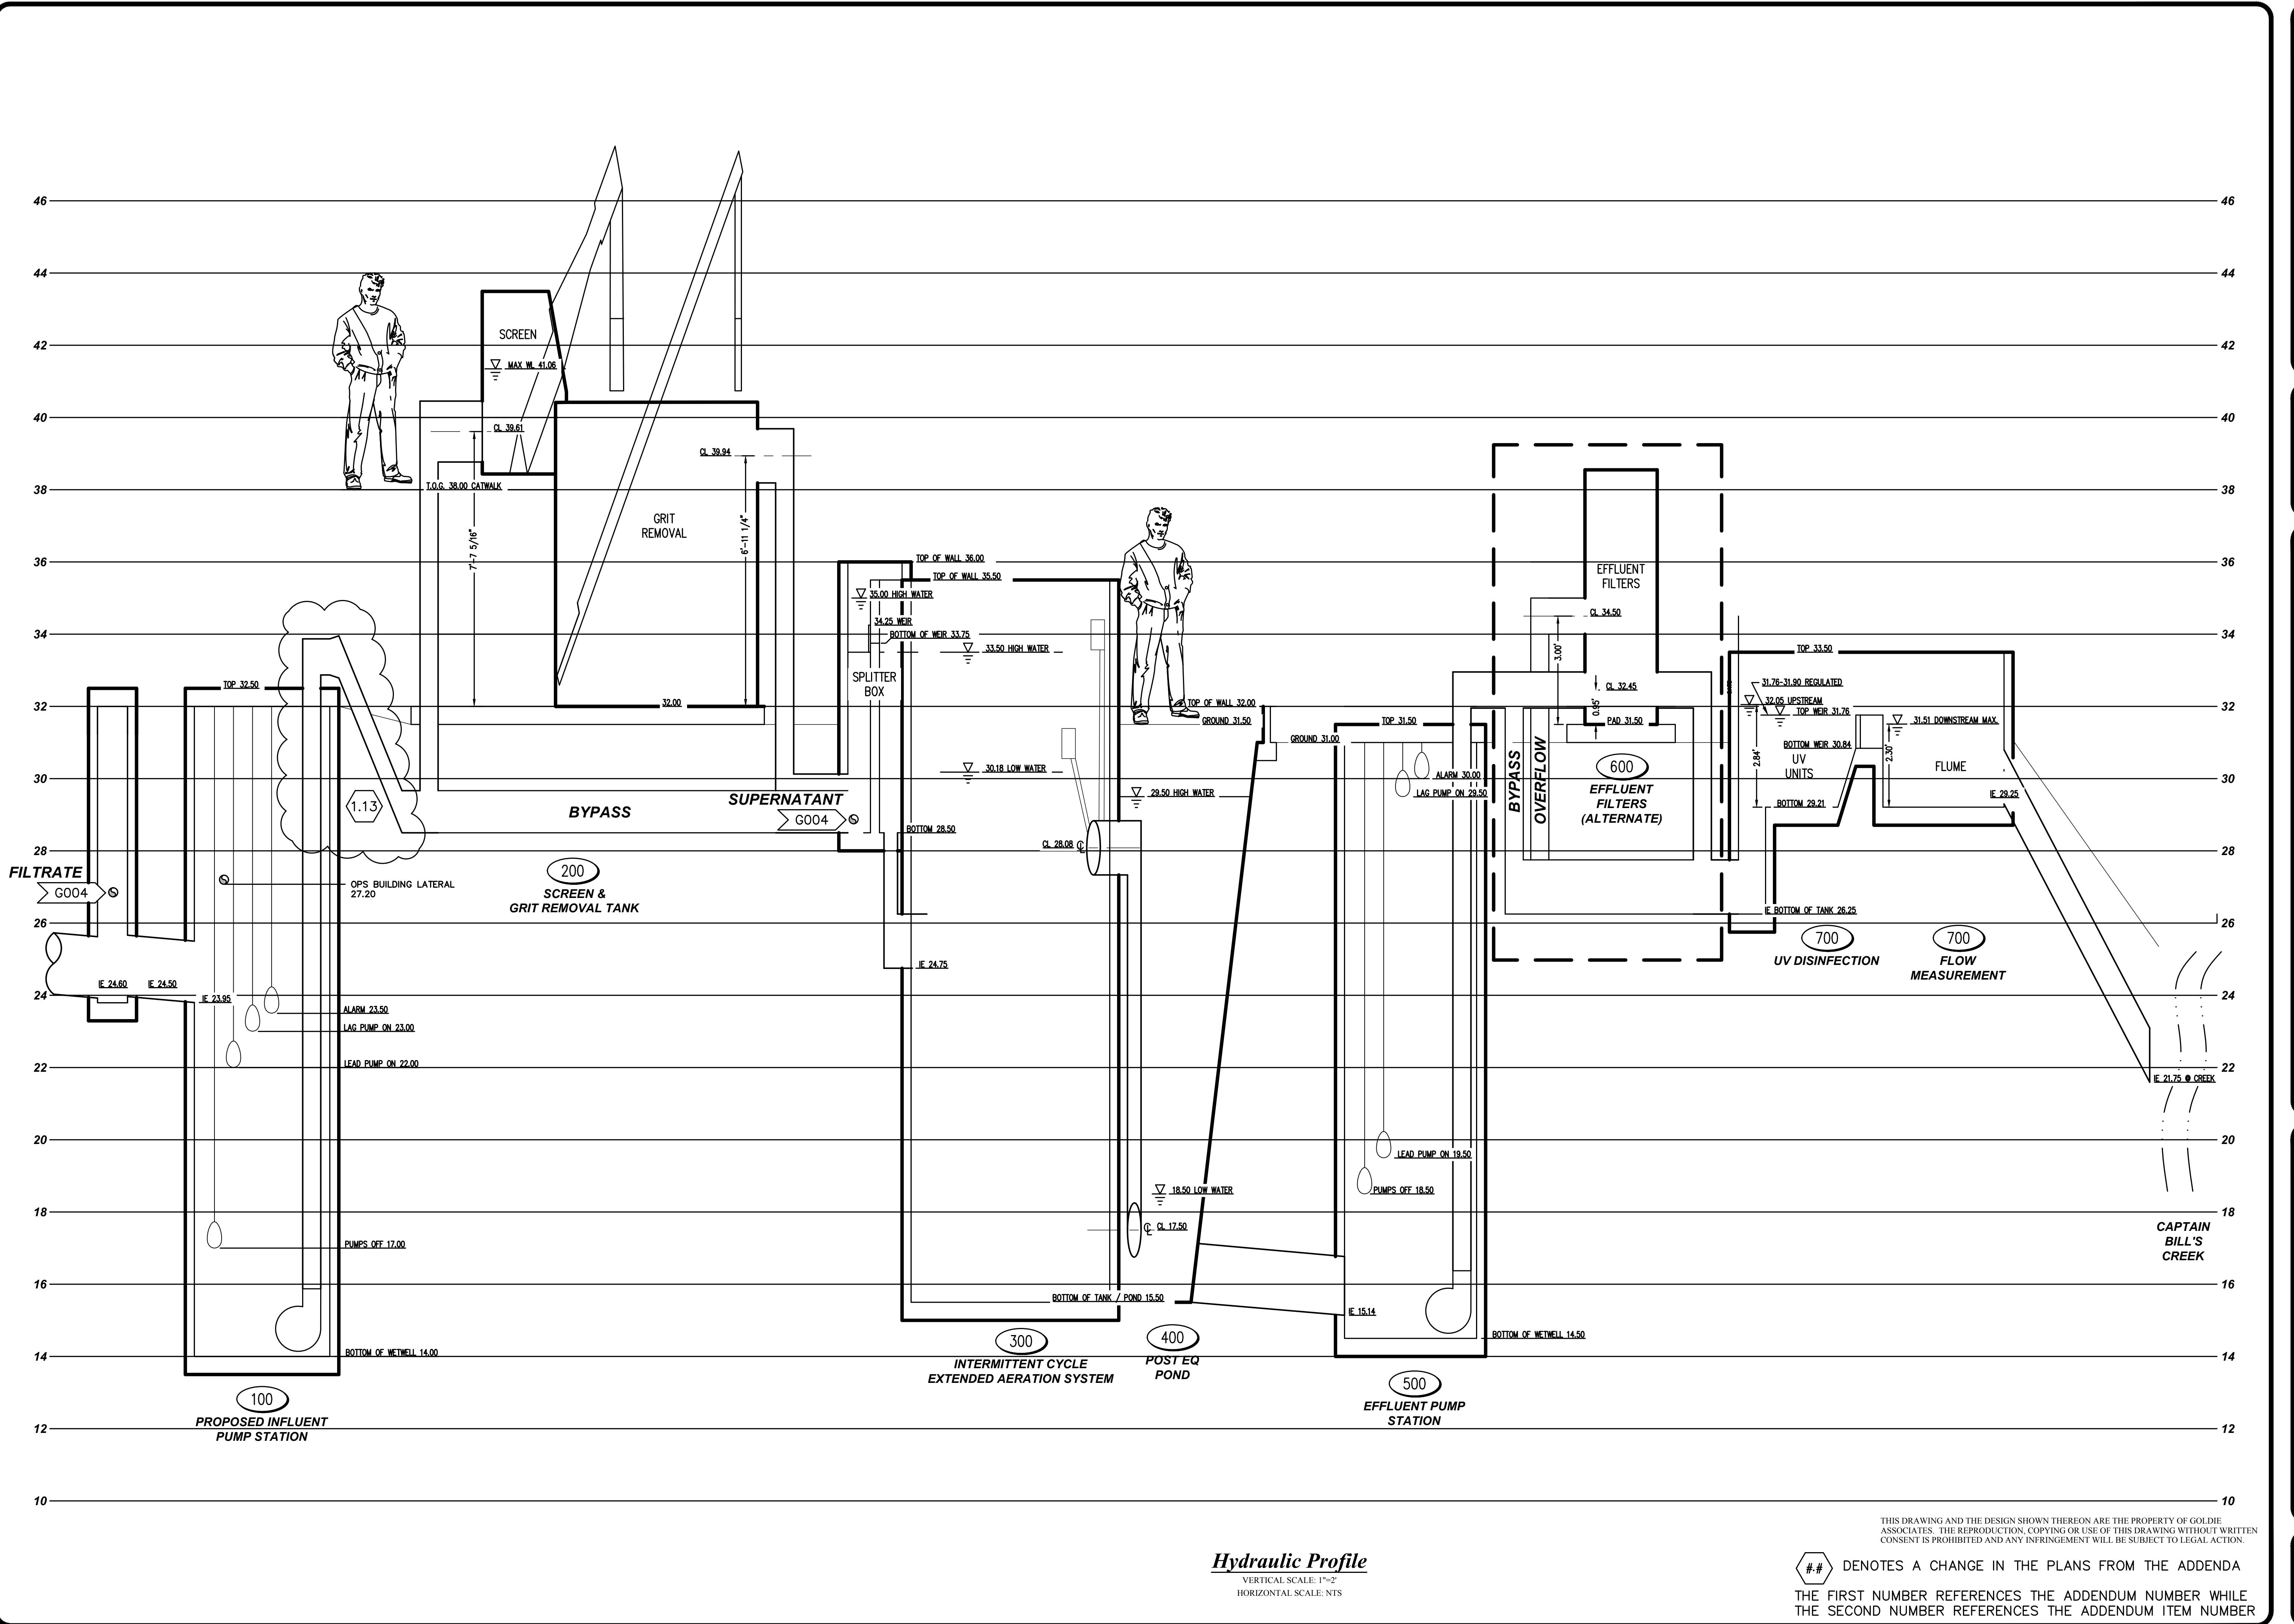


CLIENT	TOWN OF RIDGELAND	PROJECT	JIMMY MIXSON WRF EXPANSION
SHEET TITLE	WASTEWATER HYDRAULIC PROFILE		
FILE NO.	G003	OF	--
FILE DATE	1636.6		
ADDITIONAL #	2	GENERAL REVISION	0
OPN.	4/10/19	INITIAL	0
OPN.	12/2/18	DATE	8/1/18
OPN.	13258	NO.	BY
DESCRIPTION			

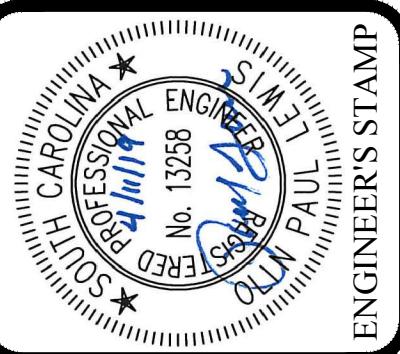

CLIENT	TOWN OF RIDGELAND	PROJECT	JIMMY MIXSON WRF EXPANSION
SHEET TITLE	WASTEWATER HYDRAULIC PROFILE		
FILE NO.	G003	OF	--
FILE DATE	1636.6		

Wastewater Hydraulic Profile

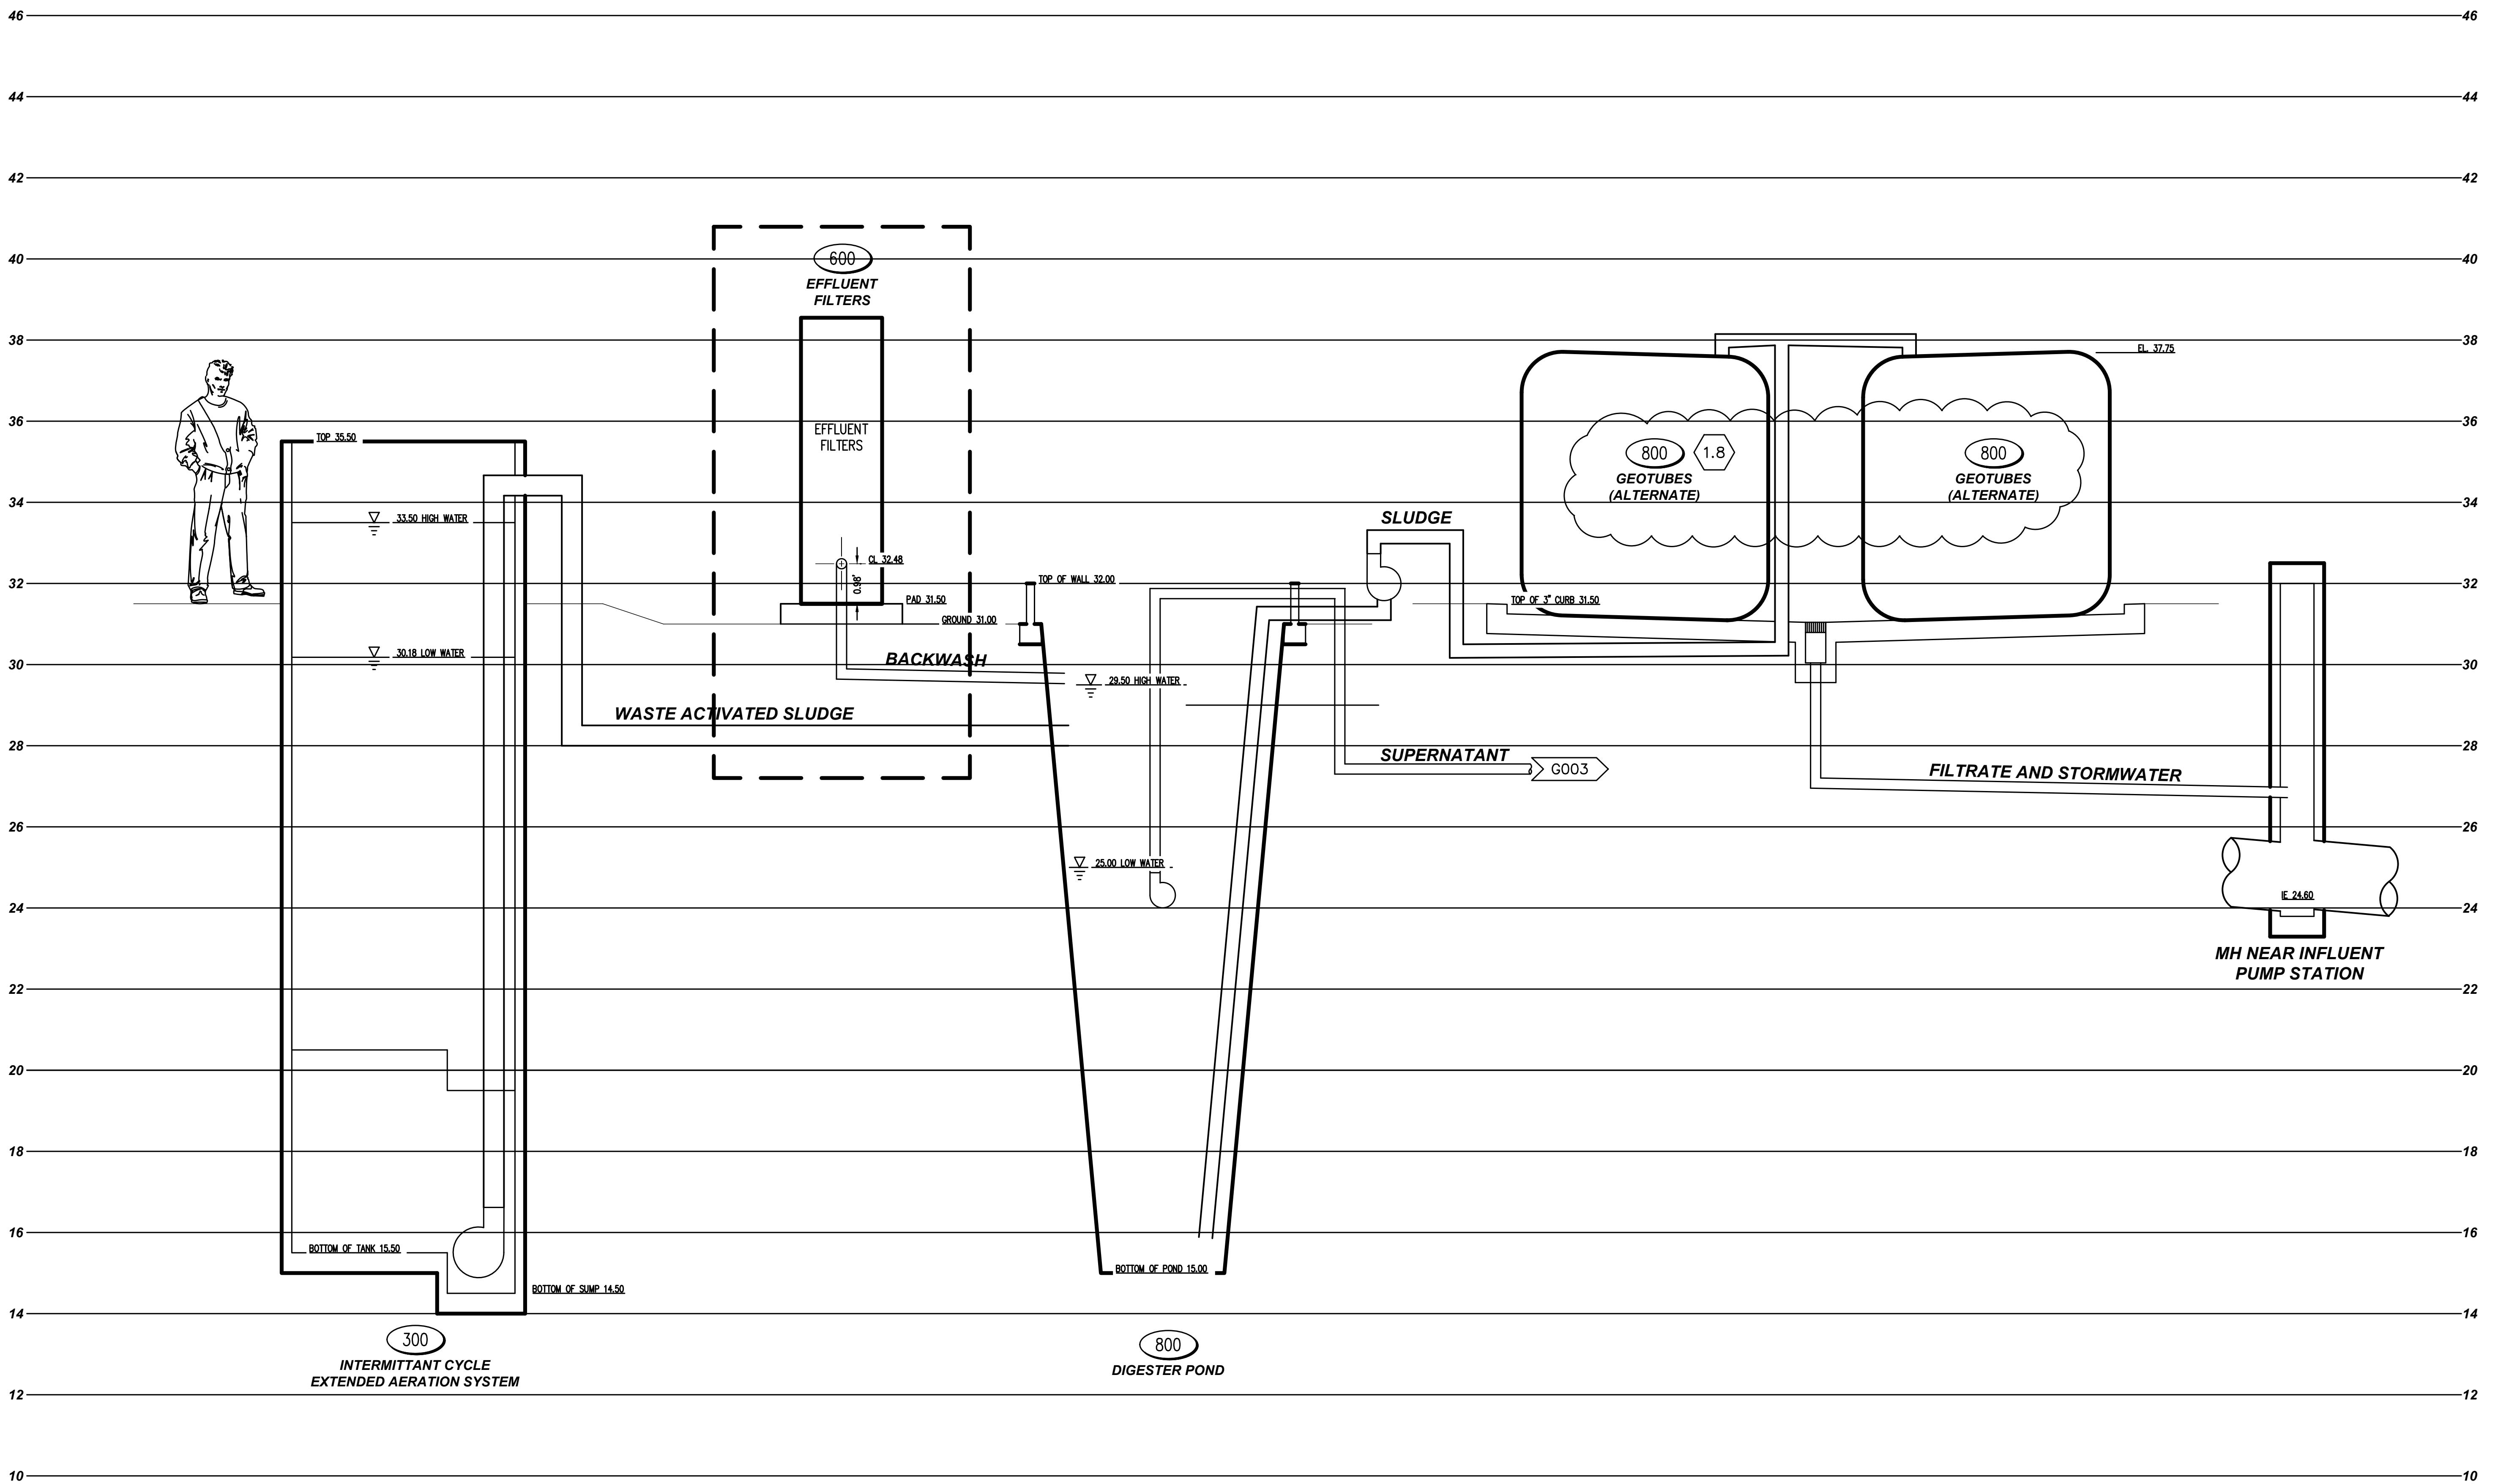

Sludge Hydraulic Profile

VERTICAL SCALE: 1"=2'
HORIZONTAL SCALE: NTS

THIS DRAWING AND THE DESIGN SHOWN THEREON ARE THE PROPERTY OF GOLDIE ASSOCIATES. THE REPRODUCTION, COPYING OR USE OF THIS DRAWING WITHOUT WRITTEN CONSENT IS PROHIBITED AND ANY INFRINGEMENT WILL BE SUBJECT TO LEGAL ACTION.

denotes a change in the plans from the addenda
THE FIRST NUMBER REFERENCES THE ADDENDUM NUMBER WHILE
THE SECOND NUMBER REFERENCES THE ADDENDUM ITEM NUMBER




SHEET NO.
G004
OF
--
FILE NO.
1636.6

CLIENT
Town of Ridgeland
PROJECT
Jimmy Mixson WRF Expansion
SHEET TITLE
Sludge Hydraulic Profile

210 W. North Second Street
Seneca, SC 29678
Phone: (864) 882-8194
Civil and Environmental Engineering
Utility Operations
Environmental Laboratory

GOLDIE
— A S S O C I A T E S —
www.goldieassociates.com
WE LISTEN. WE SERVE.

1	4/10/19	ADDITIONAL	OPN
1	12/2/18	GENERAL REVISION	OPN
0	8/1/18	INITIAL	OPN
		DESCRIPTION	BY

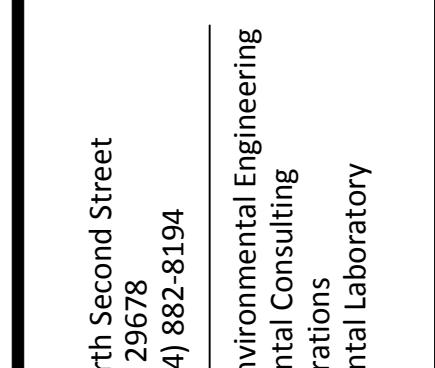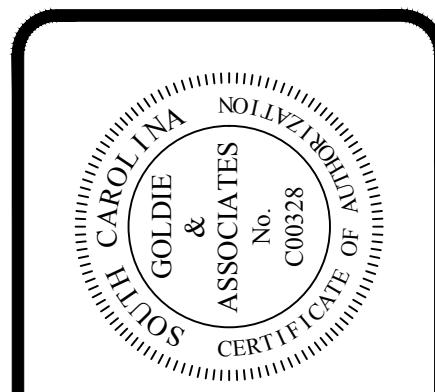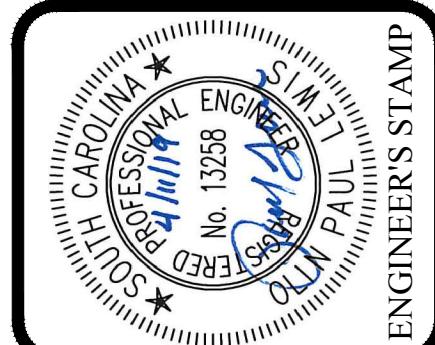

Phase 1



Install Perimeter Controls, Create Construction Laydown Area, and Install Temporary Pump and DAF Unit

PHASE 1 TREATMENT PROCESS

- 1 EXISTING INFLUENT PUMP STATION
- 2 STATIC BAR SCREENS
- 3 INFLUENT FLUME
- 4 SOUTH LAGOON
- 5 NORTH LAGOON
- 6 CHLORINE CONTACT CHAMBER
- 7 EXISTING EFFLUENT PUMP STATION

PHASE 1 CONSTRUCTION SEQUENCE

- A PERIMETER CONTROLS - SEE SHEET ESC001
- B CONSTRUCTION OFFICE
- REMOVE SLUDGE FROM SOUTH LAGOON, RETURN WATER TO LAGOON. SLUDGE TO LANDFILL
- C TEMP. PLACEMENT OF DAF (IF REQUIRED)
- D TEMP. PLACEMENT OF LAGOON PUMP (IF REQUIRED)
- E REMOVE SLUDGE FROM NORTH LAGOON, RETURN WATER TO SOUTH LAGOON. SLUDGE TO LANDFILL.
- F PREP. CONSTRUCTION LAYDOWN AREA (AT CORNER OF GETSINGER STREET AND PREACHER ROAD)

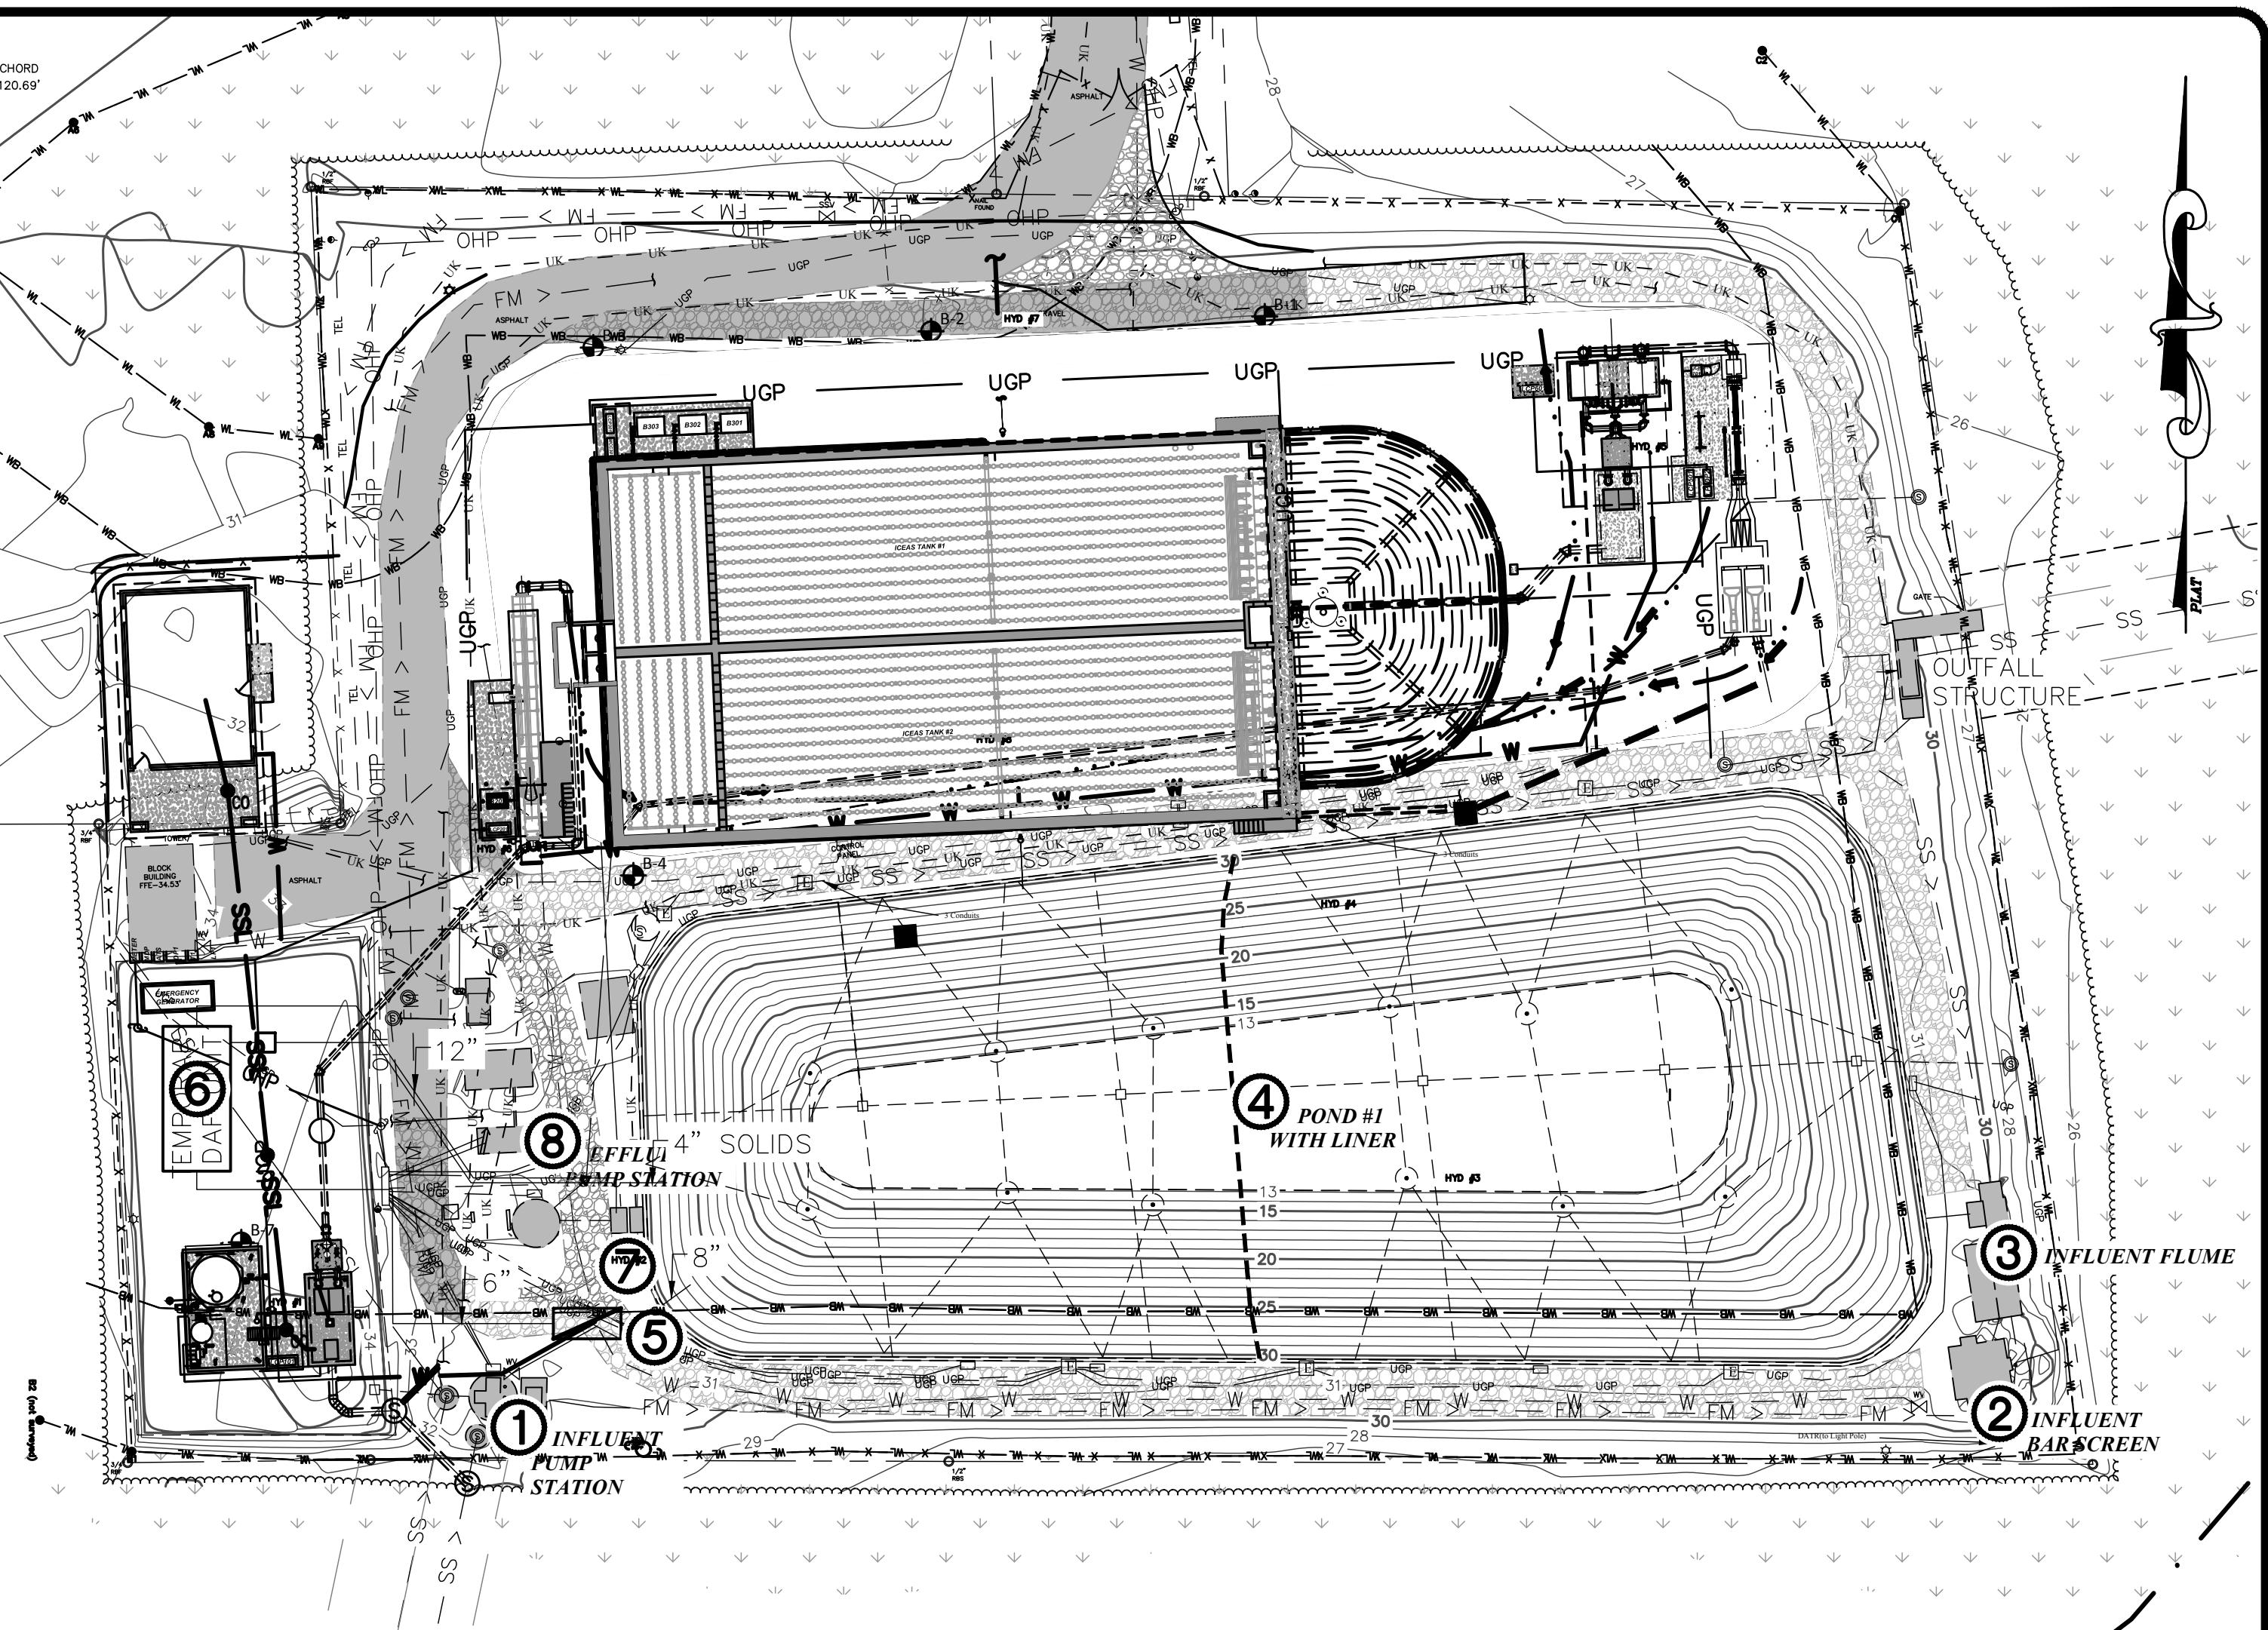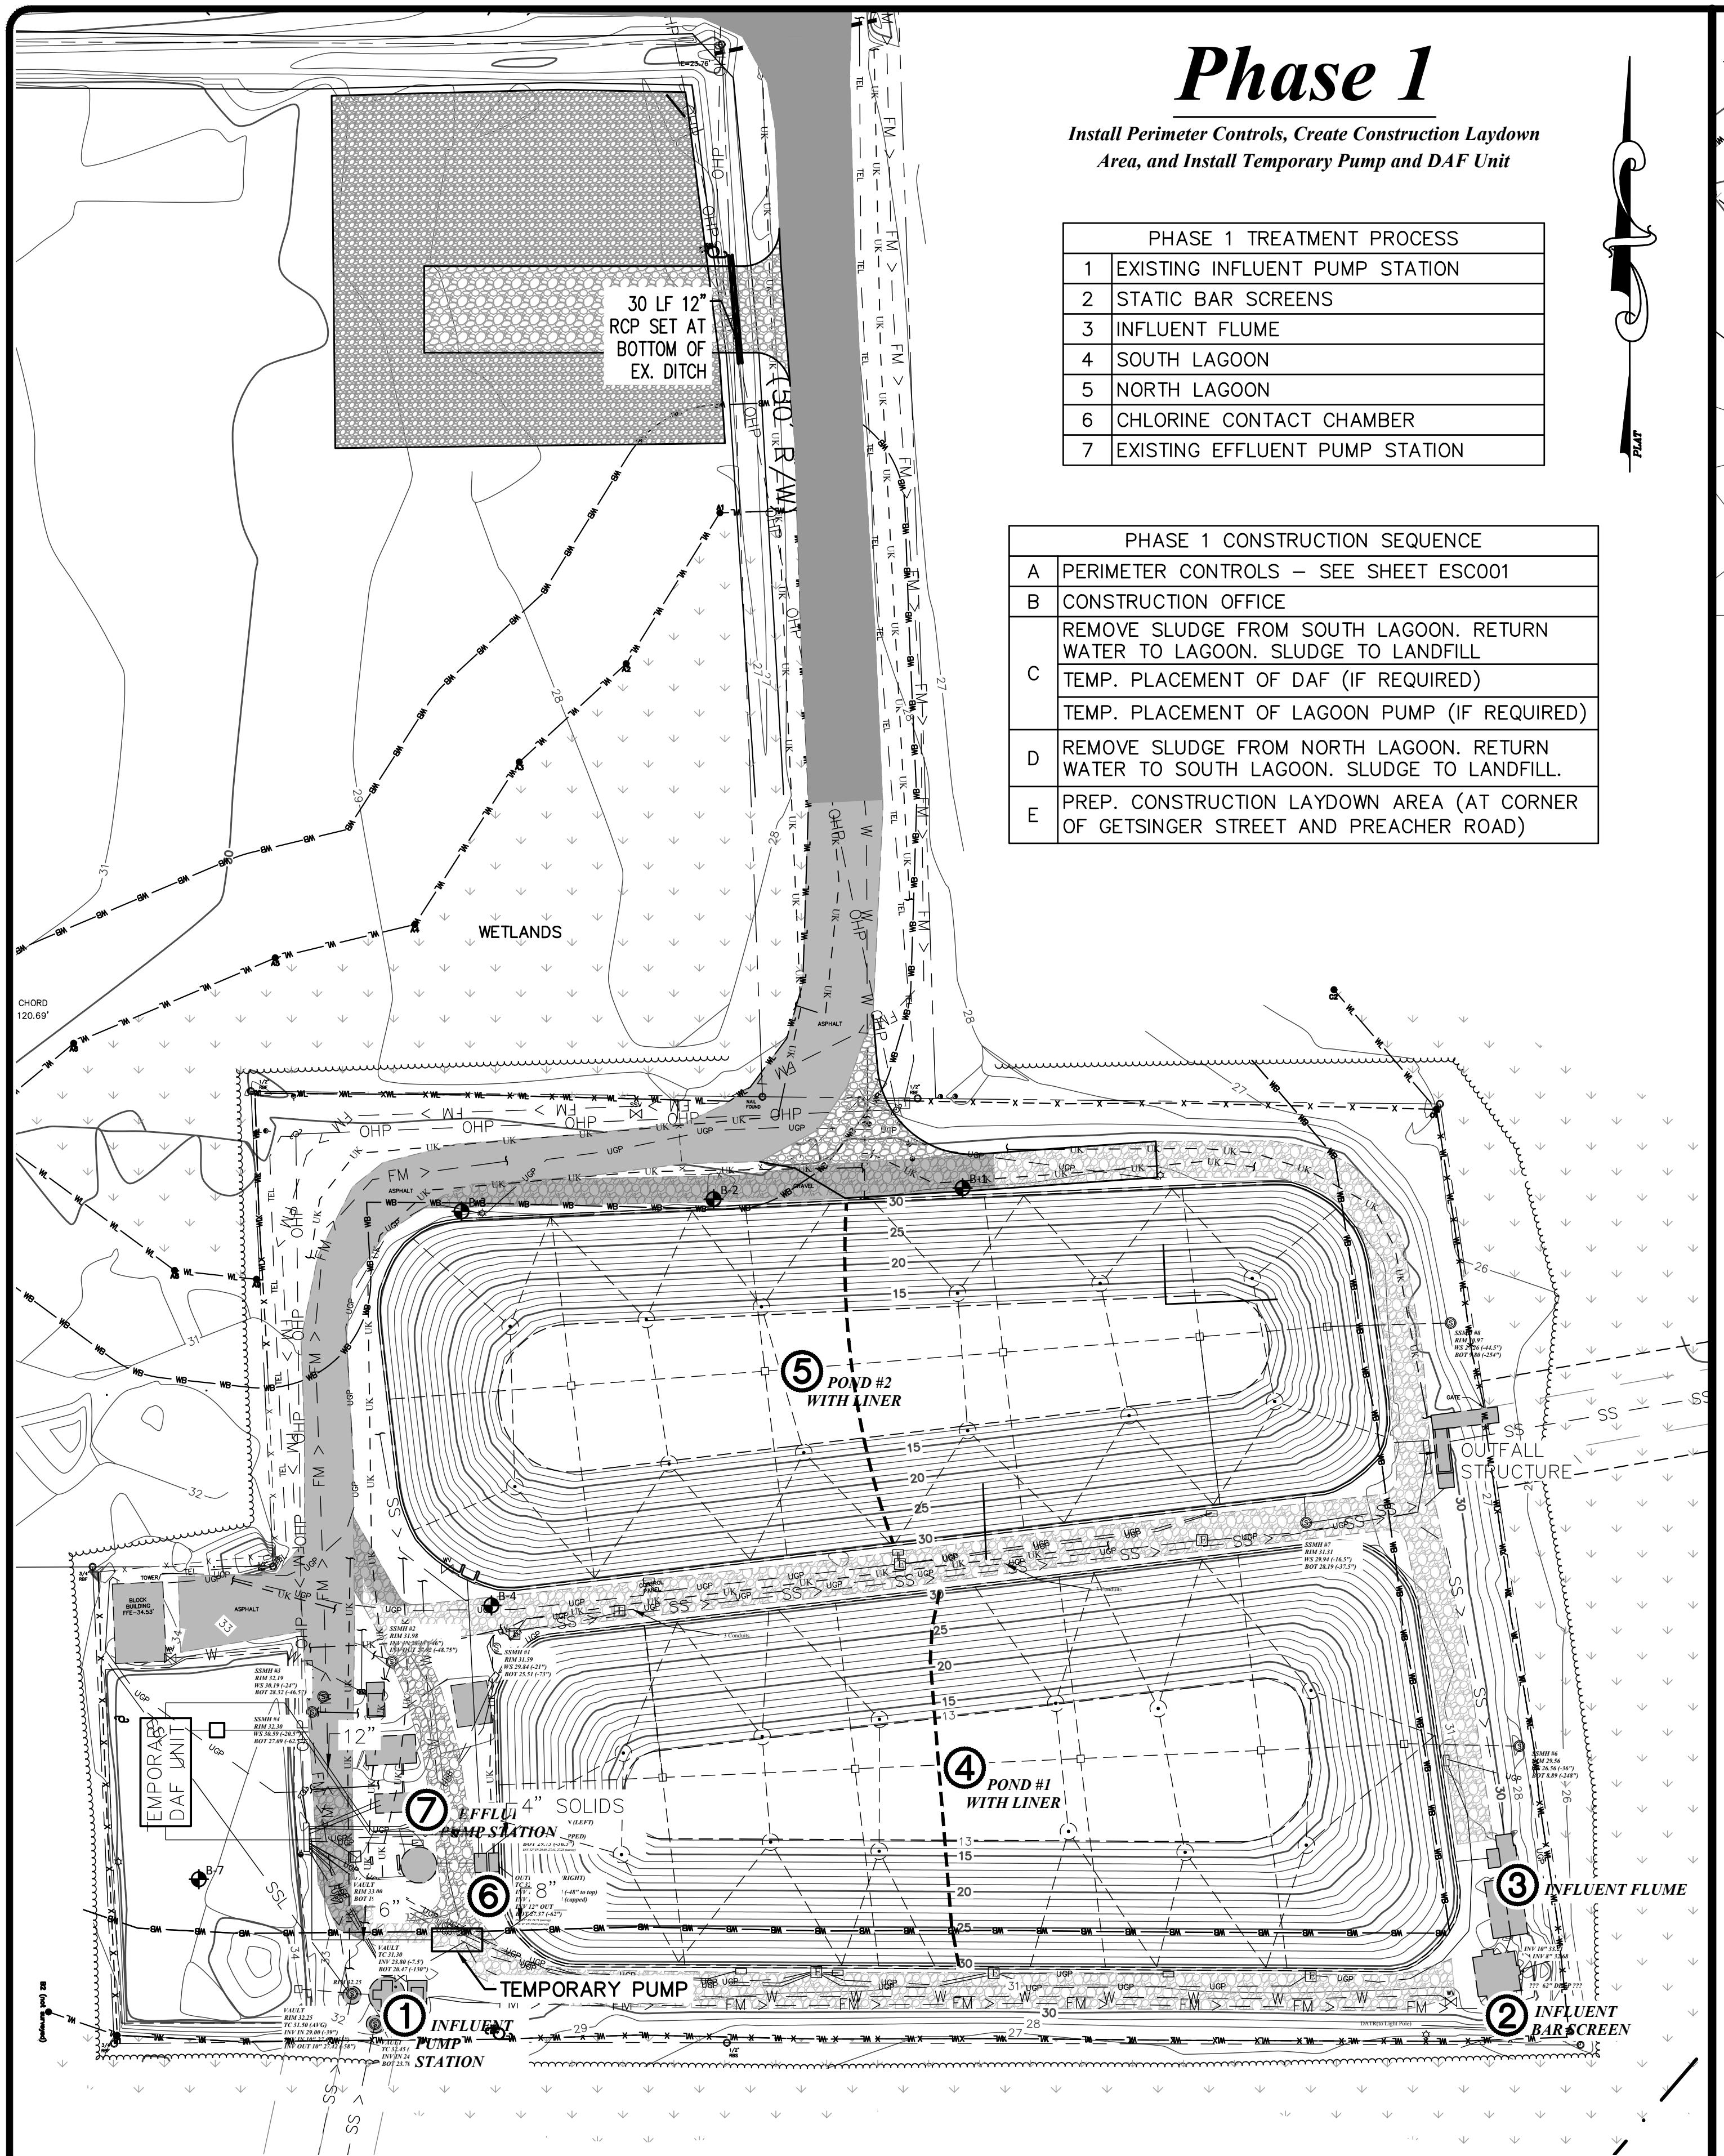

Phase 2

Flow to Temporary Pump and DAF Unit With Existing North Lagoon Off-line


PHASE 2 TREATMENT PROCESS

- 1 EXISTING INFLUENT PUMP STATION
- 2 STATIC BAR SCREENS
- 3 INFLUENT FLUME
- 4 SOUTH LAGOON
- 5 LAGOON PUMP (IF REQUIRED)
- 6 DAF (IF REQUIRED)
- 7 CHLORINE CONTACT CHAMBER
- 8 EXISTING EFFLUENT PUMP STATION

PHASE 2 CONSTRUCTION SEQUENCE

- A DIVERT FLOW FROM SOUTH LAGOON TO EFFLUENT PUMP STATION. STARTUP DAF / PUMP SYSTEM (IF REQUIRED)
- B REMOVE NORTH LAGOON LINER. REMOVE OUTFALL STRUCTURE. ICEAS #1 CONSTRUCTION. DRS BUILDING. GRADE DOWN PROPOSED INFLUENT AREA. 1.2
- C EQ POND. FILL AND GRADE AROUND ICEAS #1. INFLUENT PUMP STATION. ALKALINITY ADDITION FACILITY. OPS BUILDING. HEADWORKS. UNIT SLAB. COMBO UNIT INSTALL. SCREEN BYPASS. SPLITTER BOX. ICEAS BLOWERS. PUMP STATION. FILTERS (IF APPLICABLE). JV. POST EQ AERATORS. 1.4. SPLITTER BOX. PARSHALL FLUMES. LAS PUMP STATION PIPING. CREEK OUTFALL PIPING. INSTALL NEW GENERATOR. E PIPING FROM INFLUENT PS TO ICEAS TO JV'S TO CREEK. TEMPORARY SLUDGE HANDLING FOR ICEAS #1. 1.2

NOTE:
SLUDGE SEEDING APPROVED BY
MANUFACTURER


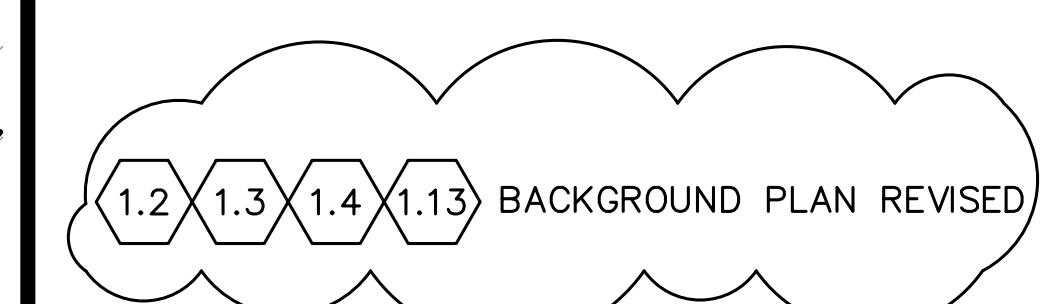


denotes a change in the plans from the addenda

The first number references the addendum number while
the second number references the addendum item number

THIS DRAWING AND THE DESIGN SHOWN THEREON
ARE THE PROPERTY OF GOLDI ENGINEERING.
REPRODUCTION, COPYING OR USE OF THIS DRAWING
WITHOUT WRITTEN CONSENT IS PROHIBITED AND ANY
INFRINGEMENT WILL BE SUBJECT TO LEGAL ACTION.

2	4/11/19	ADDITION #1
1	12/12/18	GENERAL REVISION
0	8/1/18	INITIAL
		DESCRIPTION

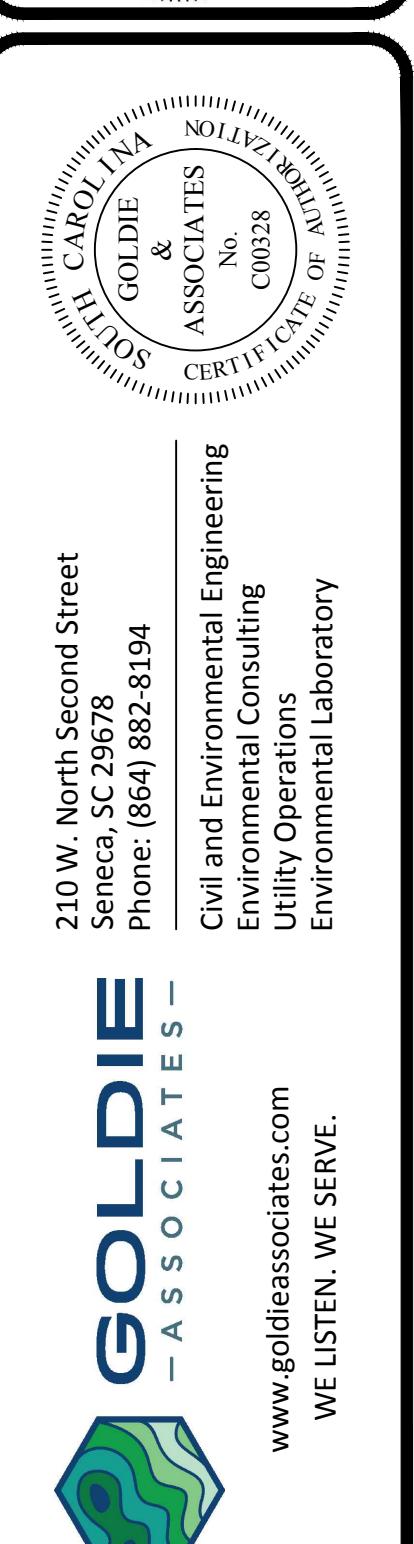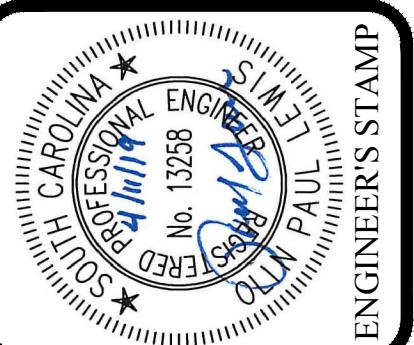


GOLDIE - ASSOCIATES -	210 W. North Second Street Seneca, SC 29678 Phone: (864) 882-8194
www.goldieassociates.com	Civil and Environmental Engineering Utility Operations Environmental Laboratory
WE LISTEN. WE SERVE.	

Town of Ridgeland
Jimmy Mixson WRF Expansion
PROJECT
SHEET TITLE
Project Phasing - Phases 1 & 2

SHEET NO.
G021
OF
FILE NO.
1636.6





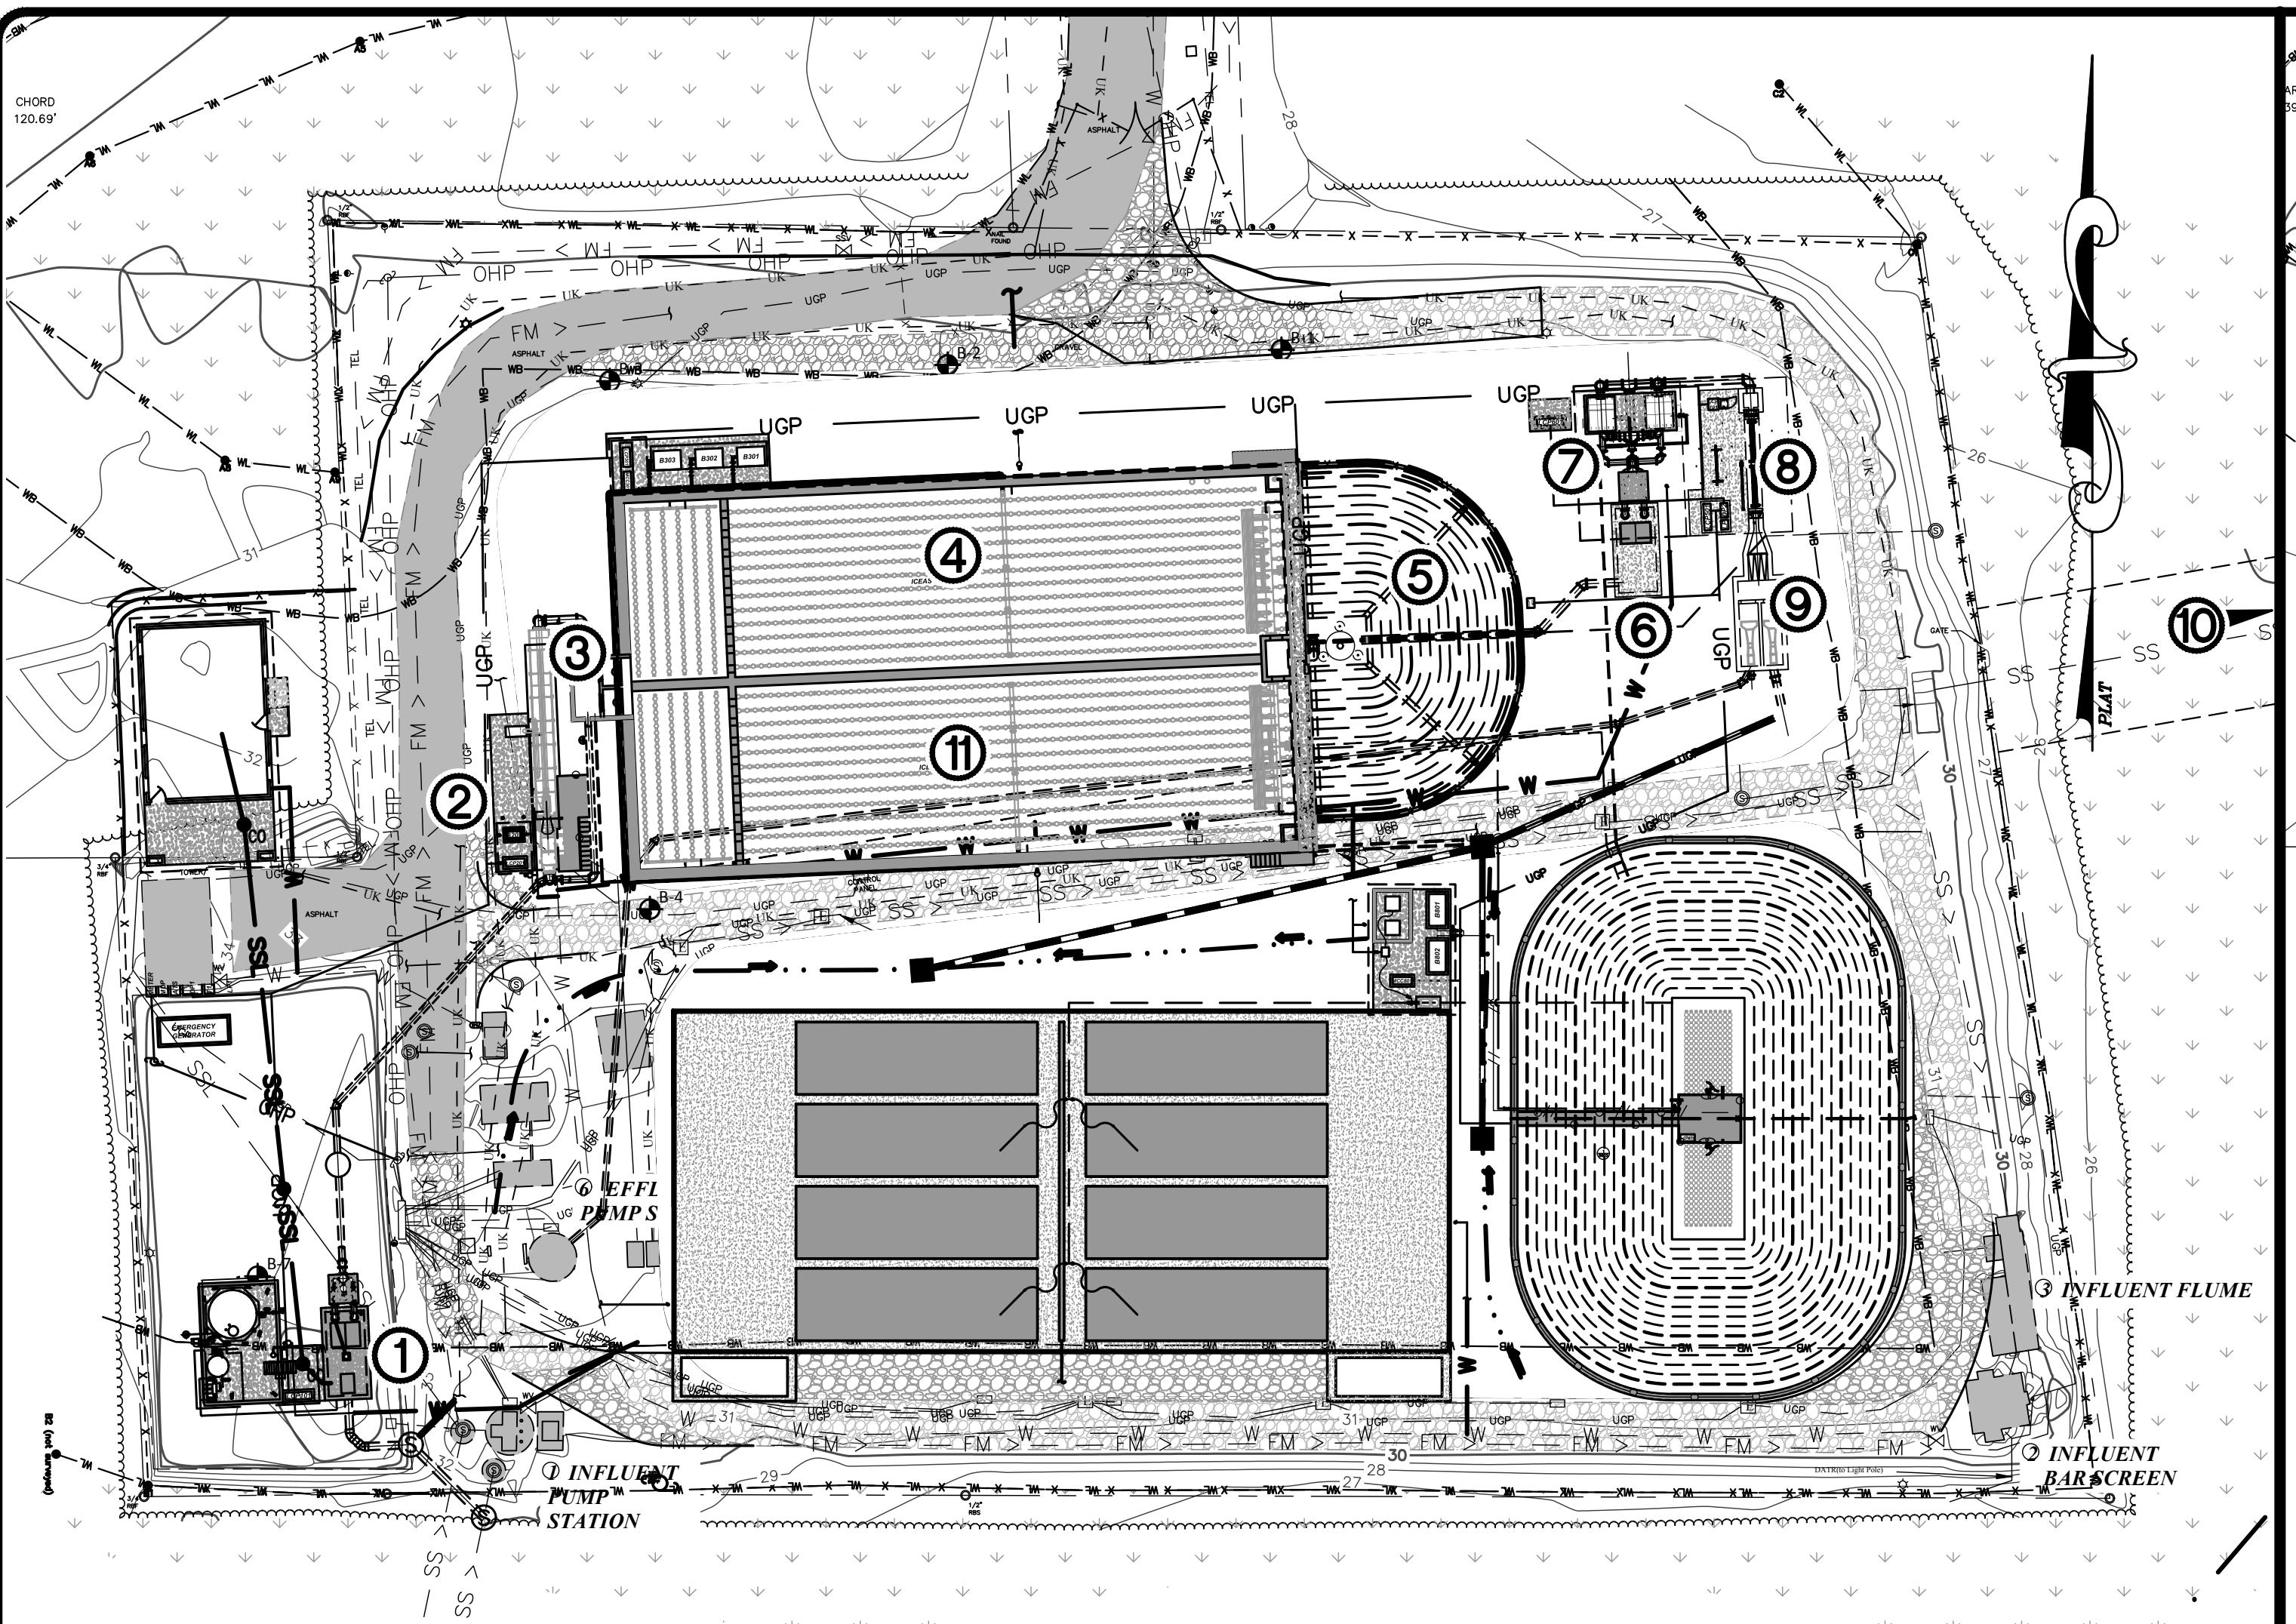

Phase 3

ICEAS On-line and Existing South Lagoon Off-line


PHASE 3 TREATMENT PROCESS	
1	PROPOSED INFLUENT PUMP STATION
2	HEADWORKS
3	SPLITTER BOX
4	ICEAS TANK #1
5	EQ POND
6	PROPOSED EFFLUENT PUMP STATION
7	EFFLUENT FILTERS (IF APPLICABLE)
8	UV
9	PARSHALL FLUME
10	CREEK OUTFALL
11	WASTED SLUDGE TO TEMPORARY STORAGE OR HAUL

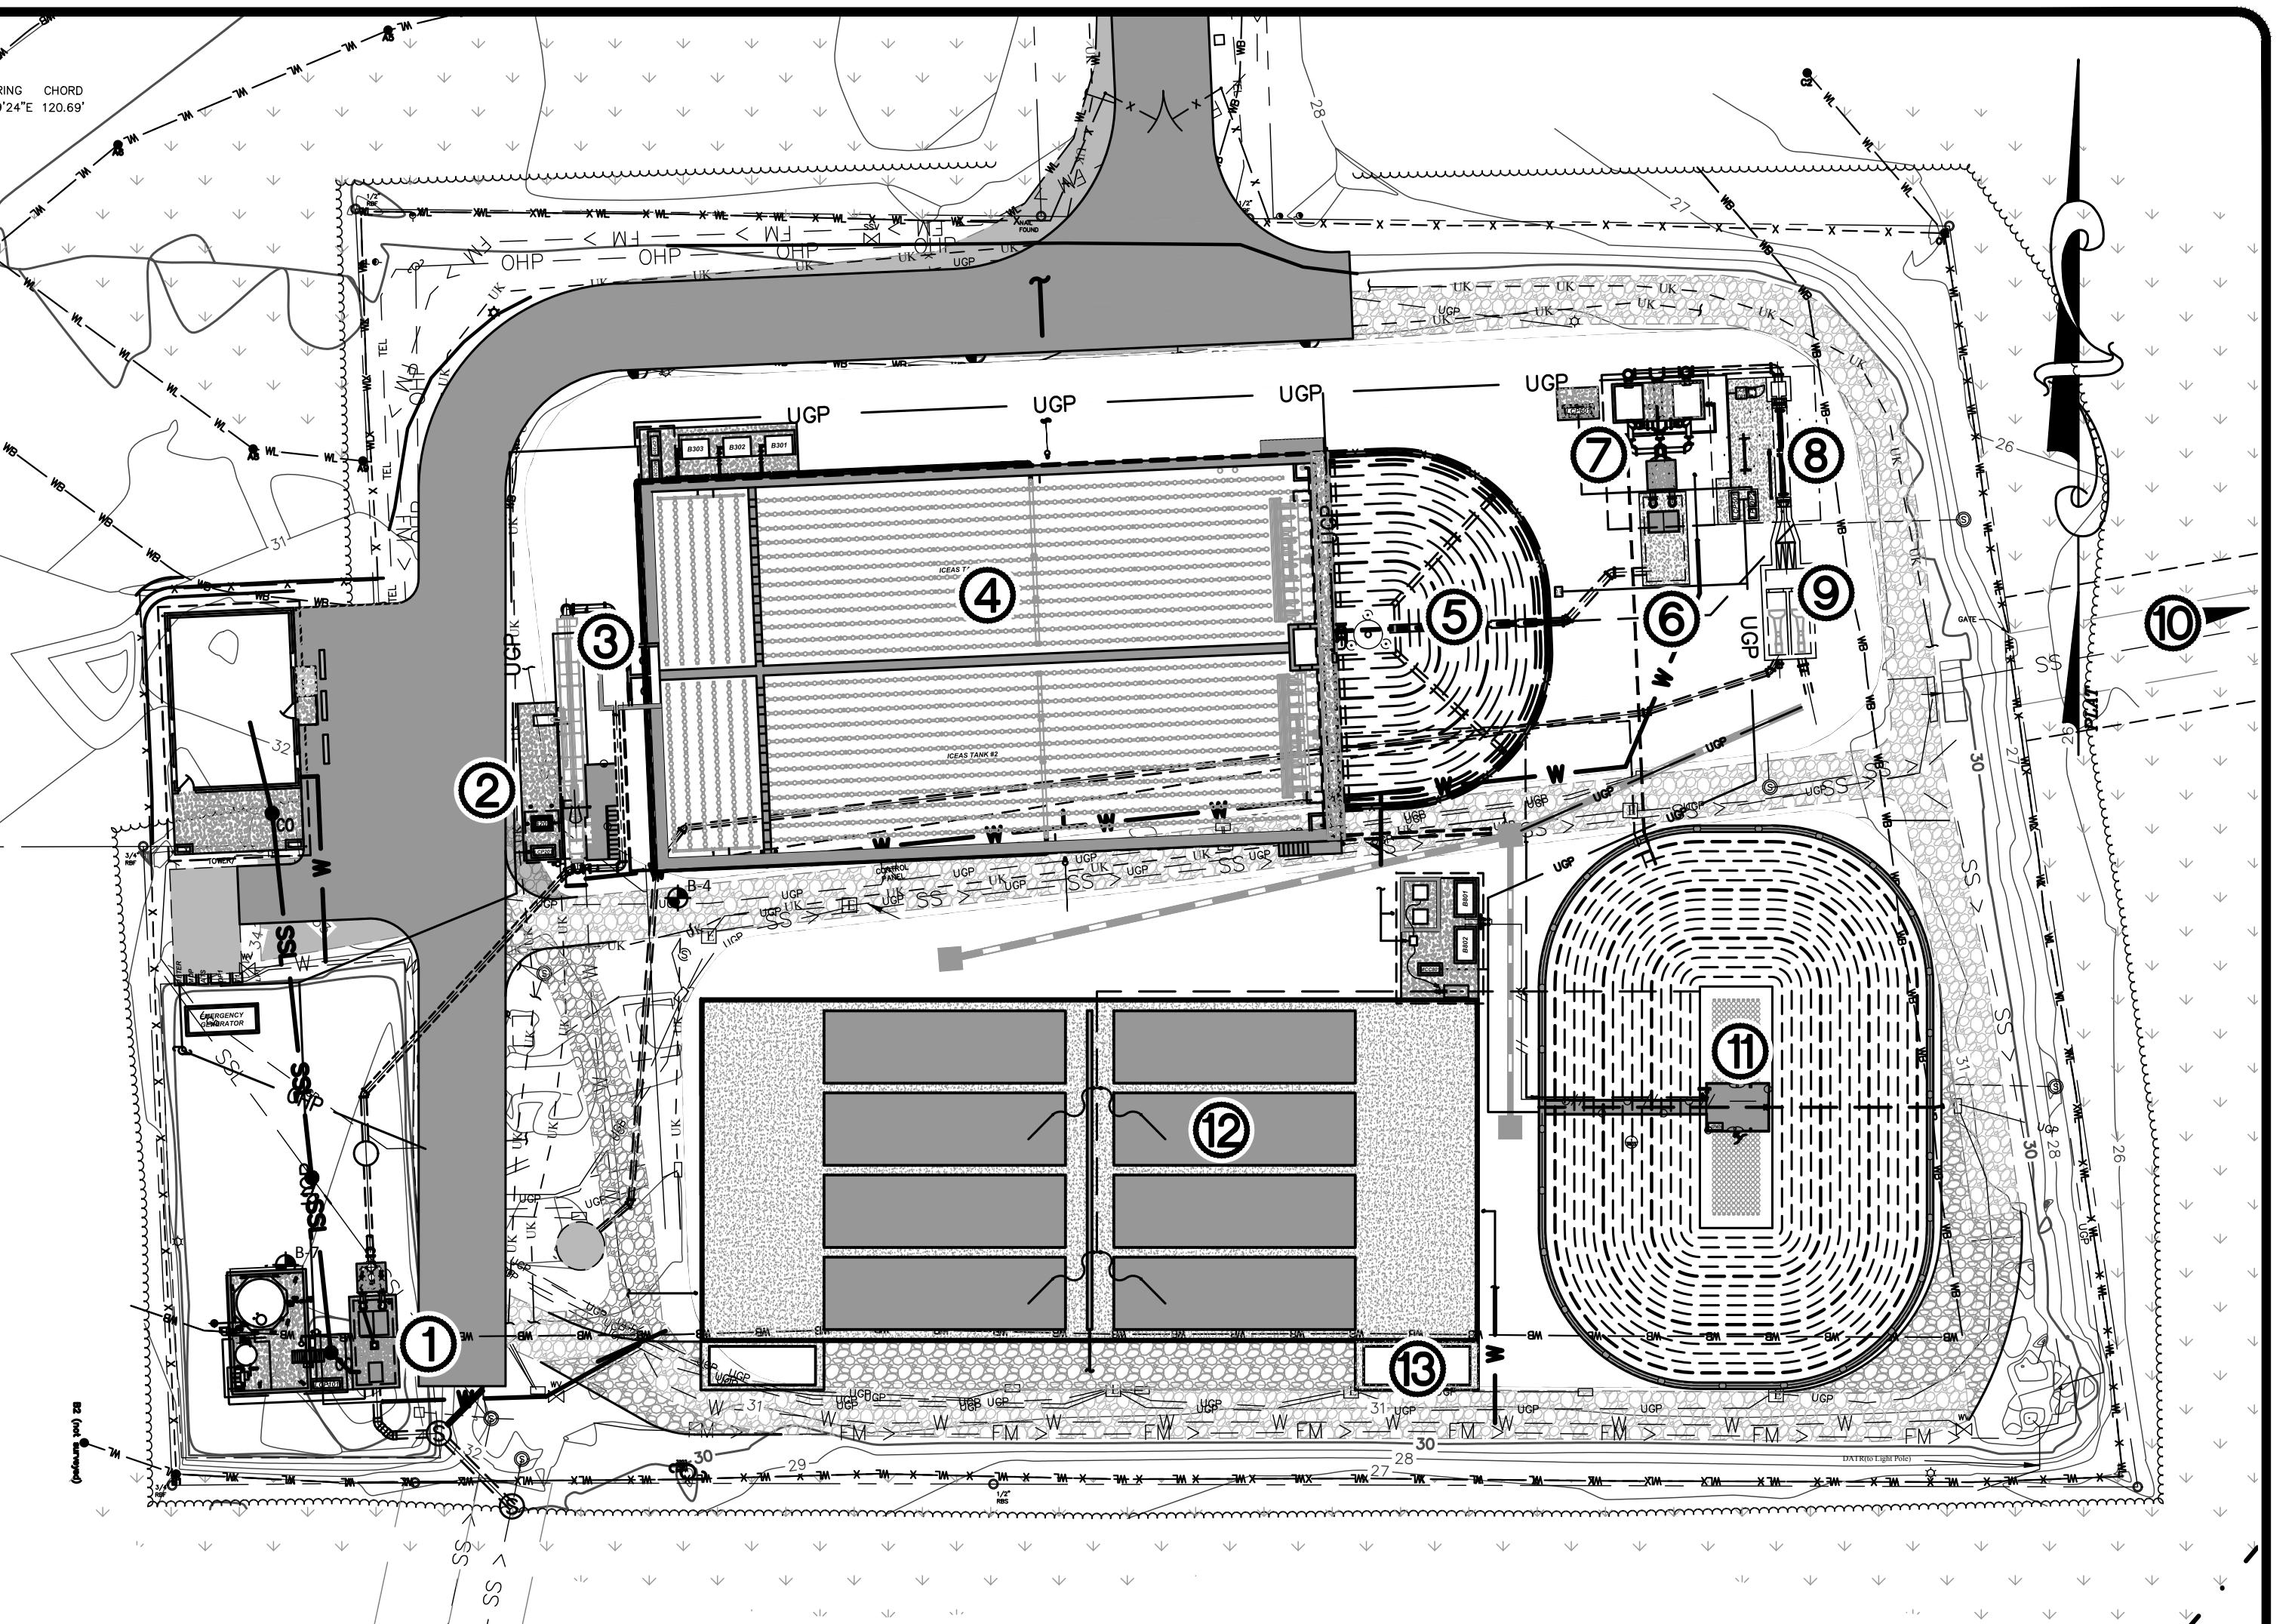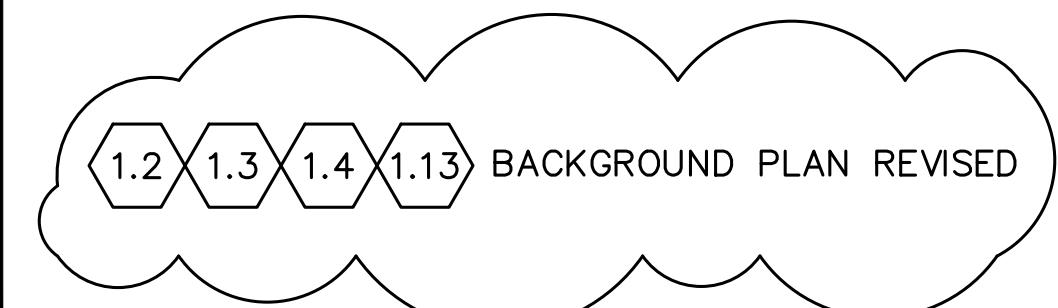





Phase 4

Completion of Construction and Start-Up of All Operations

PHASE 4 TREATMENT PROCESS	
1	PROPOSED INFLUENT PUMP STATION
2	HEADWORKS
3	SPLITTER BOX
4	ICEAS
5	EQ POND
6	PROPOSED EFFLUENT PUMP STATION
7	EFFLUENT FILTERS (IF APPLICABLE)
8	UV
9	PARSHALL FLUME
10	CREEK OUTFALL
11	WASTED SLUDGE TO DIGESTER
12	THICKENED SLUDGE TO GEOTUBES
13	DRIED SLUDGE TO LANDFILL

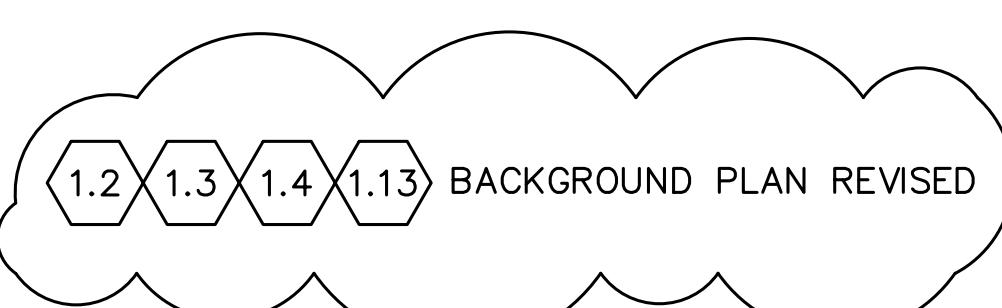

THE FIRST NUMBER REFERENCES THE ADDENDUM NUMBER WHILE
THE SECOND NUMBER REFERENCES THE ADDENDUM ITEM NUMBER

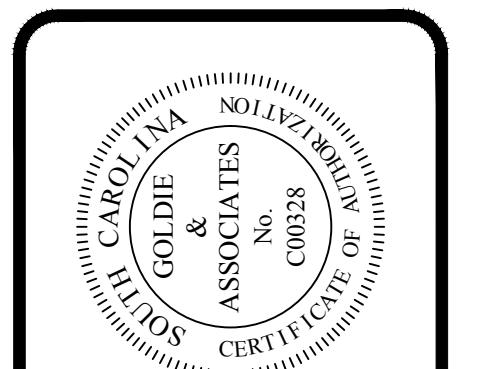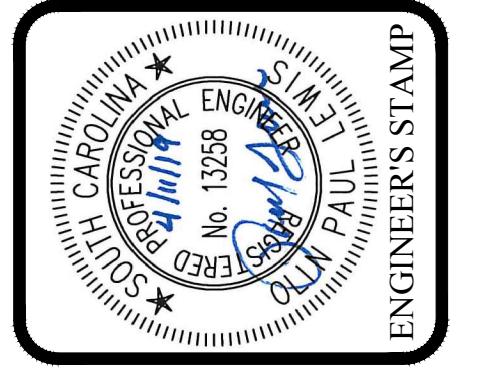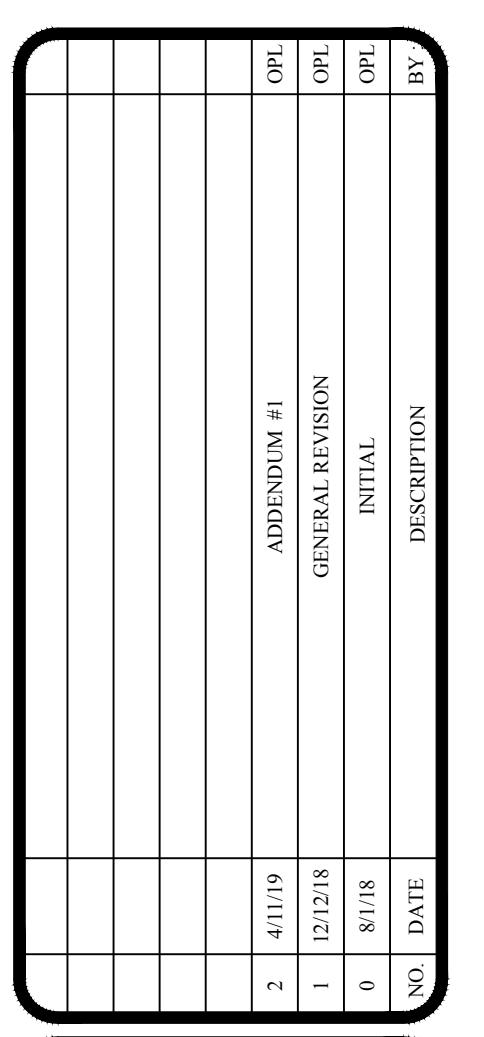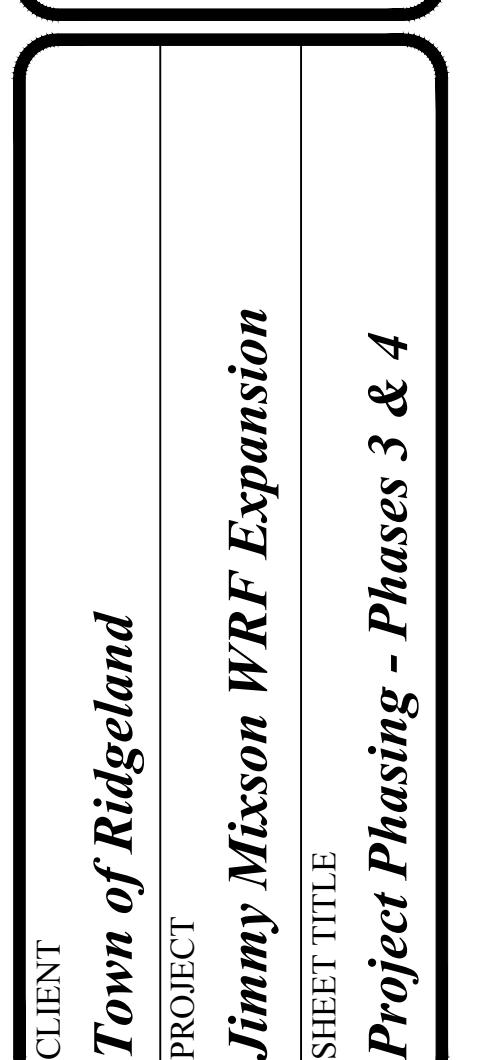

Civil and Environmental Engineering
Environmental Consulting
Utility Operations
Environmental Laboratory



Jimmy Mixson WRF Expansion

Town of Ridgeland

PROJECT

HEET NO. G022	OF ---
ILE NO. 1636.6	


VALVE SCHEDULE

Mark	Spec	Size	Supplier	Service	Type	Actuator	Dwg Ref
Influent Pump Station							
V101	33 31 23	12"	Contractor	Inf pump P101 discharge	Check		CS011
V102	"	12"	Contractor	Inf pump P101 discharge	Plug	Handwheel	CS011
V103	"	12"	Contractor	Inf pump P102 discharge	Check		CS011
V104	"	12"	Contractor	Inf pump P102 discharge	Plug	Handwheel	CS011
V105	"	12"	Contractor	Inf pump station bypass	Plug	Handwheel	CS011
V106	NOT USED	1.11"					
V107	3/4"	Contractor	Caustic skid Tank Shut Off	S/S Ball	Lever		CS011
V108	46 33 42	3/4"	Vendor	Caustic skid P103 shut off	Ball	Lever	CS011
V109	"	3/4"	Vendor	Caustic skid P104 shut off	Ball	Lever	CS011
V110	"	1/2"	Vendor	Caustic skid P103 pressure relief	Pressure Relief		CS011
V111	"	1/2"	Vendor	Caustic skid P104 pressure relief	Pressure Relief		CS011
V112	"	1/2"	Vendor	Caustic skid P103 back pressure	Control		CS011
V113	"	1/2"	Vendor	Caustic skid P104 back pressure	Control		CS011
V114	2"	Contractor	Bulk tank shut off	S/S Ball	Lever		CS011
V115	2"	Contractor	Caustic transfer pump check	S/S Check			CS011
V116	2"	Contractor	Caustic bulk tank shut off	S/S Ball	Lever		CS011
V117	2"	Contractor	Caustic bulk tank shut off (fill pipe)	S/S Ball	Lever	M111	
V118	2"	Contractor	Caustic bulk tank fill pipe	S/S Check		M111	
V119	2"	Contractor	Caustic bulk tank fill pipe shut off	S/S Ball	Lever	M111	
Headworks							
V201	33 31 23	14"	Contractor	Screening shut off	Plug	Handwheel	CS011
V202	33 31 23	14"	Contractor	Screening bypass	Plug	Handwheel	CS011
V203	46 21 00	3"	Vendor	Grit tank drain	Ball	Lever	CS011
V204	"	1"	Vendor	Grit tank air piping shut off	Ball	Lever	CS011
V205	"	1"	Vendor	Blower B201 check	Bronze Check		CS011
V206	"	1"	Vendor	Blower B201 shut off	Bronze Ball		CS011
V207	"		Vendor	Blower B201 pressure relief			CS011
V208	"		Vendor	Screening water shut off	Ball	Level	CS011
V209			Contractor	Screening area hose bib			CS011
ICEAS							
V301	46 53 53		Vendor	ICEAS Blower B301 relief			CS012
V302	"	8"	Vendor	ICEAS Blower B301 check	Check		CS012
V303	"	8"	Vendor	ICEAS Blower B301 shut off	Butterfly	Lever	CS012
V304	"		Vendor	ICEAS Blower B302 relief			CS012
V305	"	8"	Vendor	ICEAS Blower B302 check	Check		CS012
V306	"	8"	Vendor	ICEAS Blower B302 shut off	Butterfly	Lever	CS012
V307	"		Vendor	ICEAS Blower B303 relief			CS012
V308	"	8"	Vendor	ICEAS Blower B303 check	Check		CS012
V309	"	8"	Vendor	ICEAS Blower B303 shut off	Butterfly	Lever	CS012
V310	40 23 00	10"	Contractor	ICEAS Blowers Isolation #1	Butterfly	Lever	CS012
V311	"	10"	Contractor	ICEAS Blowers Isolation #2	Butterfly	Lever	CS012
V312	33 31 23	4"	Contractor	ICEAS #1 Sludge pump check	Check		CS012
V313	"	4"	Contractor	ICEAS #1 Sludge pump shut off	Plug	Lever	CS012
V314	"	4"	Contractor	ICEAS #2 Sludge pump check	Check		CS012
V315	"	4"	Contractor	ICEAS #2 Sludge pump shut off	Plug	Lever	CS012
V316	1"	Contractor	ICEAS #1 Air Line Purge	Bronze Ball	Lever		CS012
V317	1"	Contractor	ICEAS #1 Pre Rxn Air Line Purge	Bronze Ball	Lever		CS012
V318	1"	Contractor	ICEAS #2 Pre Rxn Air Line Purge	Bronze Ball	Lever		CS012
V319	1"	Contractor	ICEAS #2 Air Line Purge	Bronze Ball	Lever		CS012
CV301	46 53 53	10"	Vendor	ICEAS #1 Air Control	Butterfly	Motorized	CS012
CV302	46 53 53	10"	Vendor	ICEAS #2 Air Control	Butterfly	Motorized	CS012
V320	"	4"	Contractor	ICEAS #1 Air Shut Off	Butterfly	Lever	CS012
V321	10"	Contractor	ICEAS #1 Air Shut Off	Butterfly	Lever		CS012
V322	4"	Contractor	ICEAS #2 Air Shut Off	Butterfly	Lever		CS012
V323	10"	Contractor	ICEAS #2 Air Shut Off	Butterfly	Lever		CS012
V324			Contractor	ICEAS Sludge Pump ARV	ARV	--	CS012



PIPE SCHEDULE

Mark	Spec	Size	Supplier	Service	Type	Actuator	Dwg Ref
Post-EQ Pond							
V401	NOT USED						
V402	NOT USED						
V403	NOT USED	1.4"					
V404	NOT USED						
V405	NOT USED						
V406	NOT USED						
Effluent Pump Station							
V501	33 31 23	12"	Contractor	Effluent pump P501 check	Check		CS013
V502	"	12"	Contractor	Effluent pump P502 check	Check		CS013
V503	"	12"	Contractor	Effluent pump P501 shut off	Gate		CS013
V504	"	12"	Contractor	Effluent pump P502 shut off	Gate		CS013
V505			Contractor	Effluent pump ARV	ARV		CS013
Effluent Filters (Alternate)							
V601	40 23 00	12"	Contractor	Eff Filter #1 inlet	Butterfly	Handwheel	CS013
V602	"	12"	Contractor	Eff Filter #2 inlet	Butterfly	"	CS013
V603	"	12"	Contractor	Filter bypass	Butterfly	"	CS013
V604	40 61 43	3"	Vendor	Eff Filter #1 Backwash pump shut off valve	Ball		CS013
V605	"	3"	Vendor	Eff Filter #1 Backwash pump check valve	Check		CS013
V606	"	3"	Vendor	Eff Filter #2 Backwash pump shut off valve	Ball		CS013
V607	"	3"	Vendor	Eff Filter #2 Backwash pump check valve	Check		CS013
Digester Pond and Geotubes (Alternate)							
V801	43 11 33		Vendor	Digester Blower B801 relief			CS014
V802	"	6"	Vendor	Digester Blower B802 relief			CS014
V803	"	6"	Vendor	Digester Blower B801 check	Check		CS014
V804	"		Vendor	Digester Blower B802 check	Check		CS014
V805	"	6"	Vendor	Digester Blower B801 shut off	Butterfly	Lever	CS014
V806	"	6"	Vendor	Digester Blower B802 shut off	Butterfly	Lever	CS014
V807	40 23 00		Contractor	Digester Blower Isolation			CS014
V808	NOT USED						
V809	NOT USED						
V810	33 31 23	4"	Contractor	Digester Sludge Pump Shut Off	Plug	Lever	CS014
V811			Contractor	Digester Sludge Pump ARV	ARV		CS014
V812	33 31 23	4"	Contractor	Digester Sludge Pump P803 Check	Check		CS014
V813	"	4"	Contractor	Digester Sludge Pump P803 Shut Off	Plug	Lever	CS014
V814		2"	Contractor	Digester Decant Pump P801 Shut Off	Bronze Ball	"	CS014
V815		2"	Contractor	Digester Decant Pump P801 ARV	ARV		CS014
V816		2"	Contractor	Digester Decant Pump P801 Check	Bronze Check		CS014
V817	NOT USED						
V818		1"	Contractor	Polymer Injection Shut Off	S/S Ball	Lever	CS014
V819 A+B		3"	Contractor	Geotube Shut Off	Plug	"	CS014
V820 A+B		3"	Contractor	Geotube Shut Off	Plug	"	CS014
V821	46 33 42		Vendor	Neat Polymer Tote Shut Off			CS014
V822	"		Vendor	Polymer Makedown Calibration Column Shut Off			CS014
V823	"		Vendor	Polymer Makedown Air Bleed Valve			CS014
V824	"		Vendor	Pressure Relief and Backflow Prevent			CS014
V825	"	1"	Vendor	Makedown Polymer Outlet			CS014
V826		1"	Contractor	Water Supply Shut Off	Bronze Ball	Lever	CS014
V827		1"	Contractor	Mixed Sludge Test Port	Bronze Ball	Lever	CS014

Pipe	Size	Material	Starts	Finishes

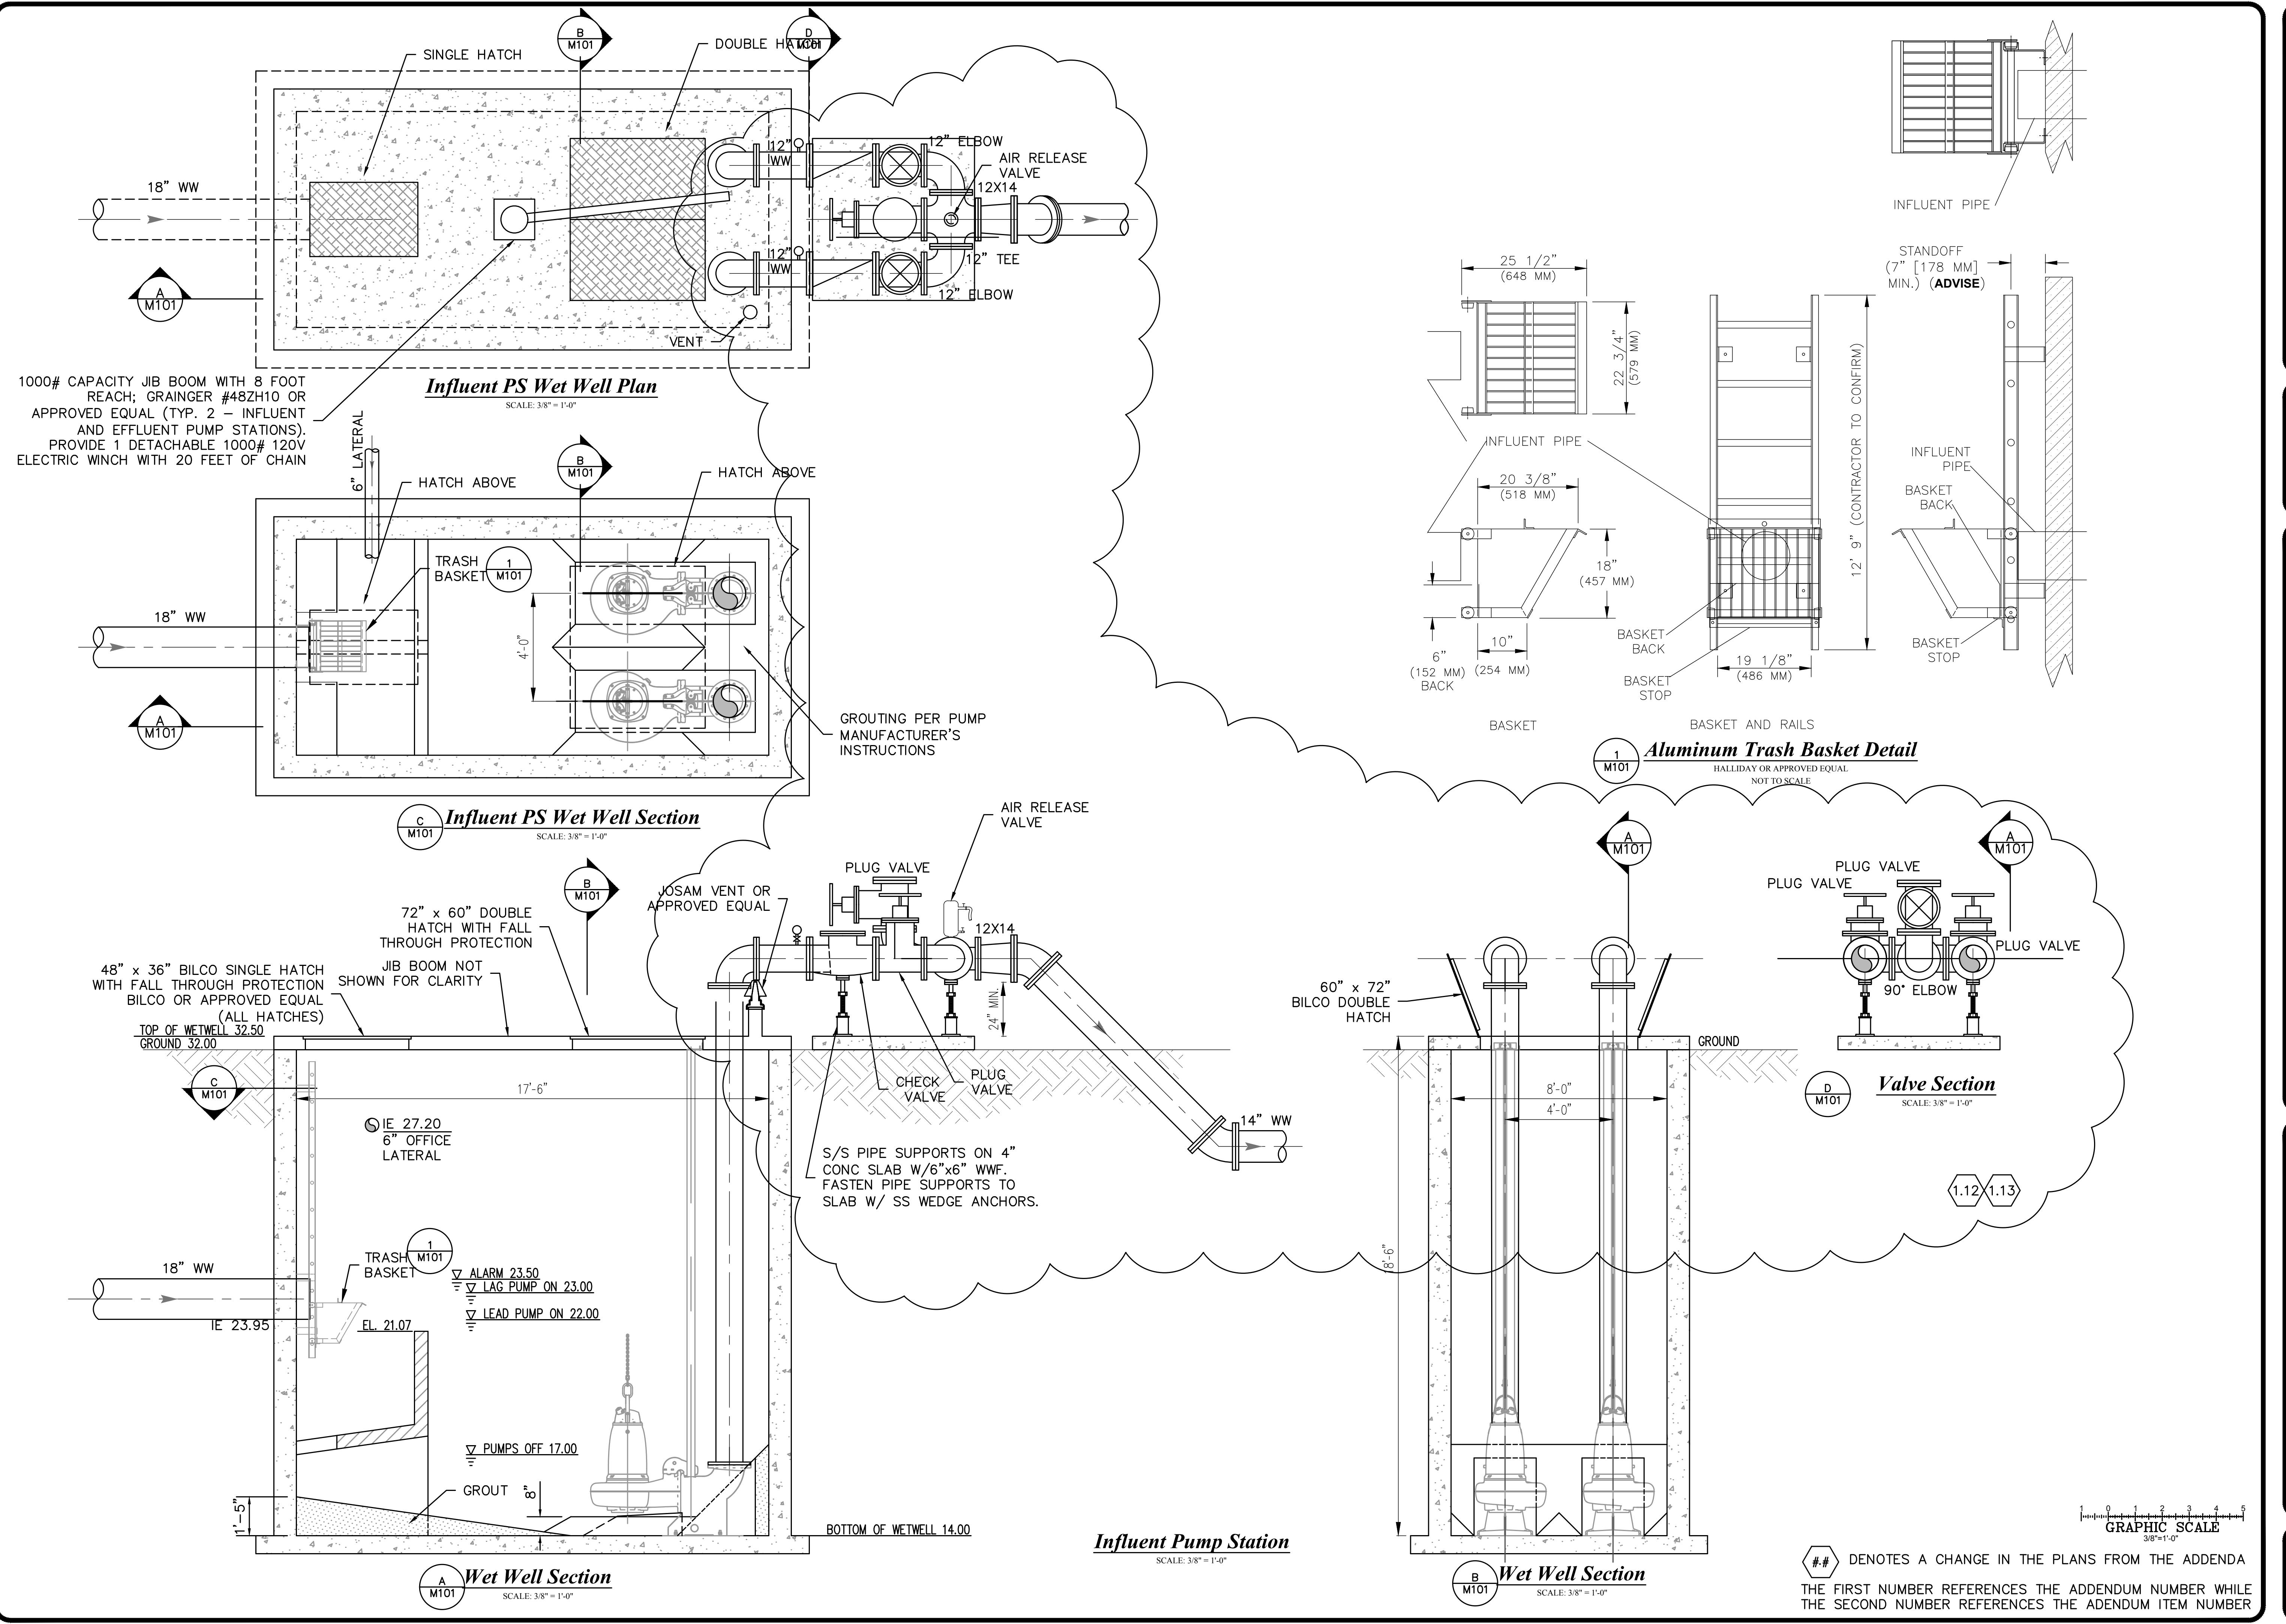

CLIENT	TOWN OF RIDGELAND
PROJECT	JIMMY MIXSON WRF EXPANSION
SHEET TITLE	INFLUENT PUMP STATION
FILE NO.	1636.6
DATE	8/1/18
ADDENDUM #	0
GENERAL Revision	INITIAL
OBJS	BY
DESCRIPTION	

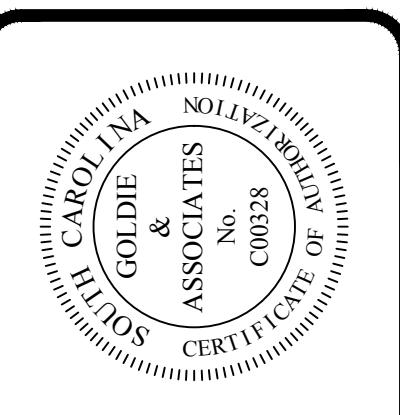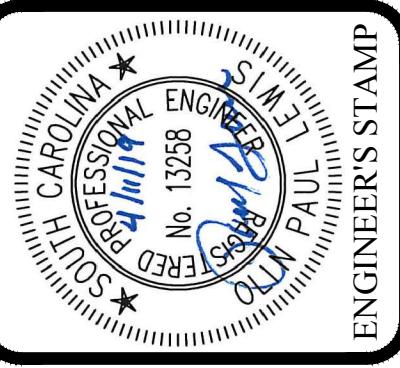

210 W. North Second Street
Seneca, SC 29678
Phone: (864) 882-8194
Civil and Environmental Engineering
Utility Operations
Environmental Laboratory







CLIENT	TOWN OF RIDGELAND
PROJECT	JIMMY MIXSON WRF EXPANSION
SHEET TITLE	INFLUENT PUMP STATION
FILE NO.	M101
OF	--

1 2 3 4 5
GRAPHIC SCALE
3/8" = 1'-0"



Influent Pump Station

ITEM NO.	PART NUMBER	DESCRIPTION	Default QTY.
1	PES00059-000	BRACKET, SKID MOUNTING	2
2	PES00305-PVCV-LHS	PIPING ASSY(PVC),BL,LEFT SIDE	1
3	PES00305-PVCV	PIPING ASSY(PVC),BL,LF,V	1
4	PES00402-000	SKID BASE WELDMENT,BL,PES2S,LF	1
5	PES00805-000	BLACKLINE PUMP MOUNT	2
6	03-043-00	PLUG, PVC-80, 1/2" T	2
7	03-127-00	CLAMP ASSEM, 1" PIPE,BOT PNL	4
8	03-127-01	CLAMP ASSEM, 1" PIPE,BOT PNL	2
9	03-127-02	CLAMP ASSEM, 1" PIPE,BOT PNL	7
10	03-127-03	CLAMP ASSEM, 1" PIPE,BOT PNL	3
11	03-127-04	CLAMP ASSEM, 1000ML CAL COLUMN	2
12	21411	BOLT(ST), .31-18 X 1.0-LG HEX	4
13	32942	NUT(ST), .25-20 X .22	4
14	42022	WASHER(ST), .28X.63X.05 FLAT	4
15	J25334	LABEL(LEXAN), LOGO NAMEPLATE	1
16	L9801800-188	SCREW(ST), .25-20 X 2.	4
17	U0900857	SCR(BT),.6-20 X.38 TYPE-BT PHP	2

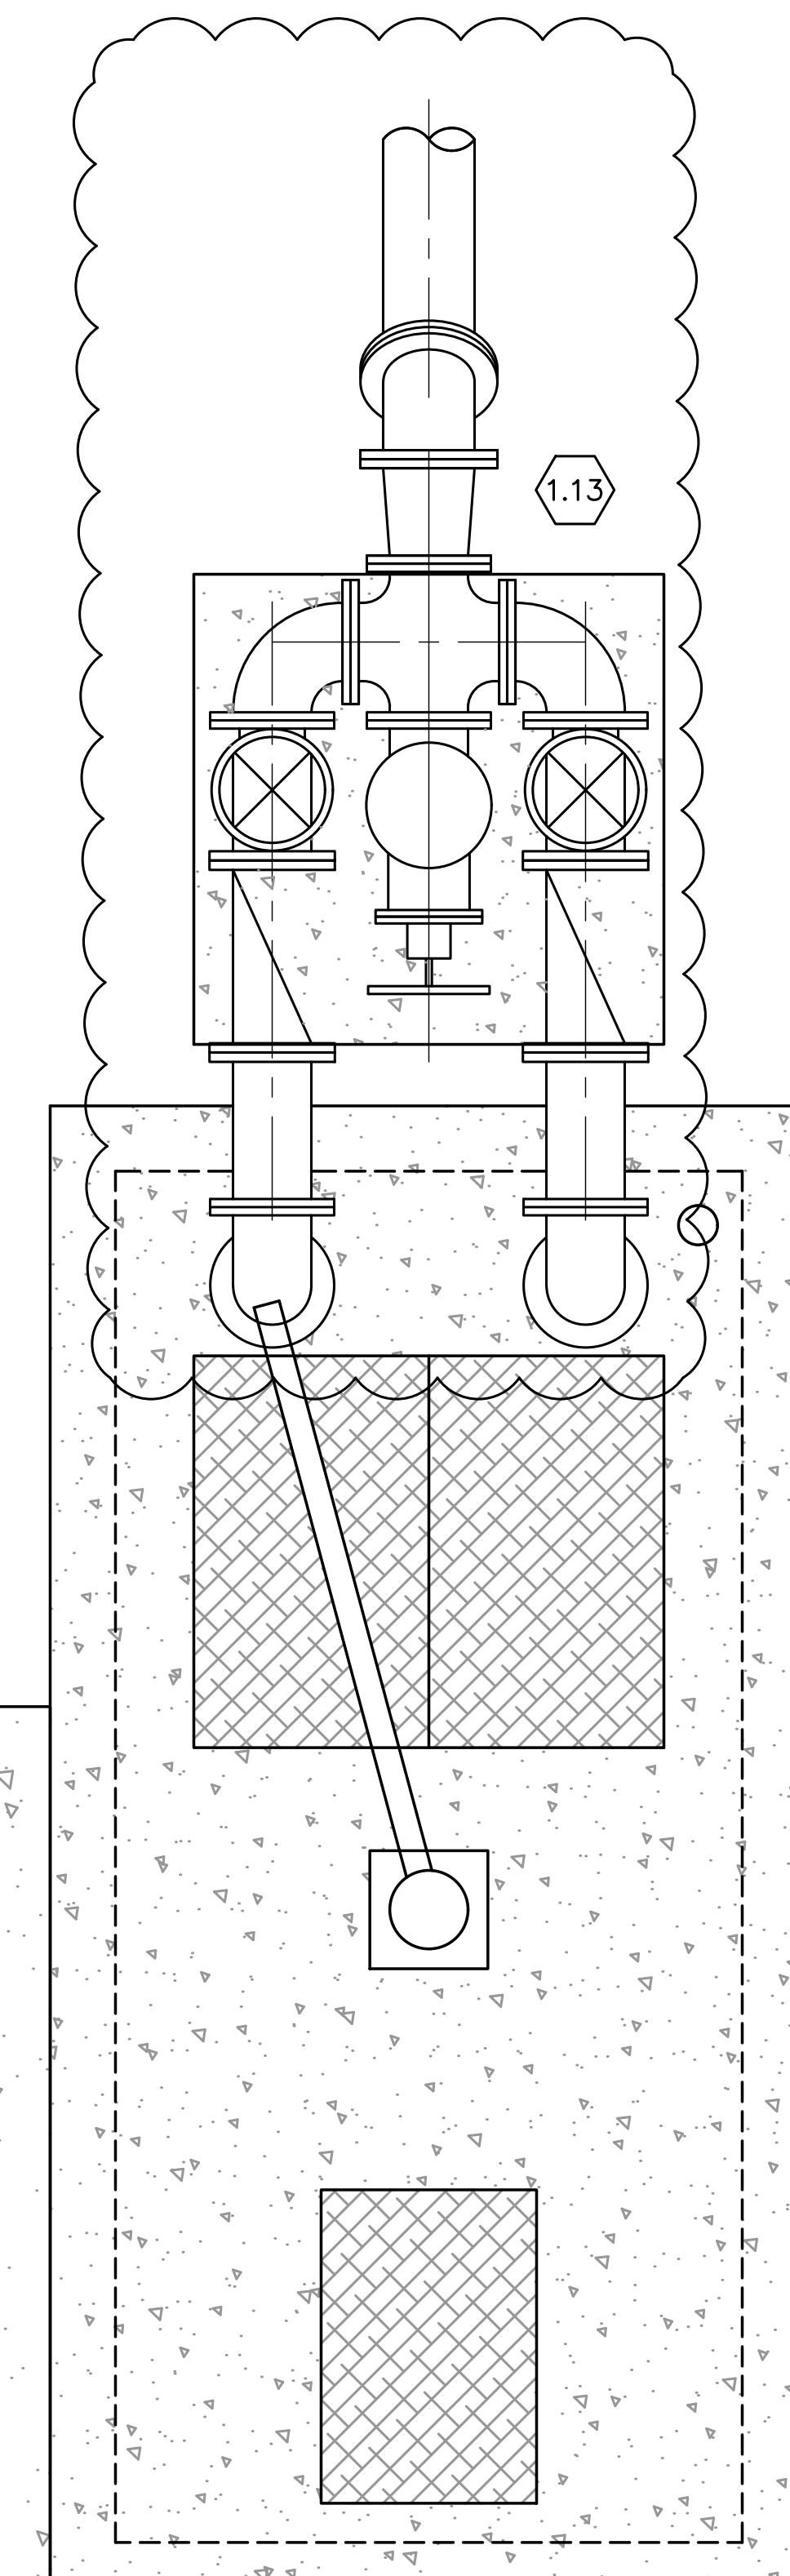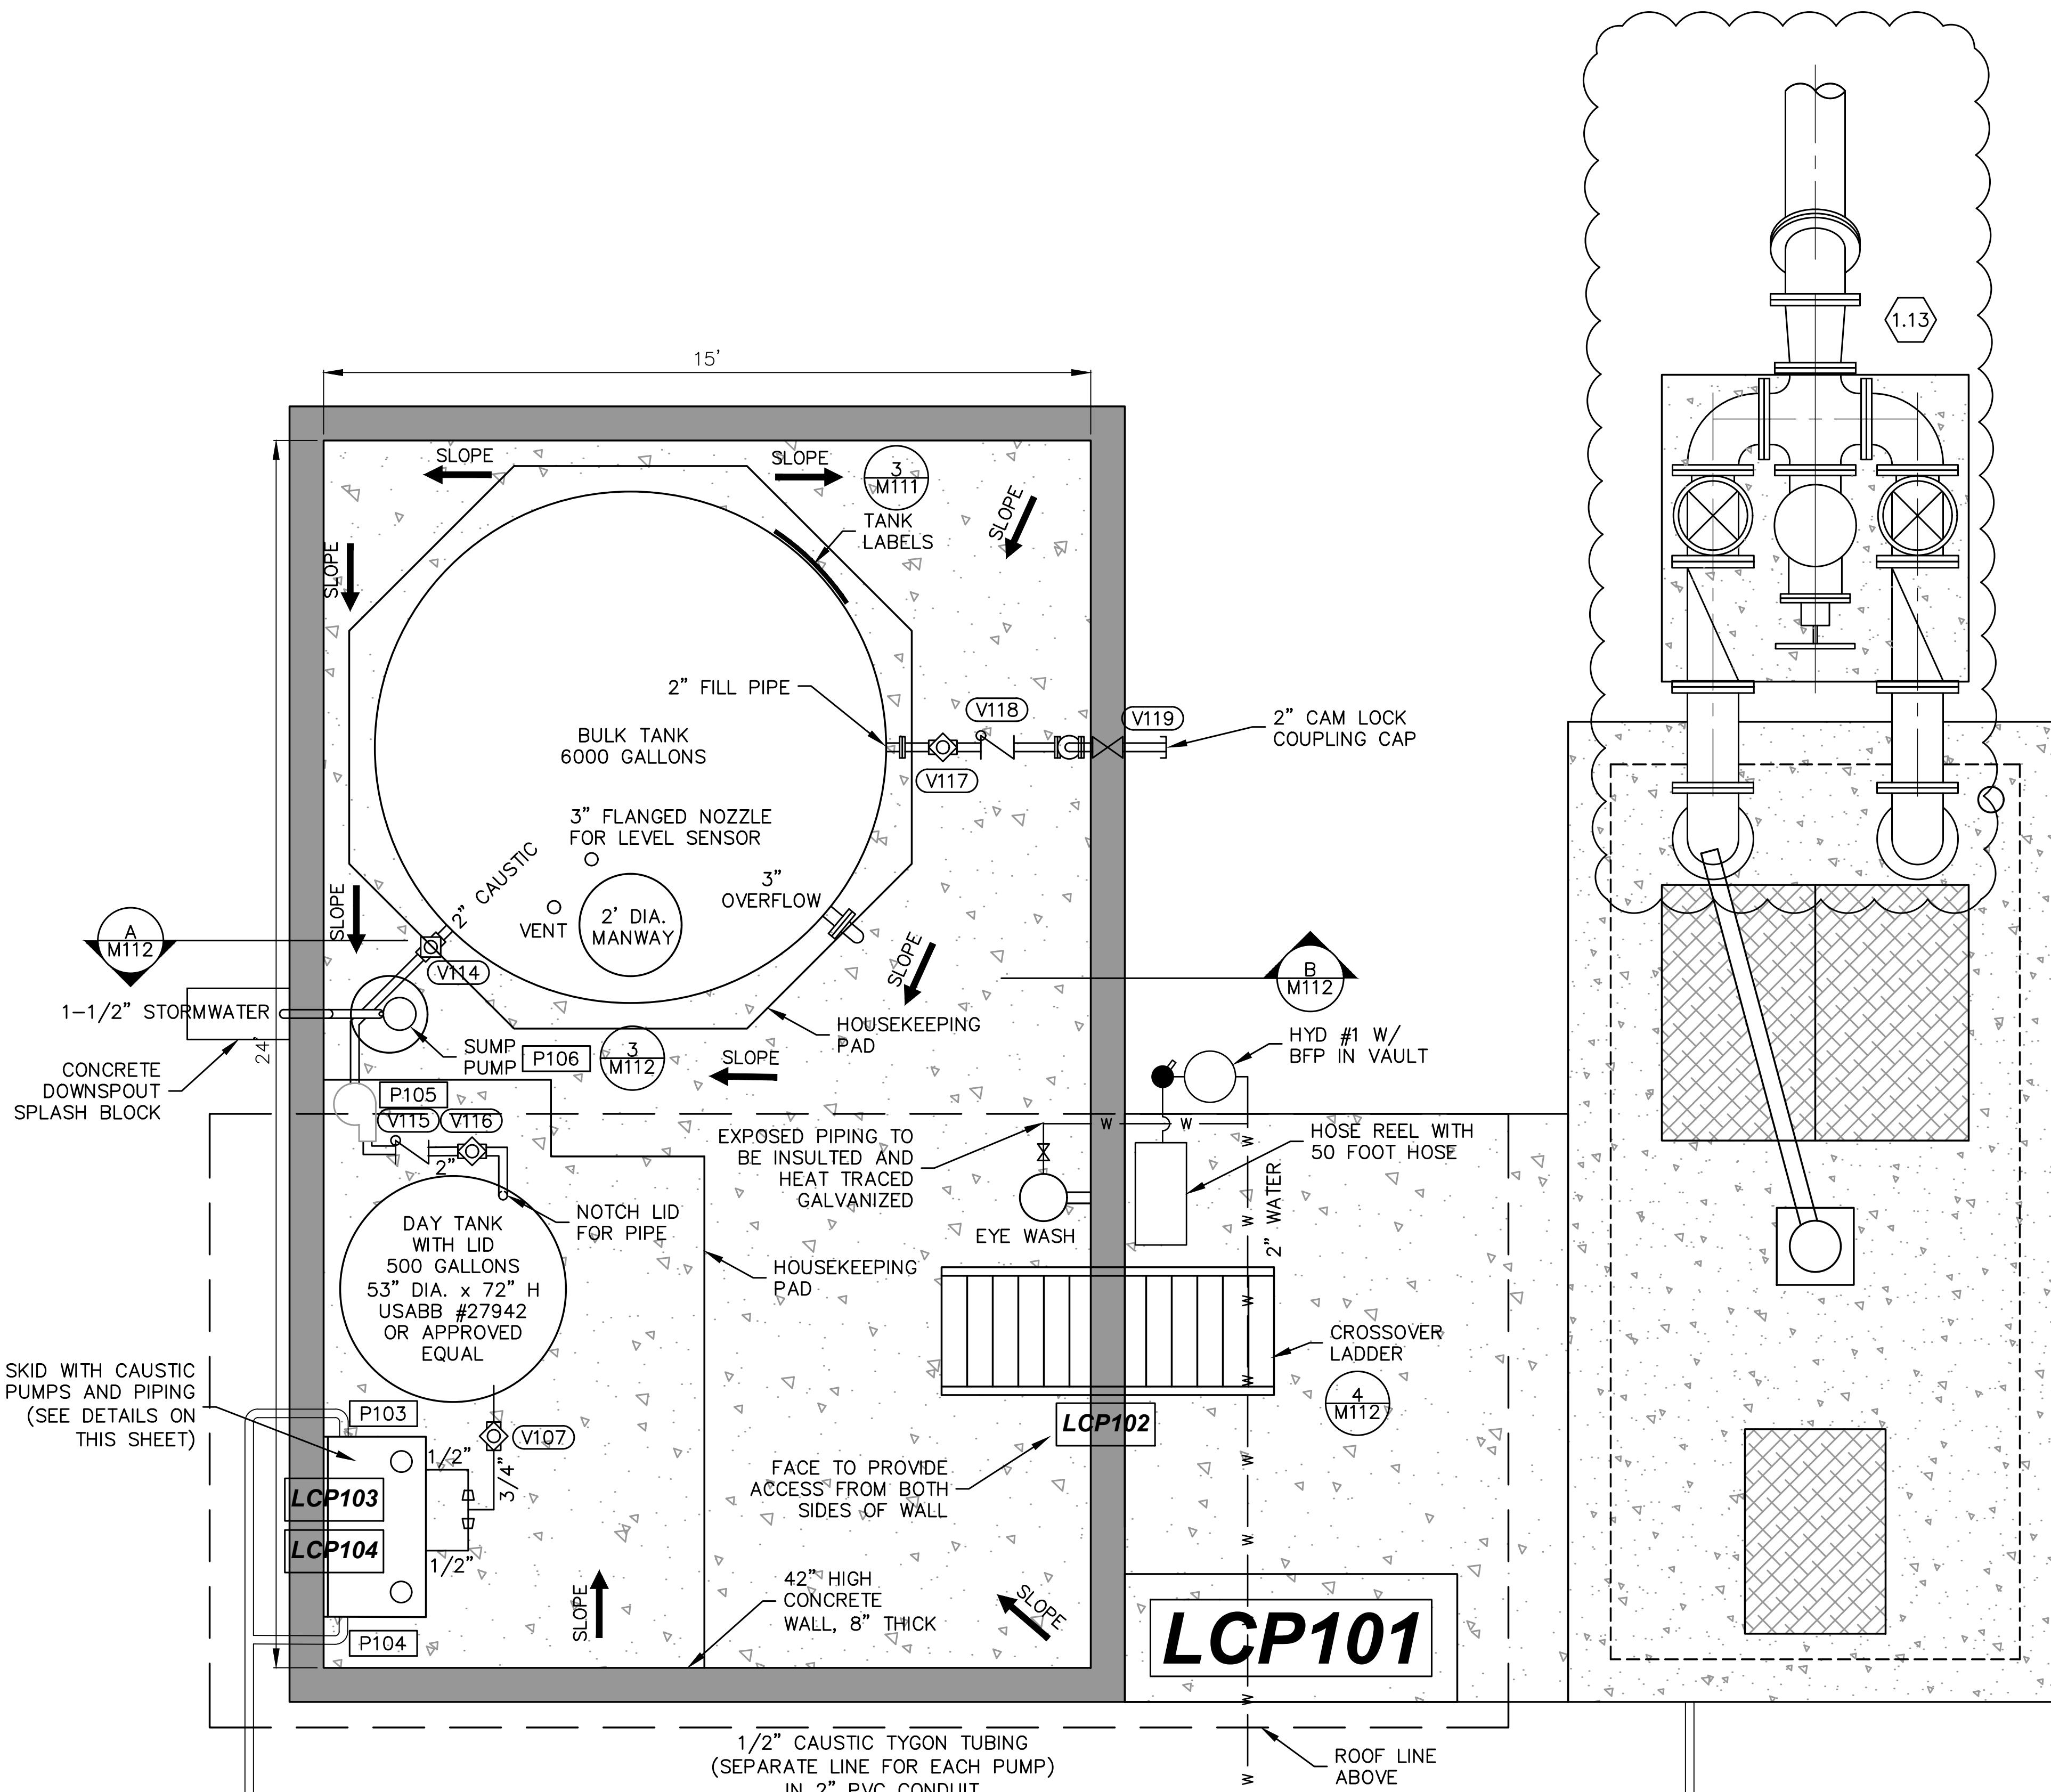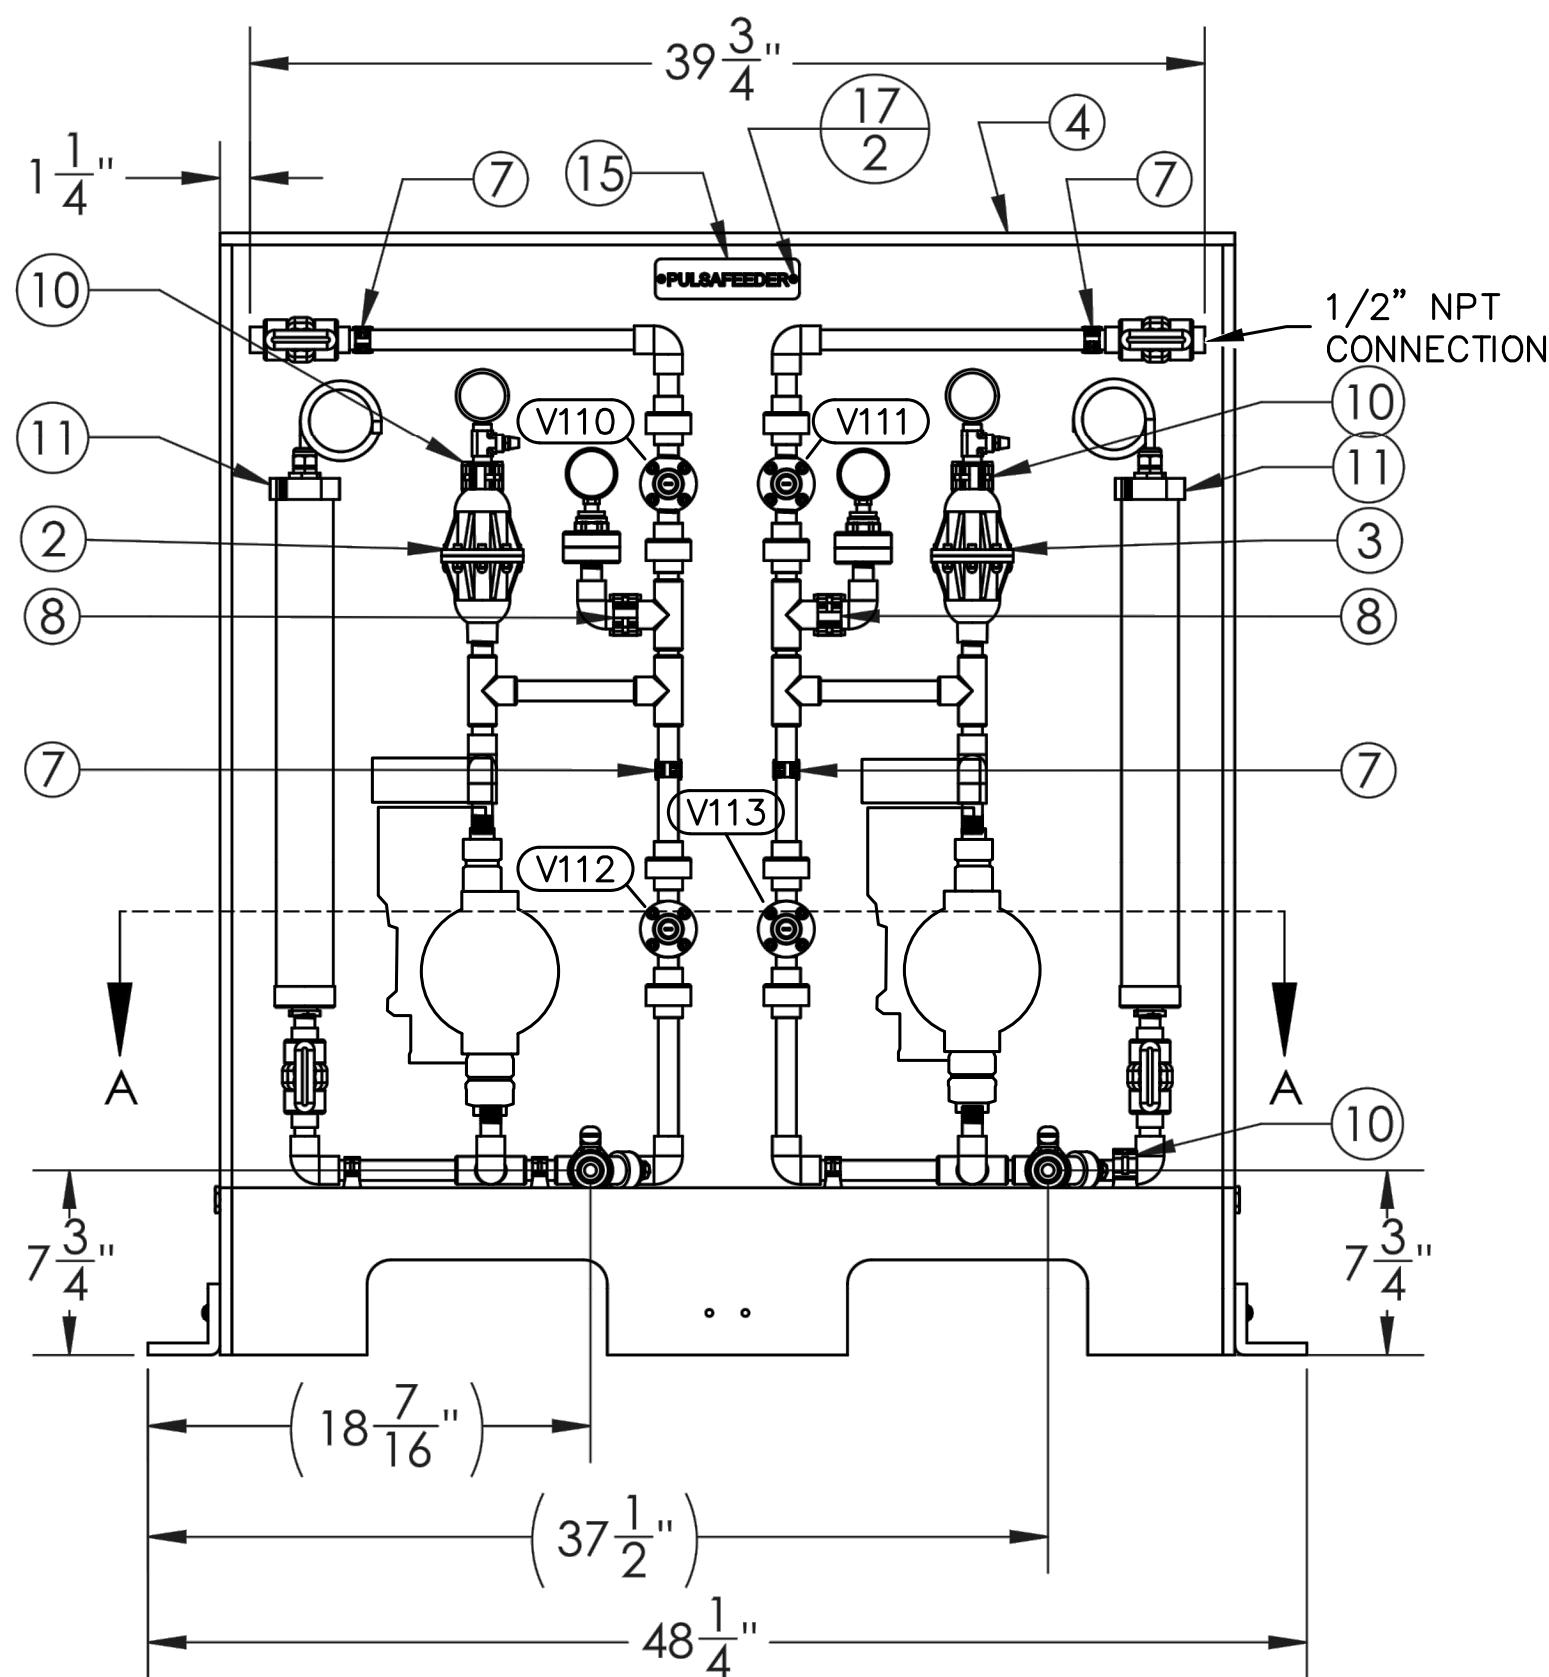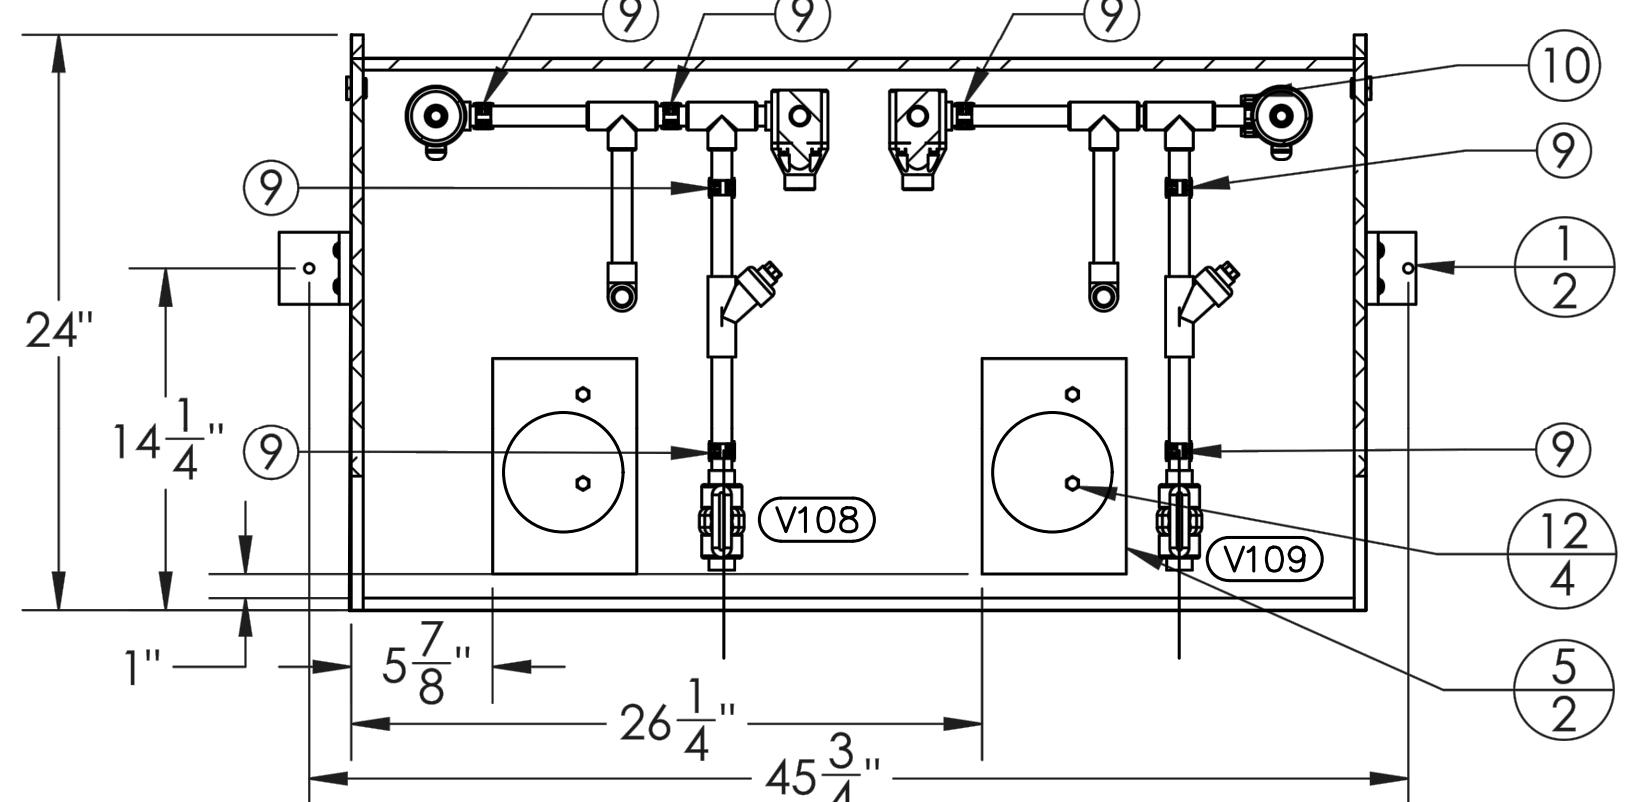

denotes a change in the plans from the addenda
The first number references the addendum number while
the second number references the addendum item number


2	4/10/19	ADDITION #1	OPN
1	12/2/18	GENERAL REVIEW	OPN
0	8/1/18	INITIAL	OPN
		DESCRIPTION	BY

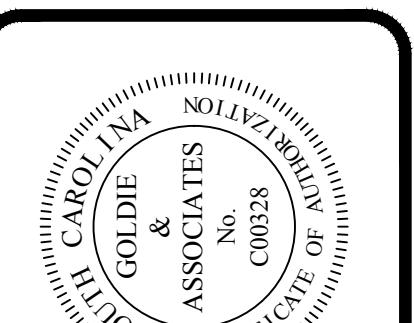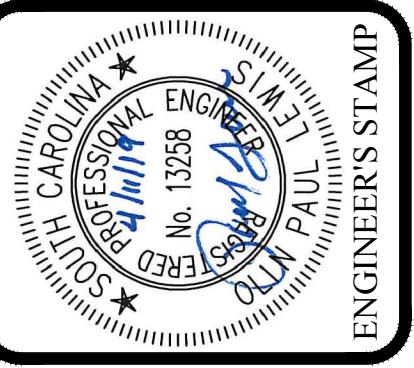



210 W. North Second Street
Seneca, SC 29678
Phone: (864) 382-3194
Civil and Environmental Engineering
Utility Operations
Environmental Laboratory



CLIENT	Town of Ridgeland
PROJECT	Jimmy Mixson WRF Expansion
SHEET TITLE	Caustic Feed System and Details
SHEET NO.	M111
OF	--
FILE NO.	1636.6

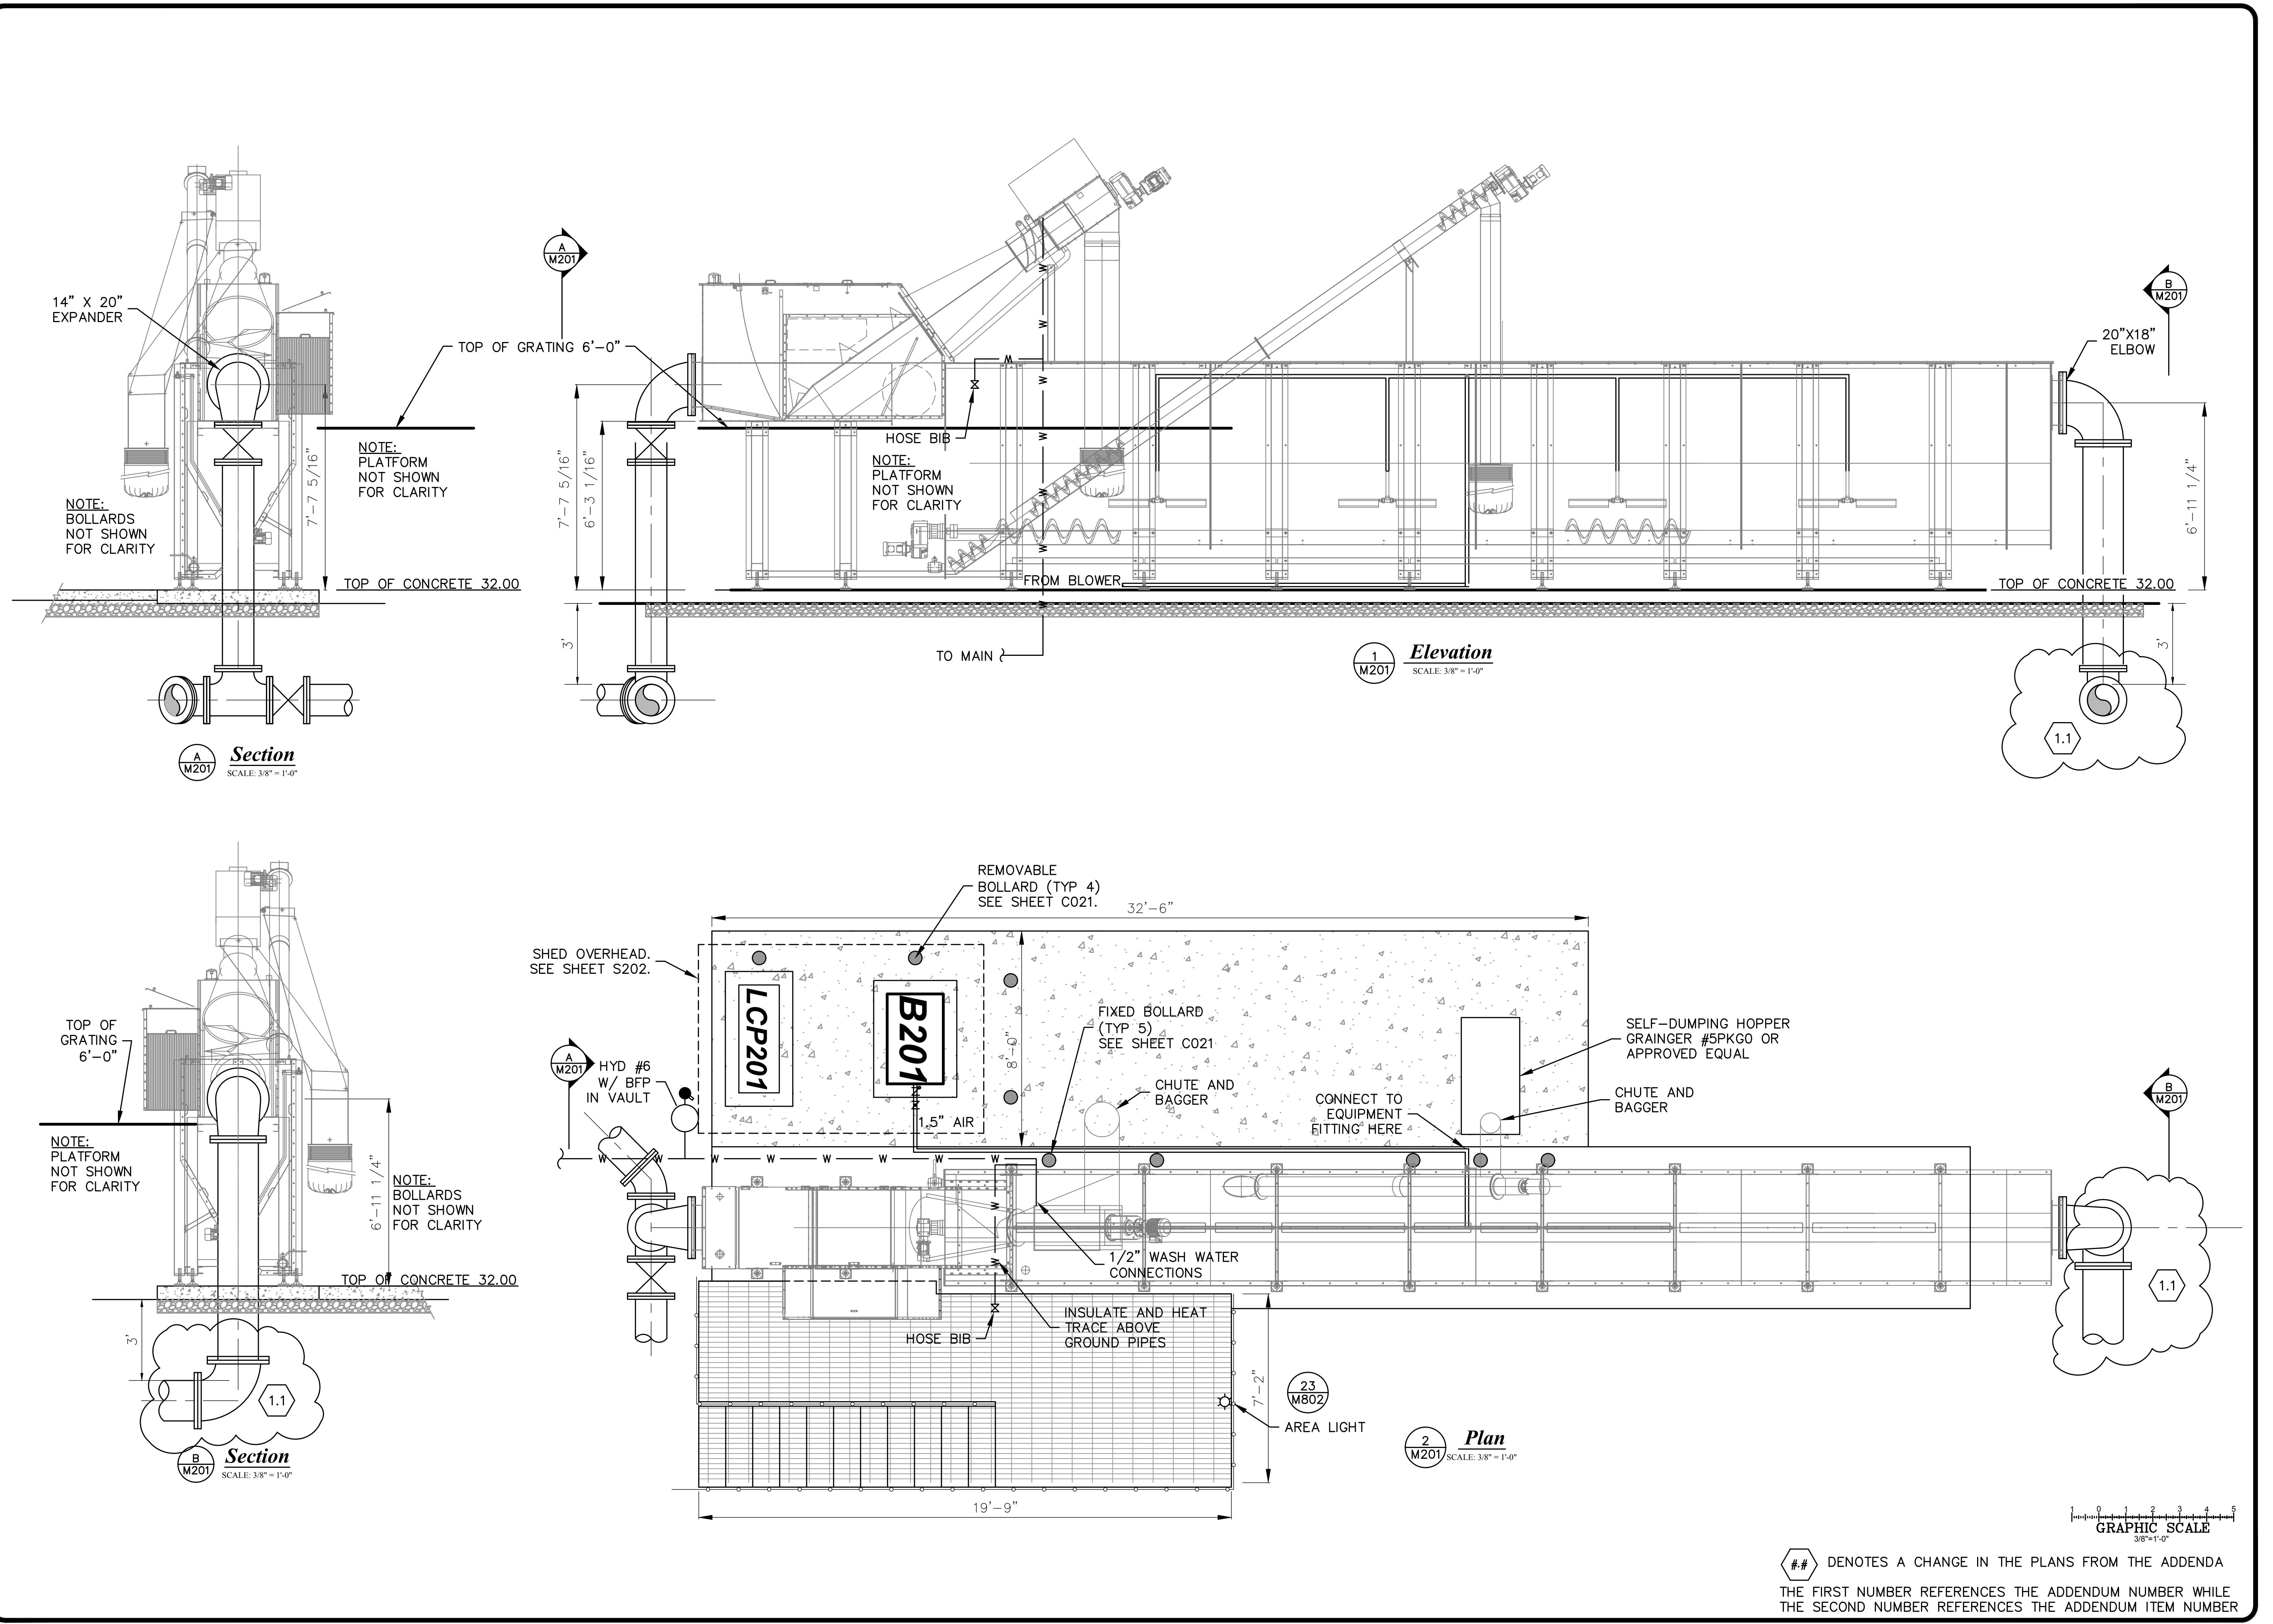


CLIENT	WILLIAMS	PROJECT	Jimmy Mixson WRF Expansion
SHEET TITLE	Headworks	FILE NO.	M201
OF	--	FILE NO.	1636.6
HEADWORKS		HEADWORKS	
ADDENDUM #	410119	GENERAL REVISION	INITIAL
DATE	12/2/18	INITIAL	BY
DESCRIPTION	Headworks		

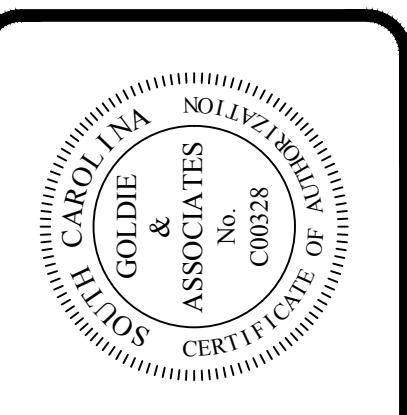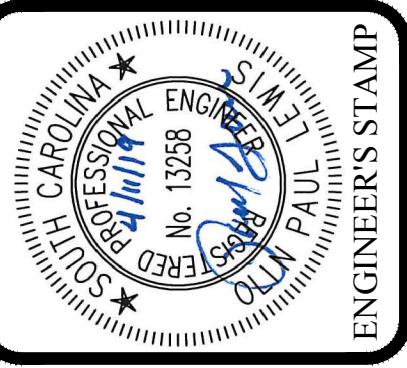


210 W. North Second Street
Seneca, SC 29678
Phone: (864) 882-8194
Civil and Environmental Engineering
Environmental Consulting
Utility Operations
Environmental Laboratory




CLIENT	Town of Ridgeland	PROJECT	Jimmy Mixson WRF Expansion
SHEET TITLE	Headworks	FILE NO.	M201
OF	--	FILE NO.	1636.6
HEADWORKS		HEADWORKS	
ADDENDUM #	410119	GENERAL REVISION	INITIAL
DATE	12/2/18	INITIAL	BY
DESCRIPTION	Headworks		

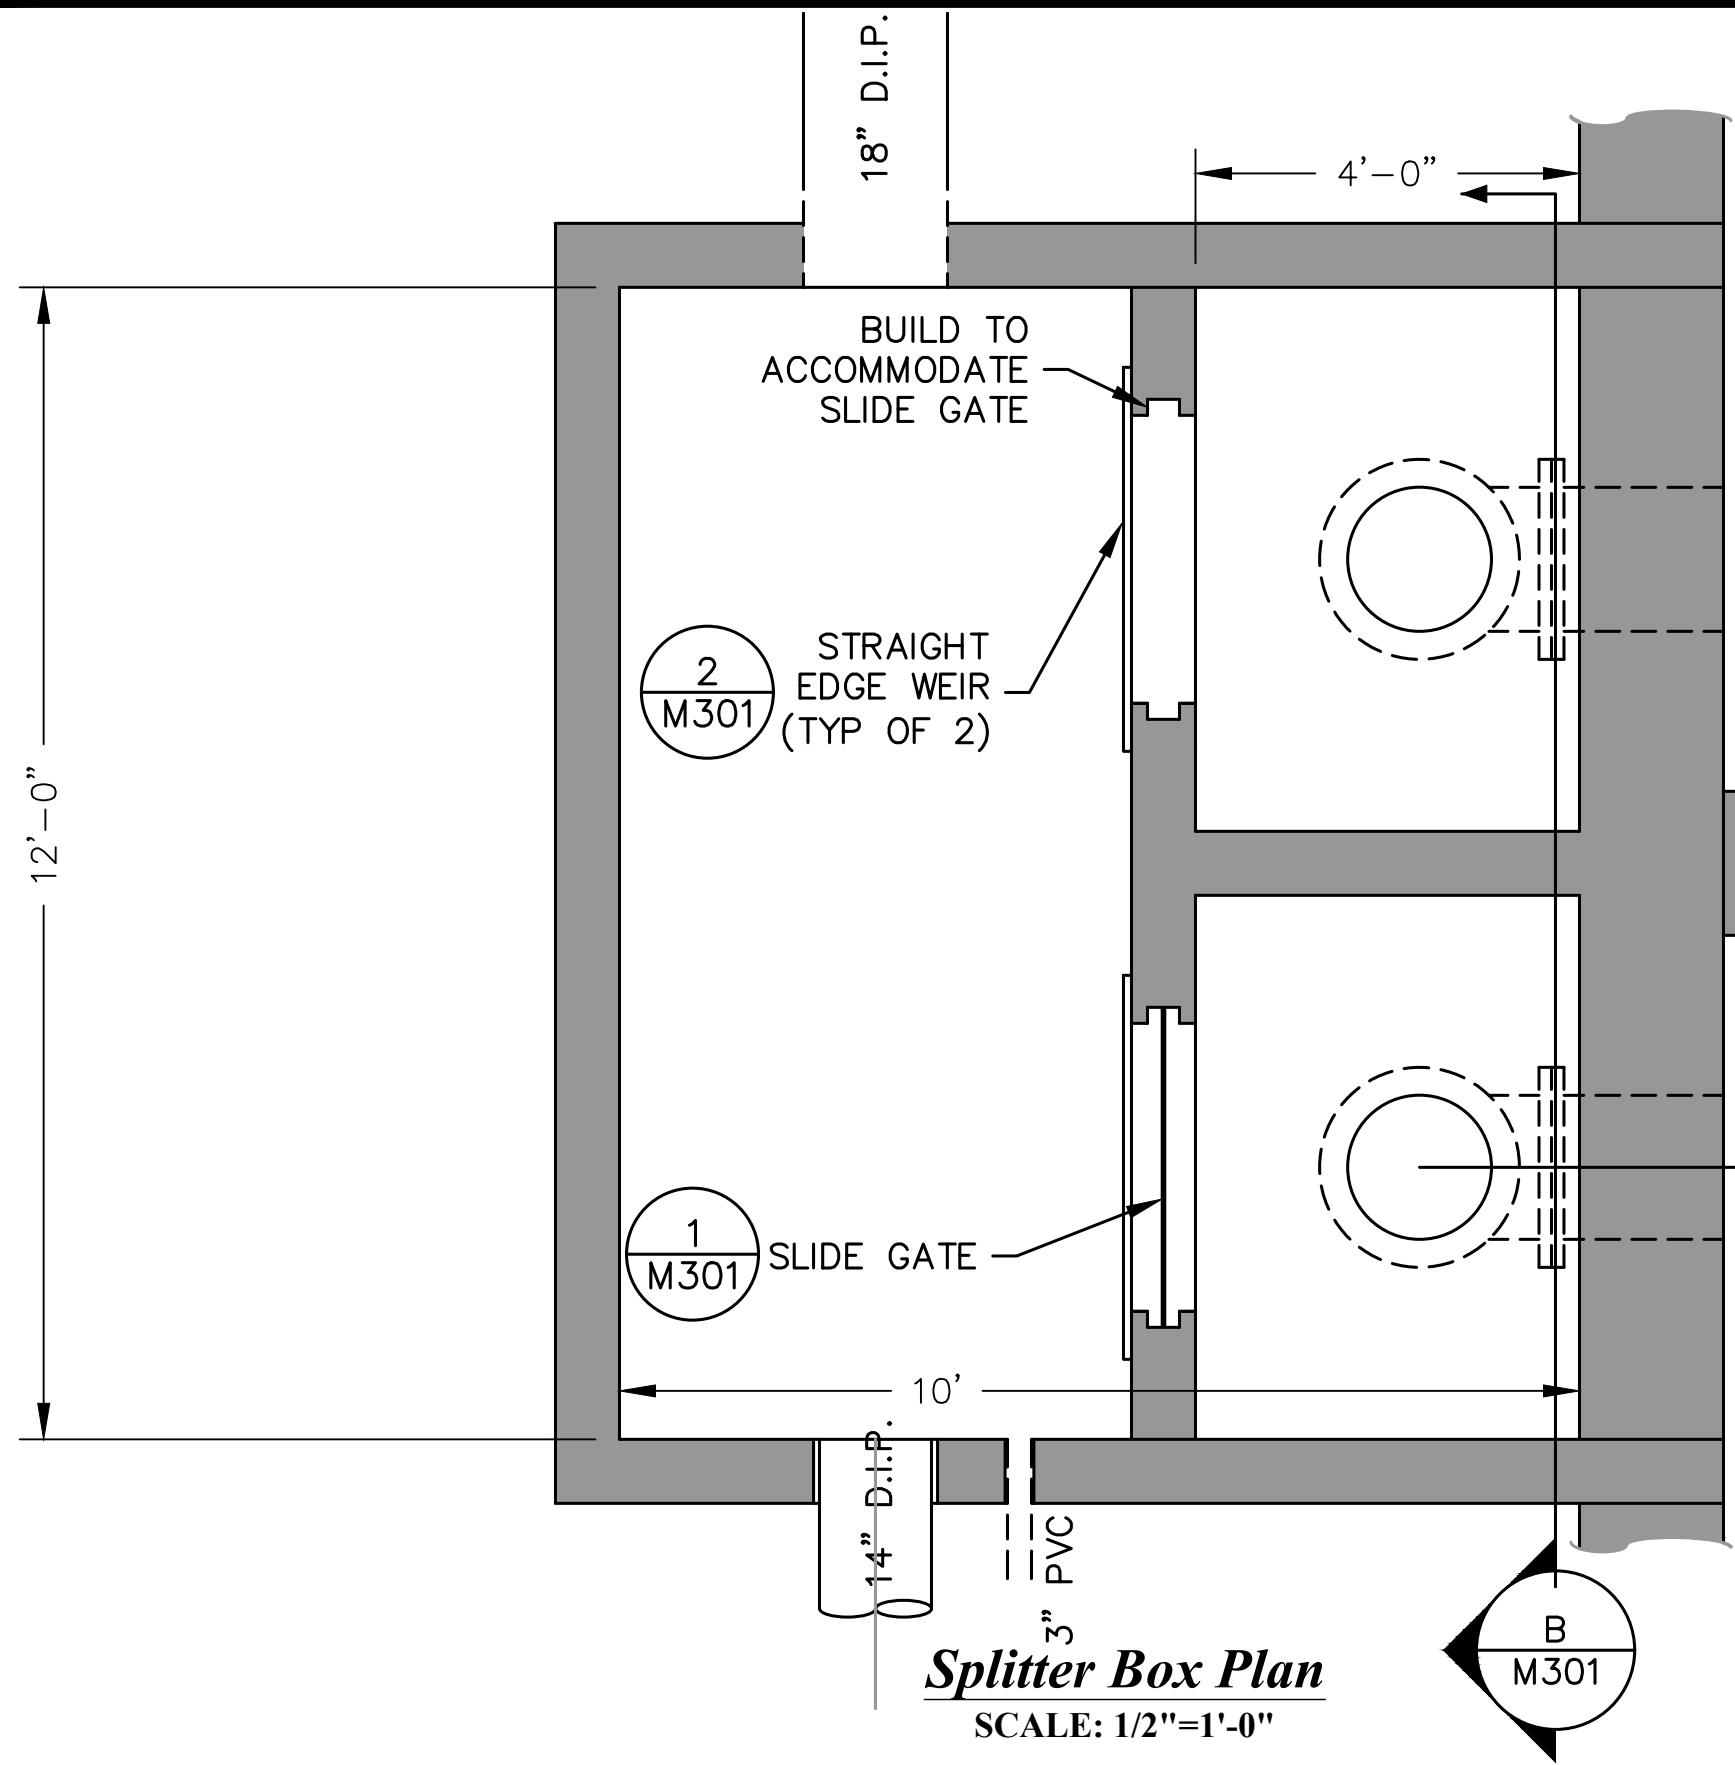


Splitter Box Plan

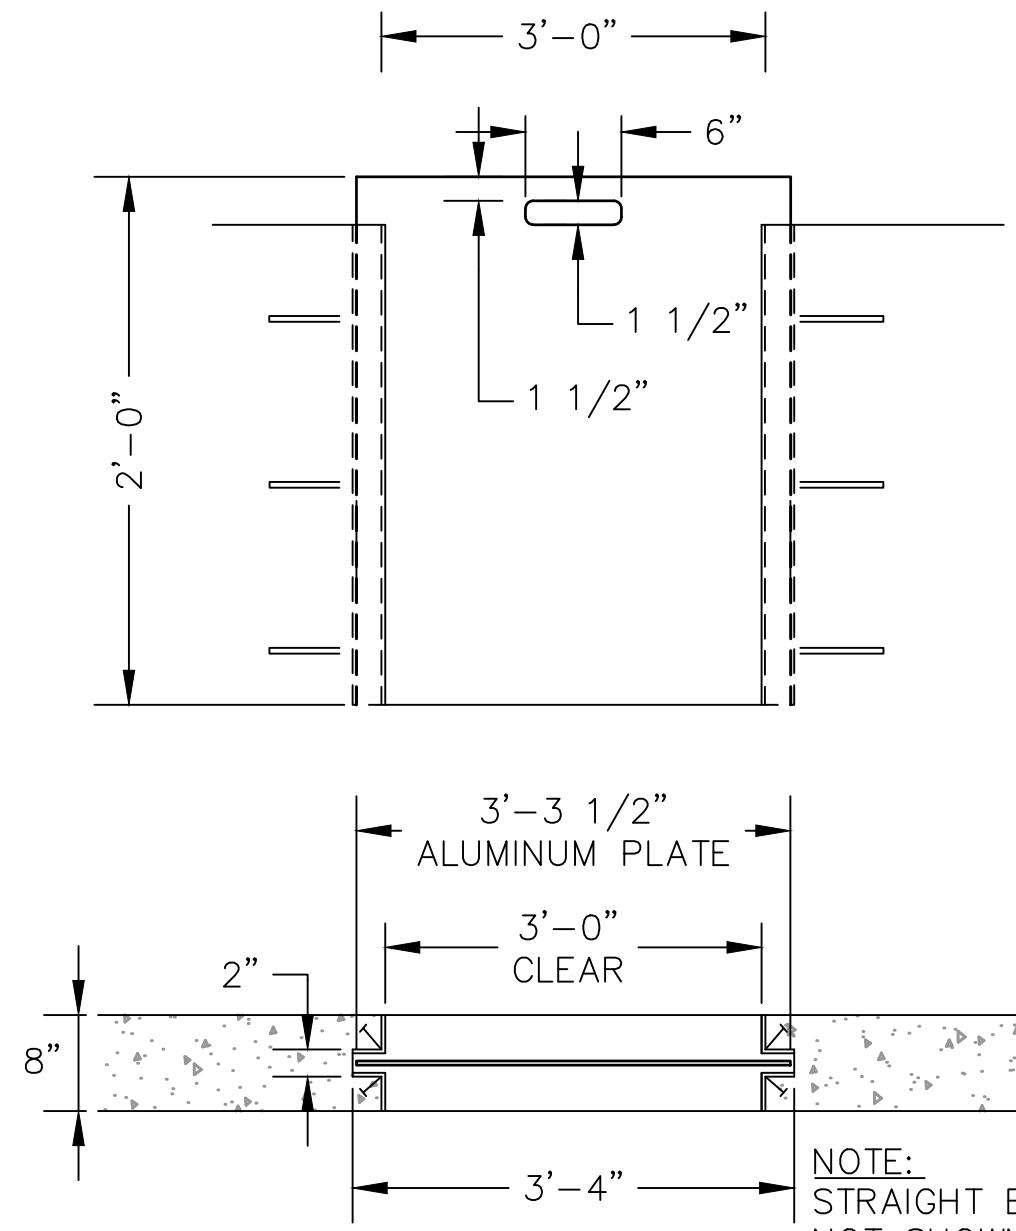


Slide Gate Detail
NOT TO SCALE

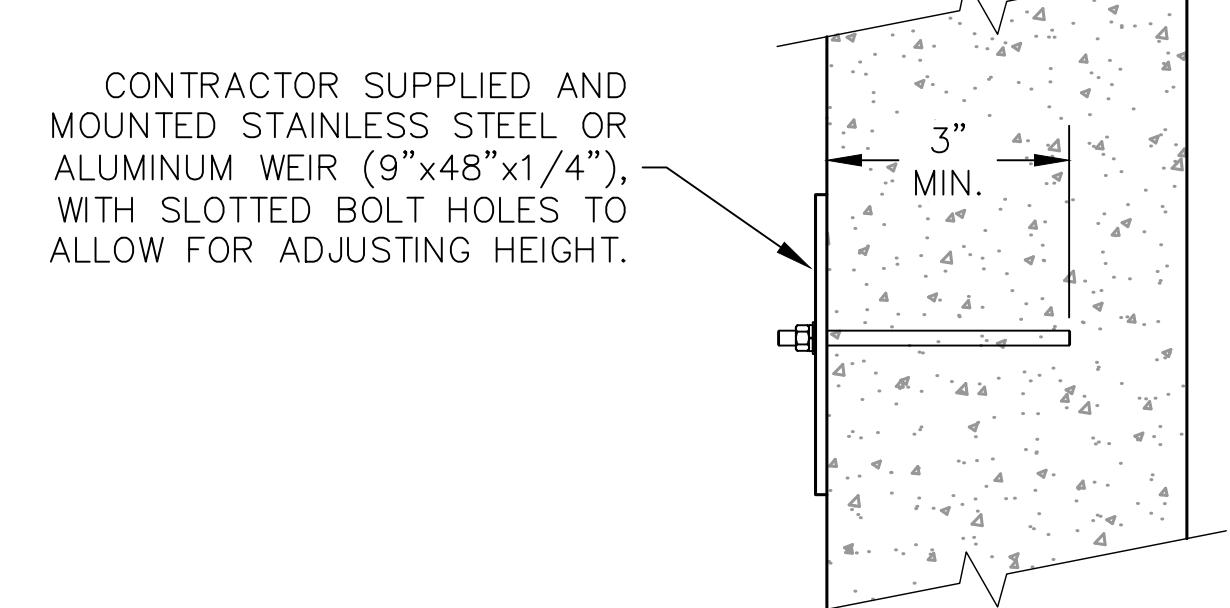

Straight Edge Weir Detail
NOT TO SCALE

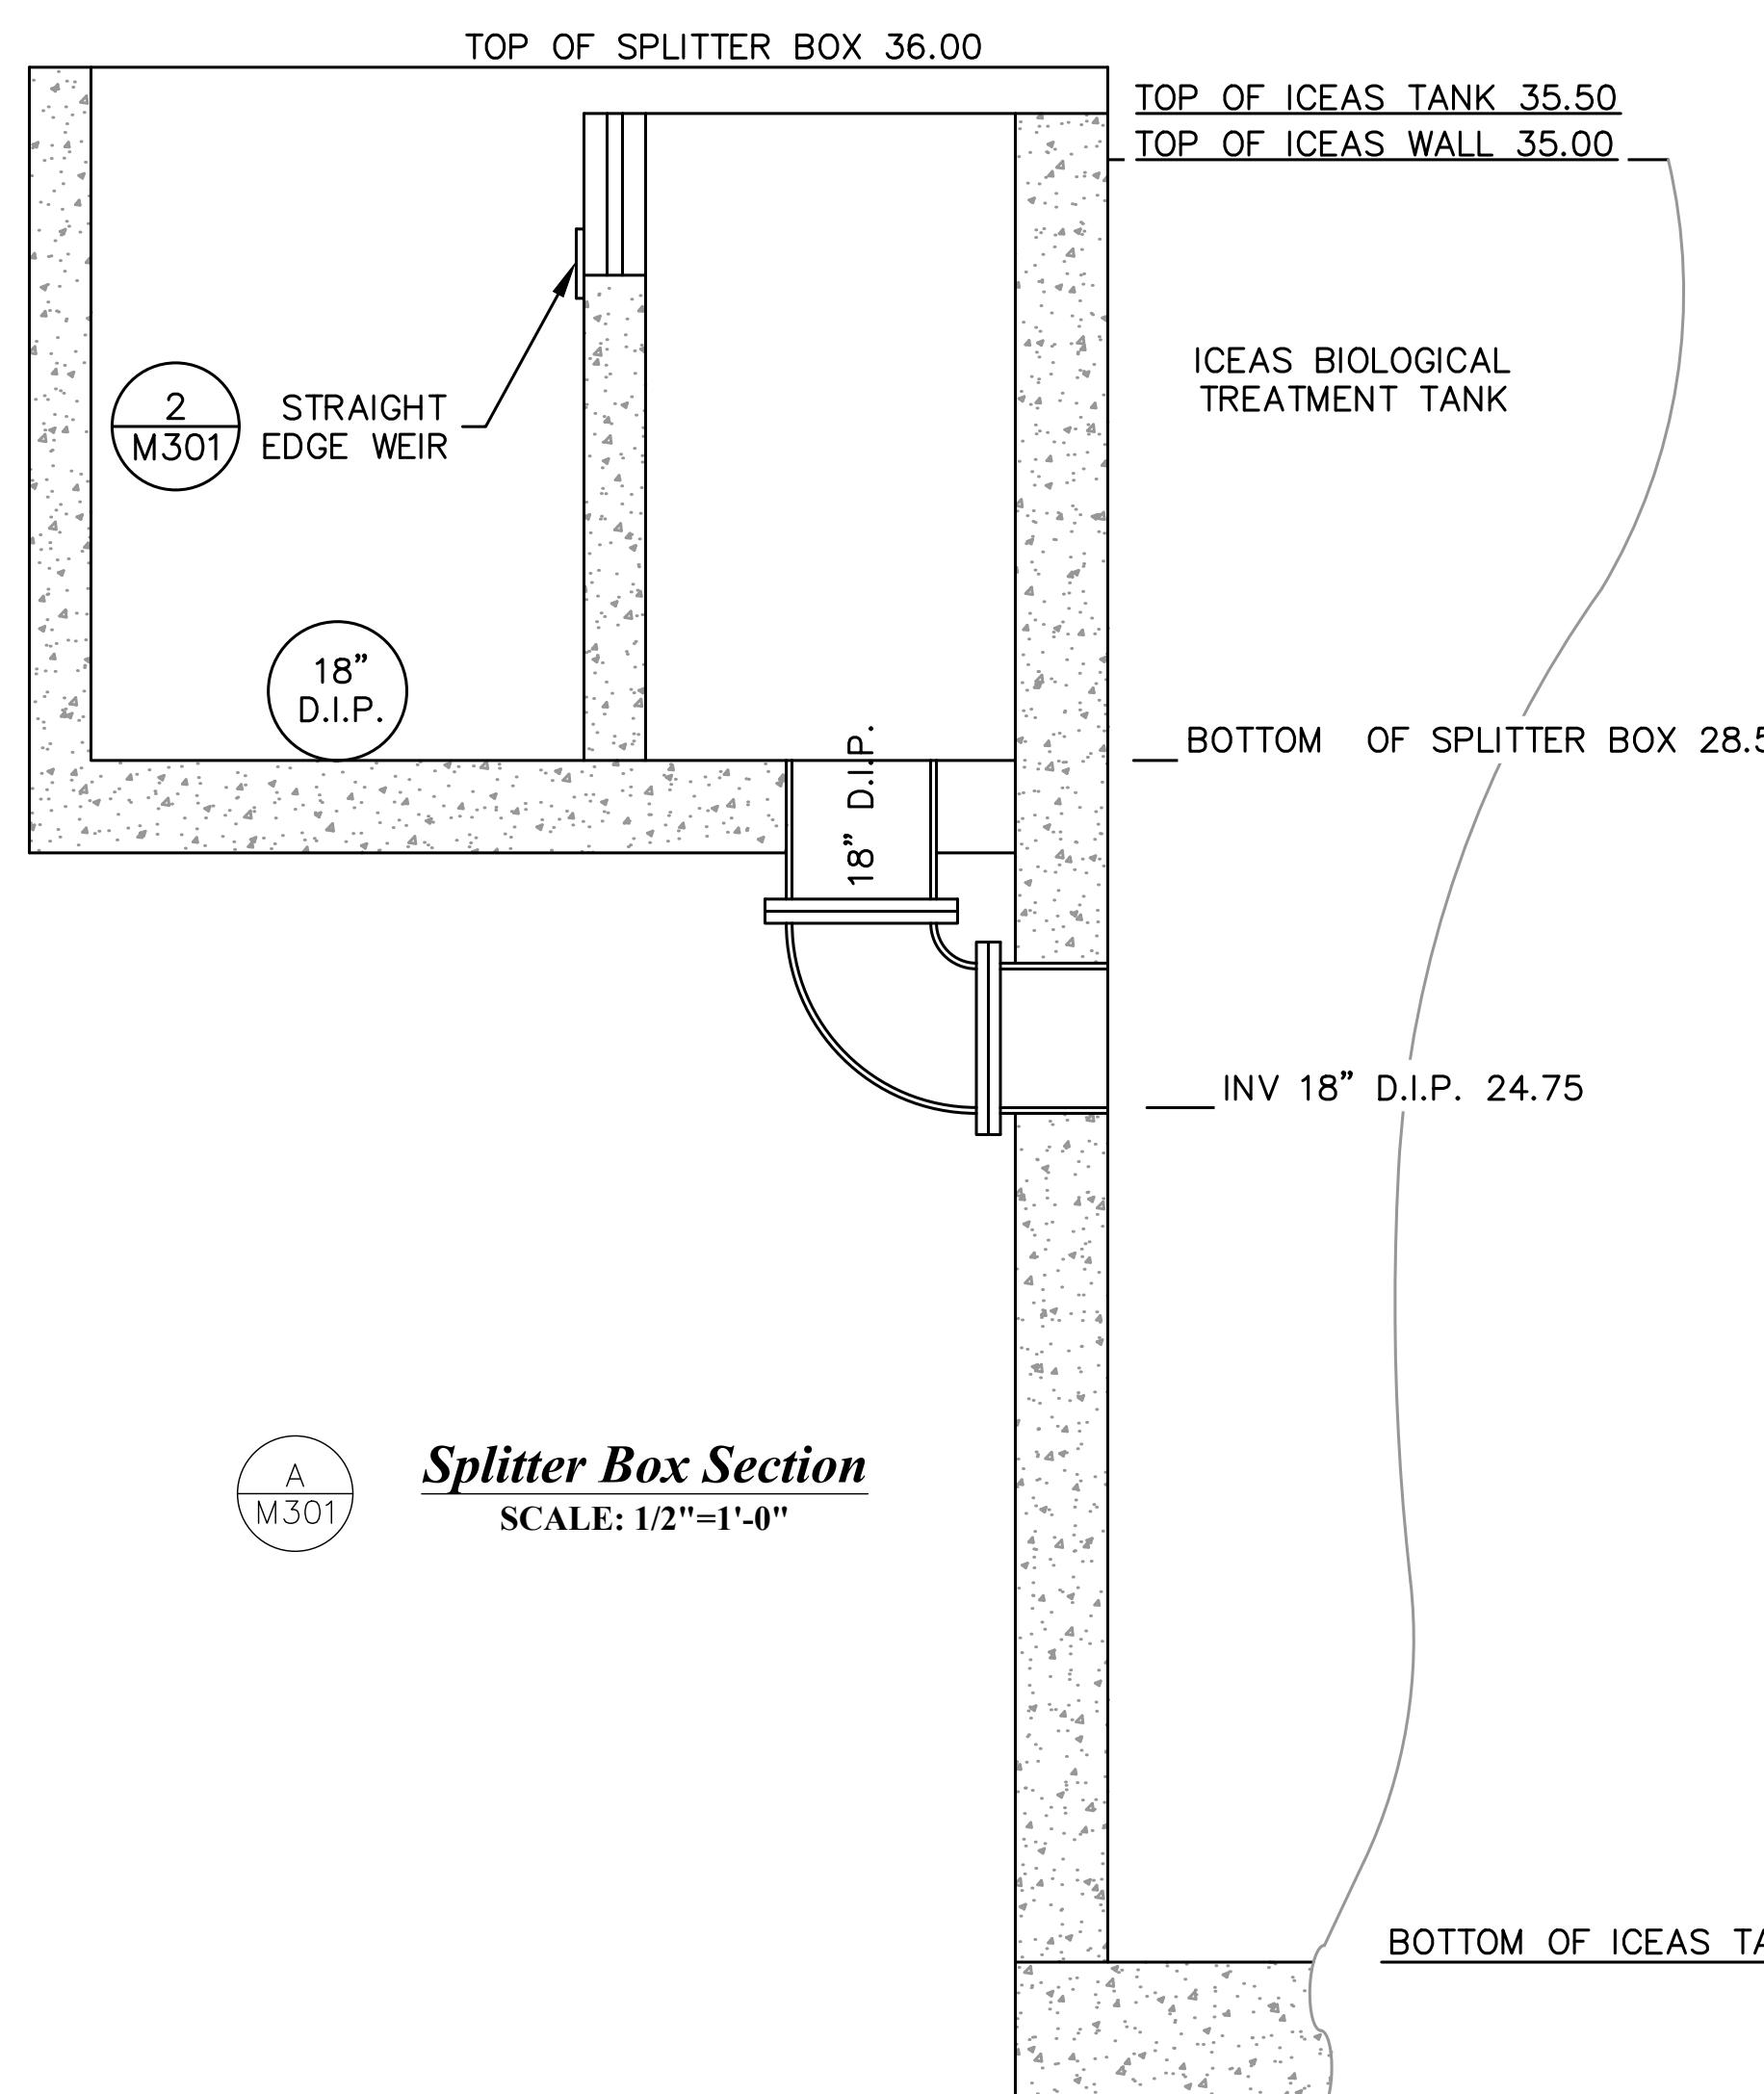

Splitter Box Section





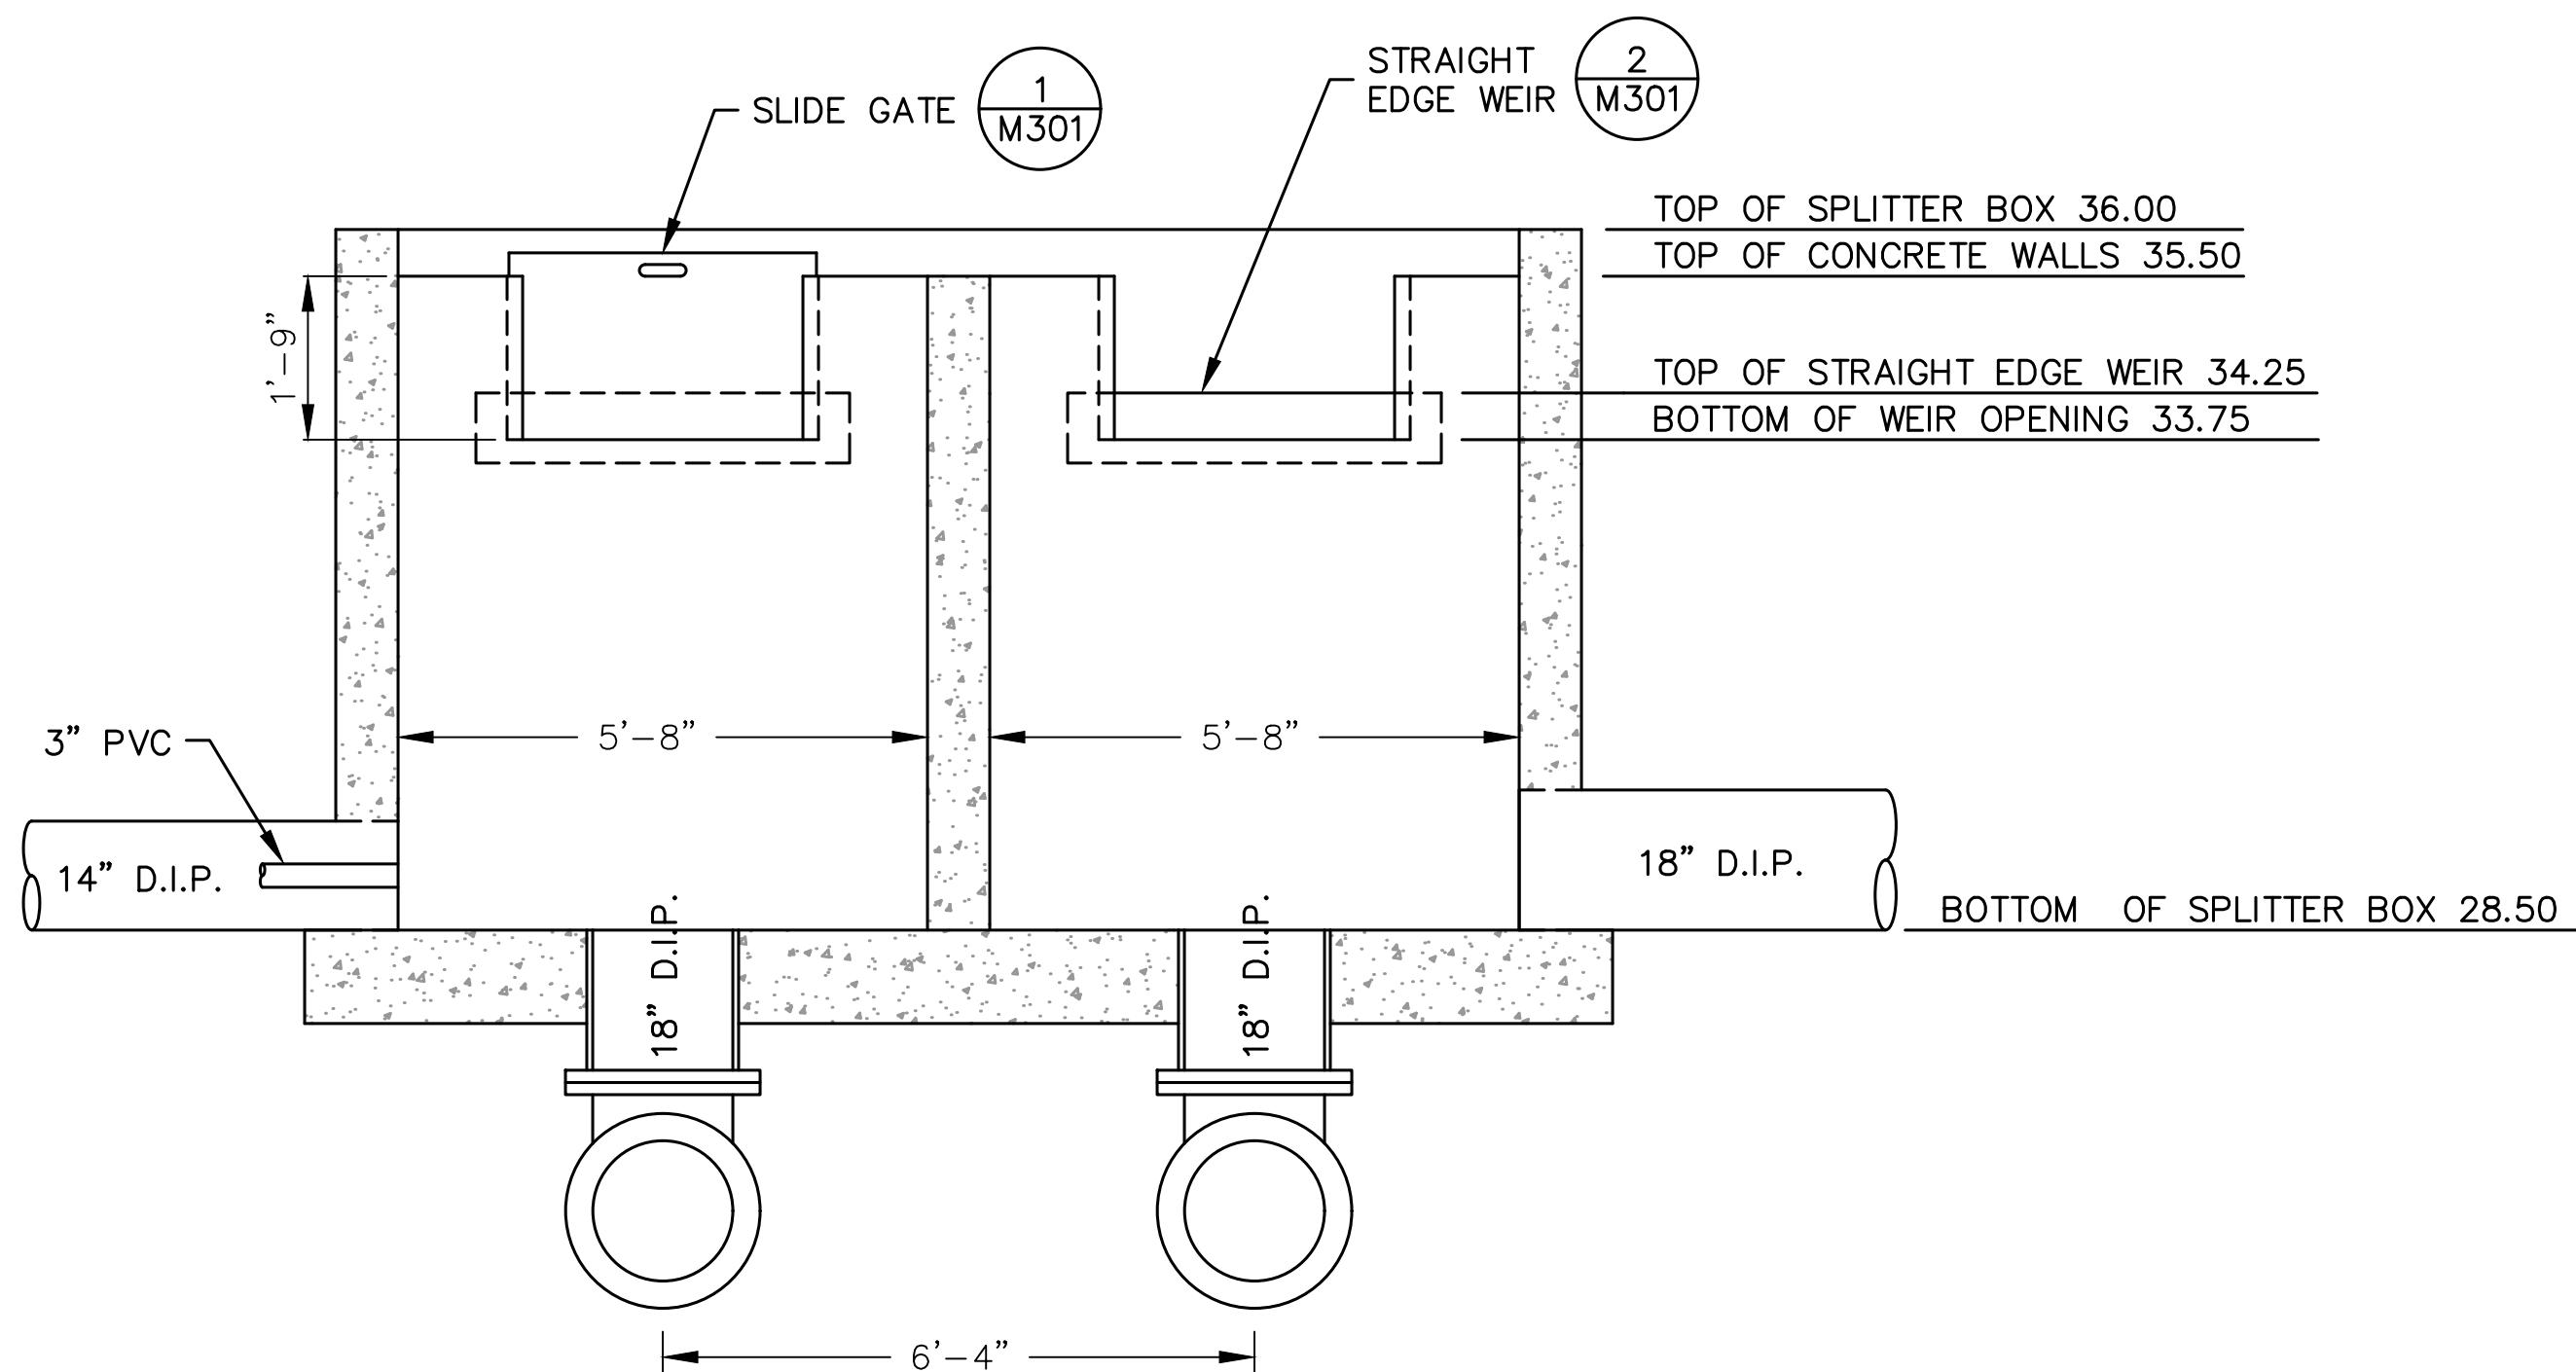



Splitter Box Section

1.2 PIPE FROM HEADWORKS RELOCATED

A graphic scale with tick marks every 1/2 inch. The scale starts at 1 and ends at 4. Below the scale, the text "GRAPHIC SCALE" is centered, and below that, "1/2"=1'-0"" is centered.

 DENOTES A CHANGE IN THE PLANS FROM THE ADDENDA
THE FIRST NUMBER REFERENCES THE ADDENDUM NUMBER WHILE
THE SECOND NUMBER REFERENCES THE ADDENDUM ITEM NUMBER

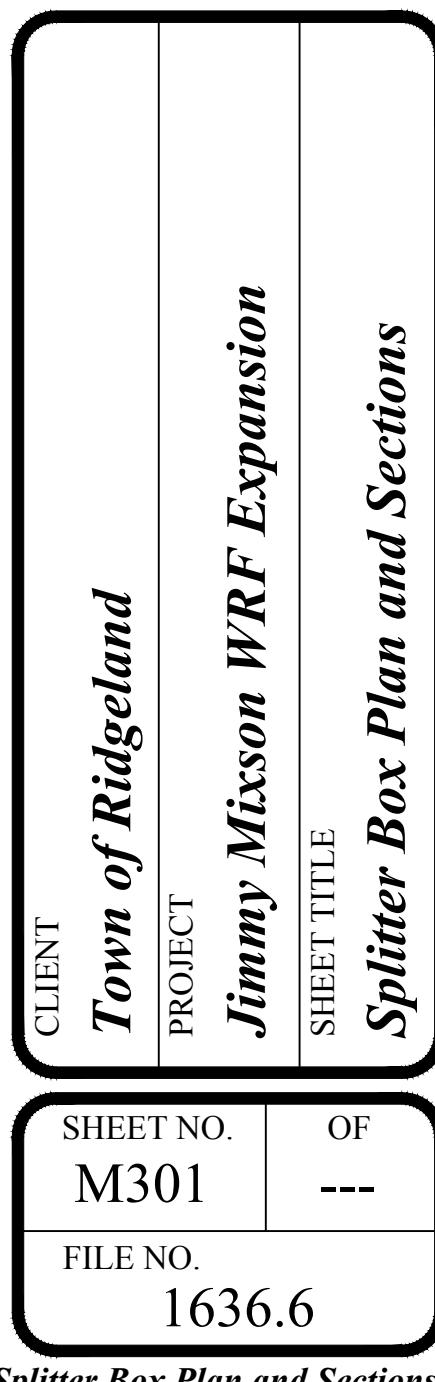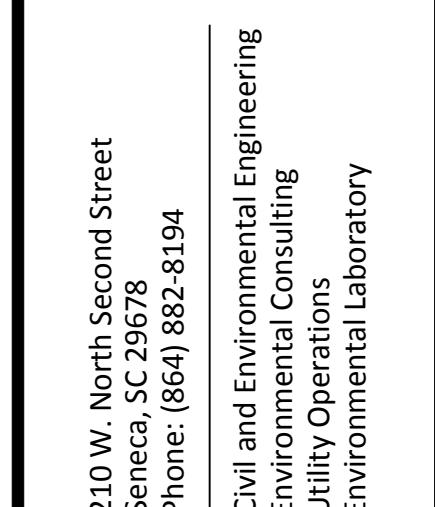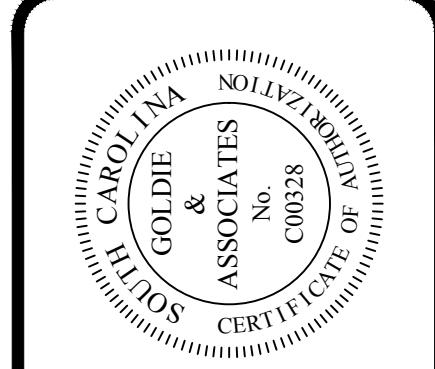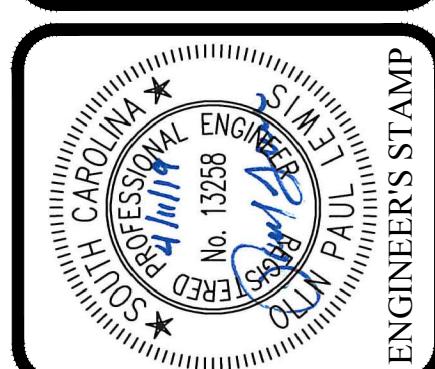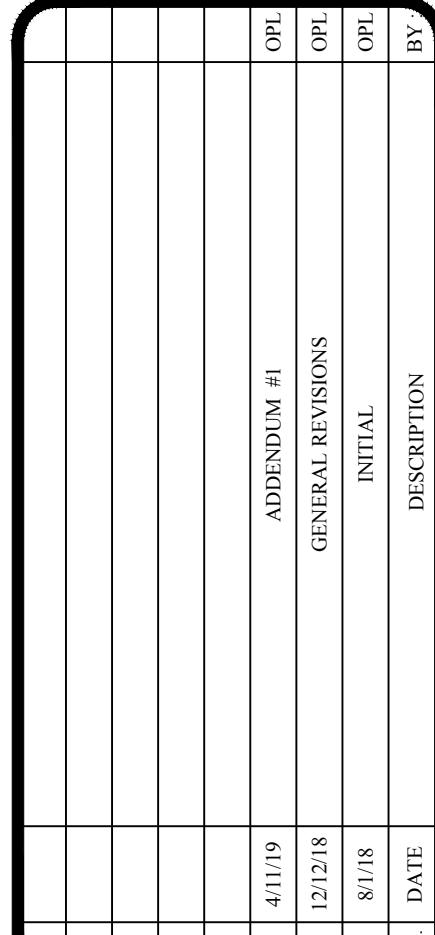


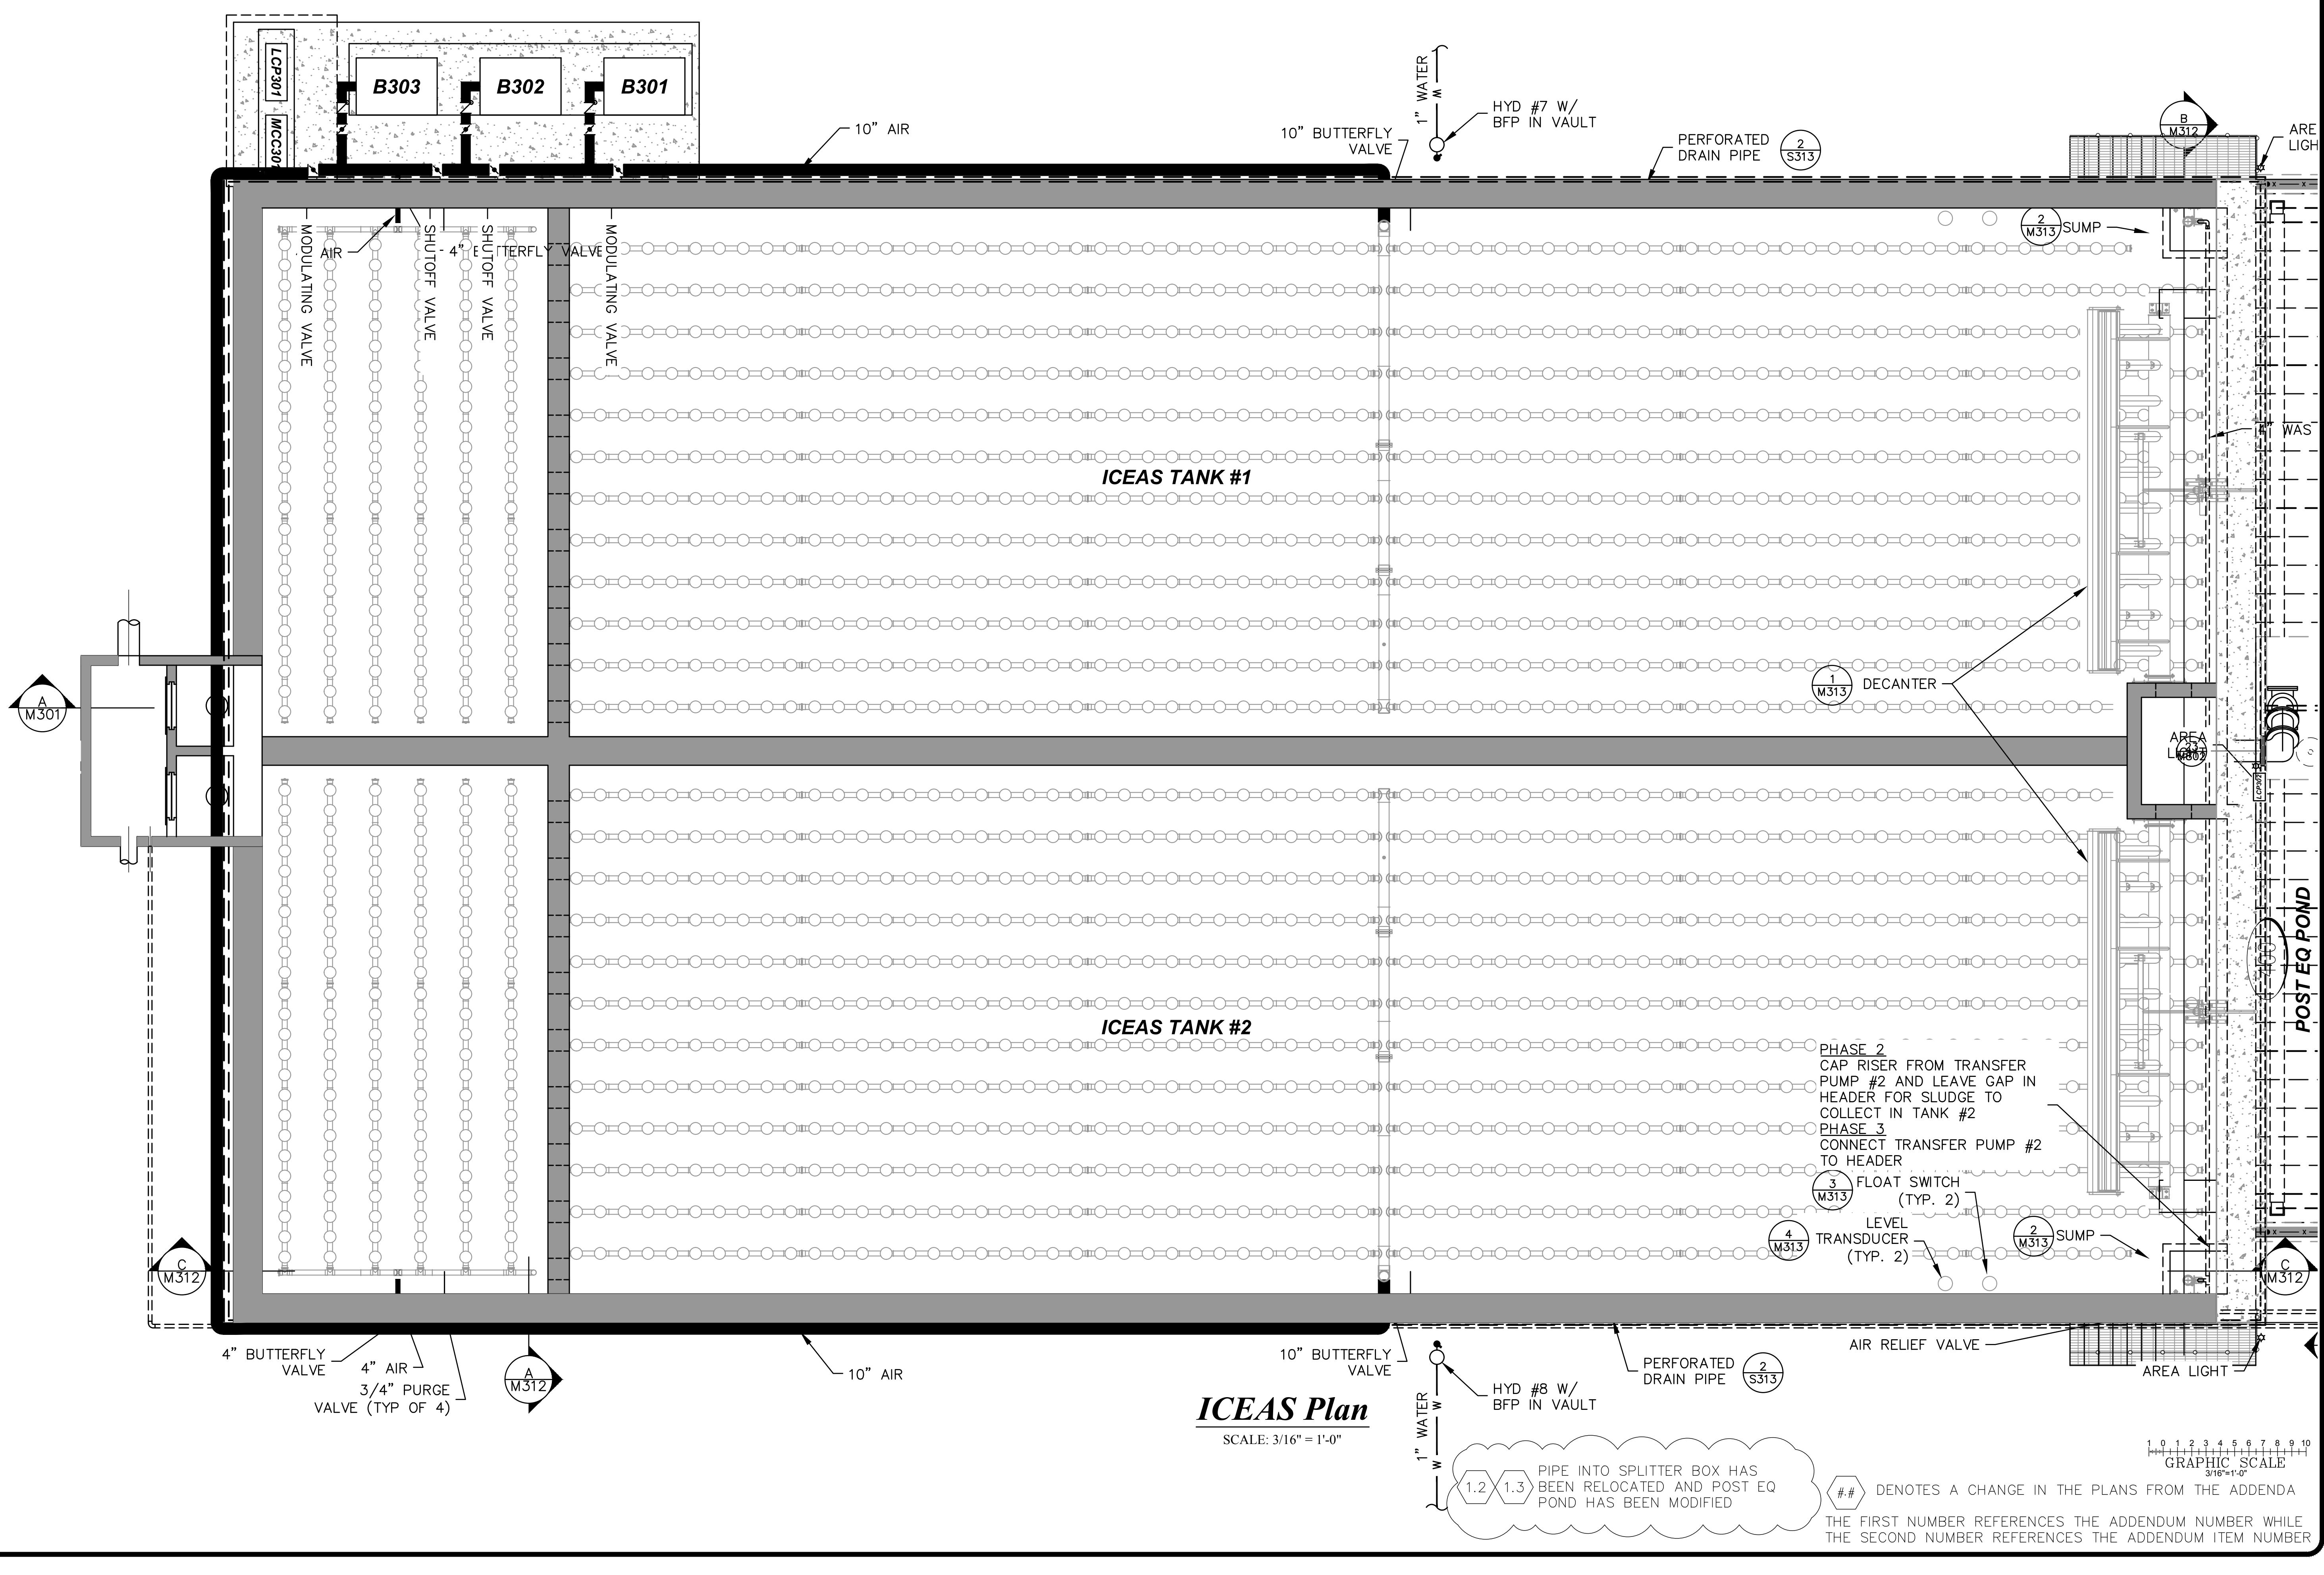




CLIENT: **Town of Ridgeland**
PROJECT: **Jimmy Mixson WRF Expansion**
SHEET TITLE: **ICEAS Tank Plan**




210 W. North Second Street
Seneca, SC 29678
Phone: (864) 882-8194
Civil and Environmental Engineering
Utility Operations
Environmental Laboratory
WE LISTEN. WE SERVE.
www.goldieassociates.com

ADDITIONAL #:	001
GENERAL Revision:	0
INITIAL:	0
DESCRIPTION:	BY

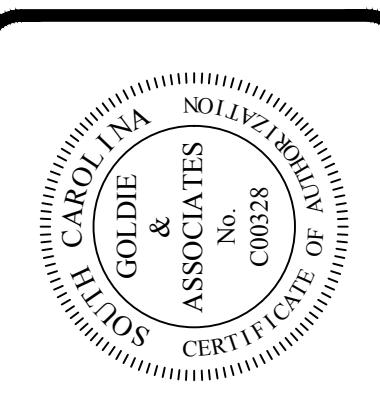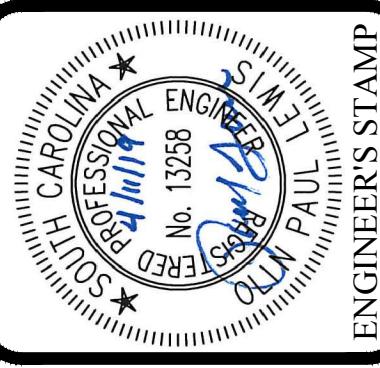

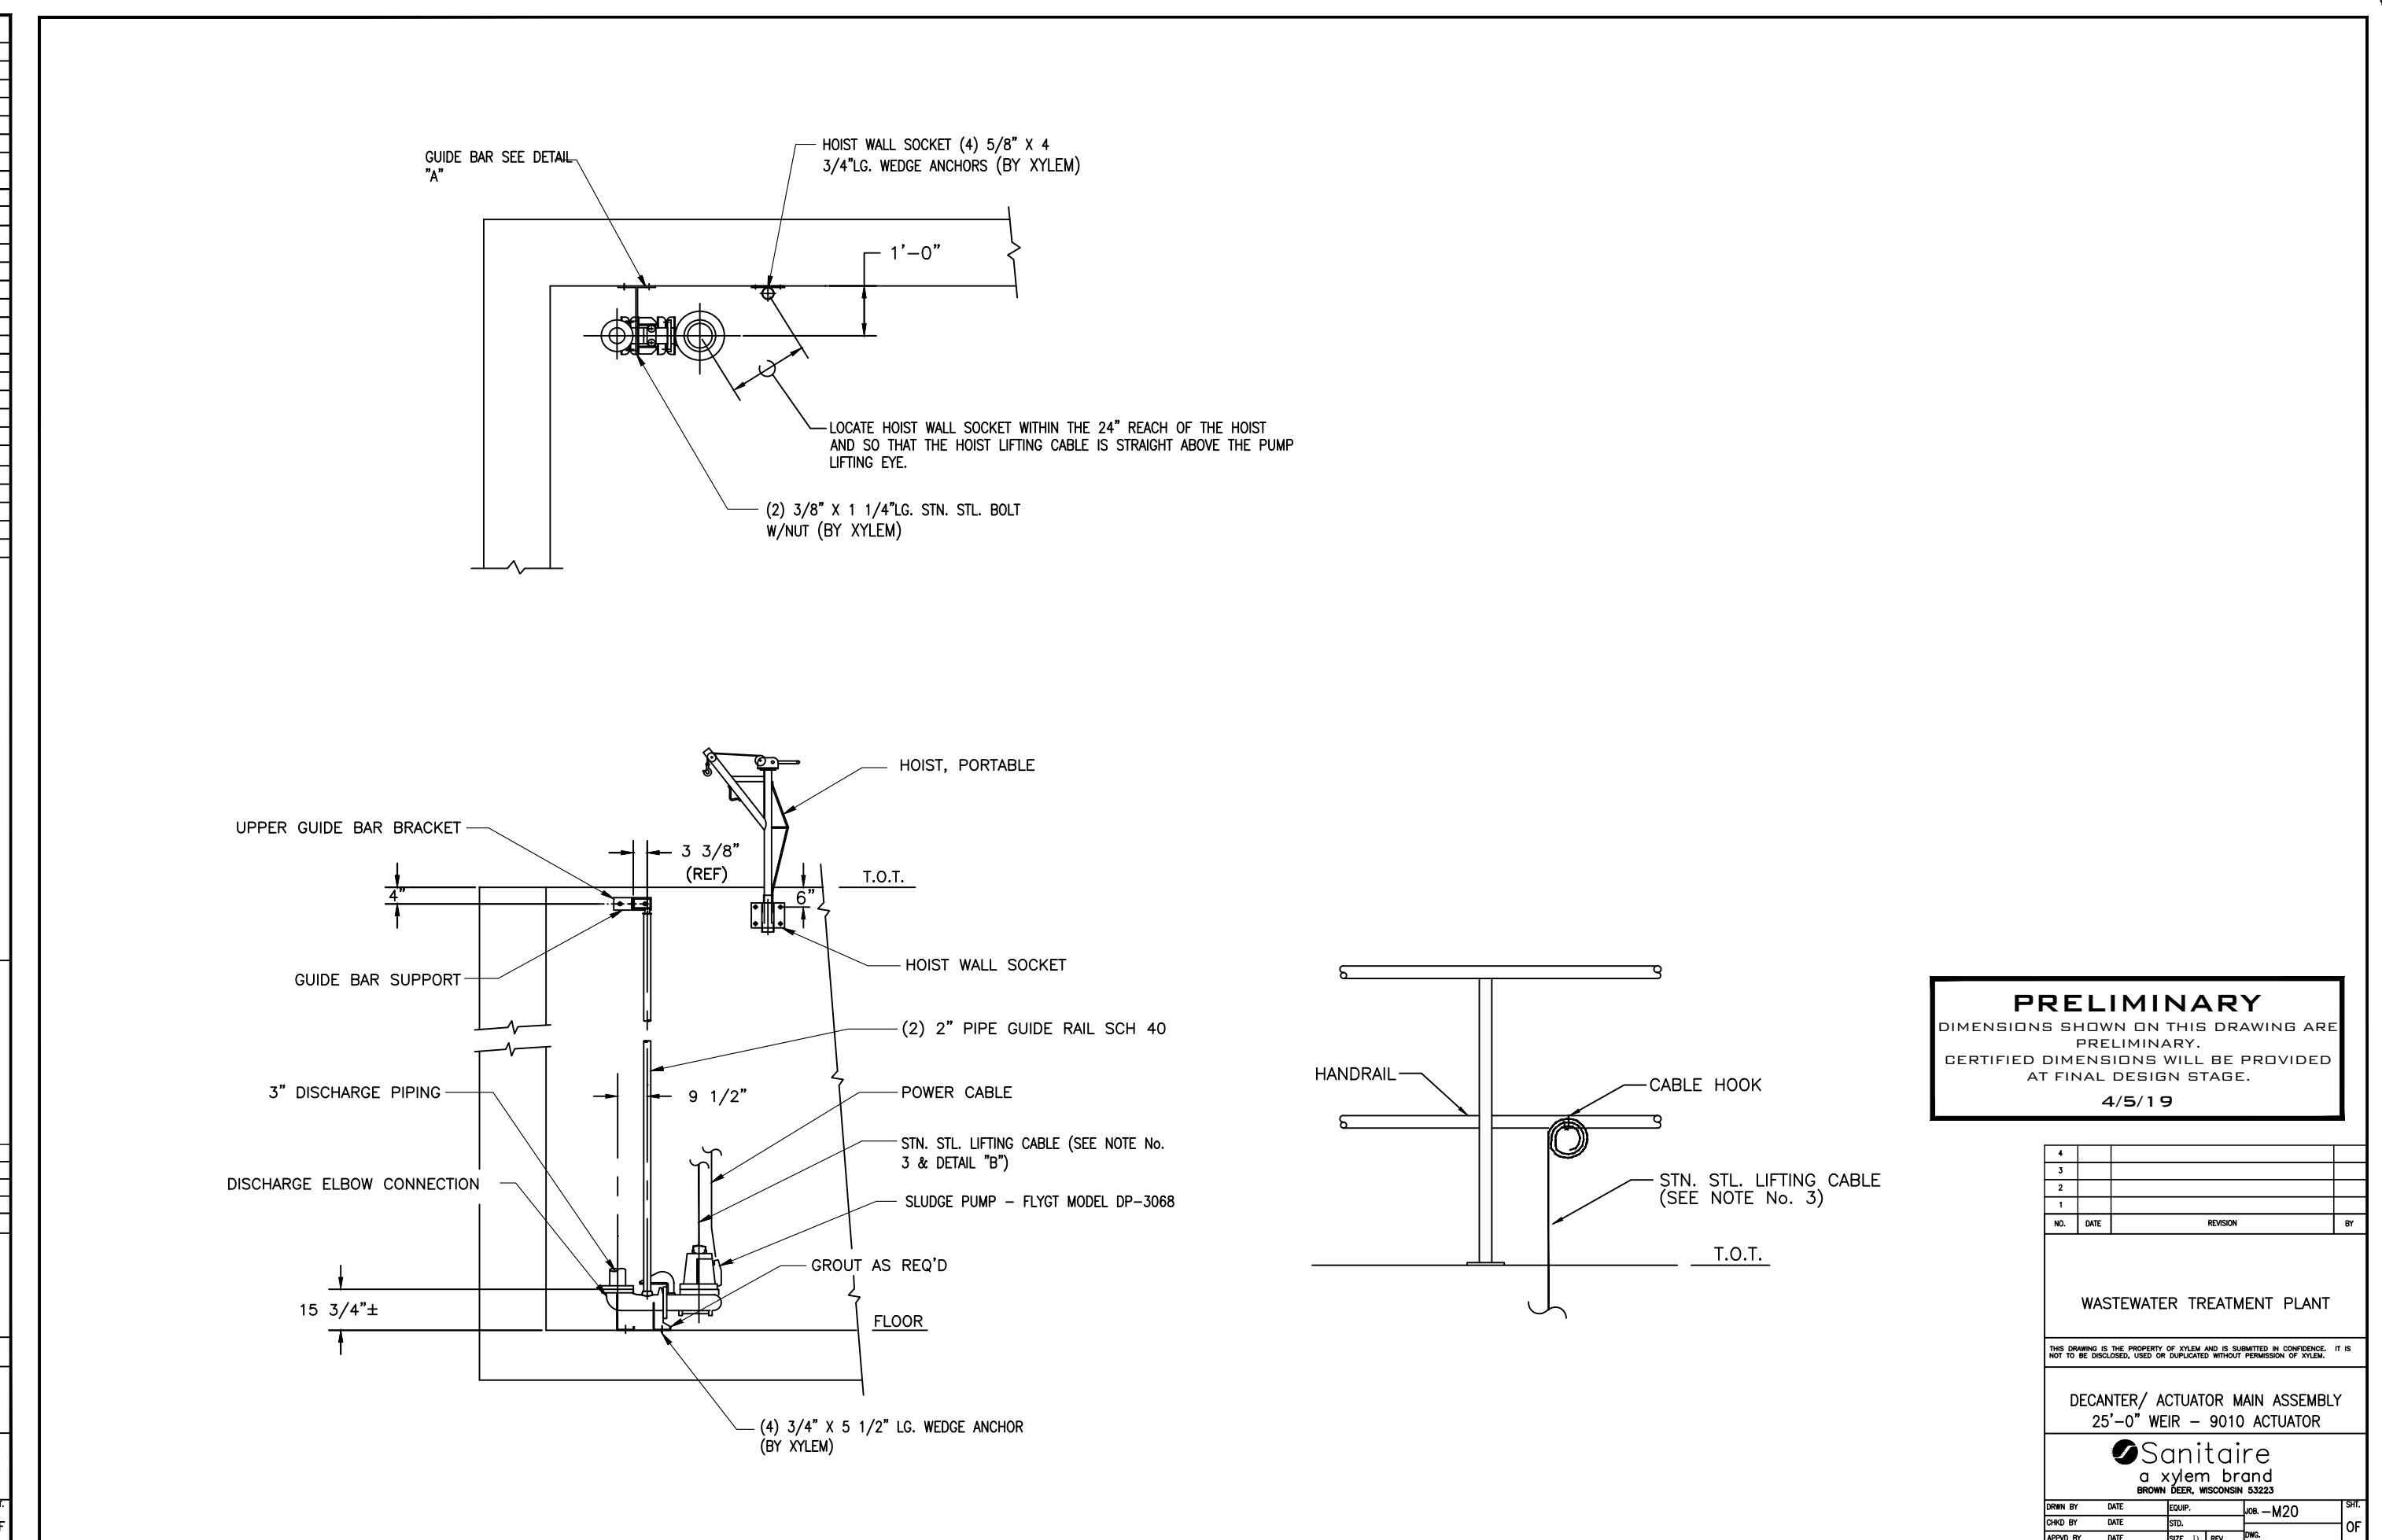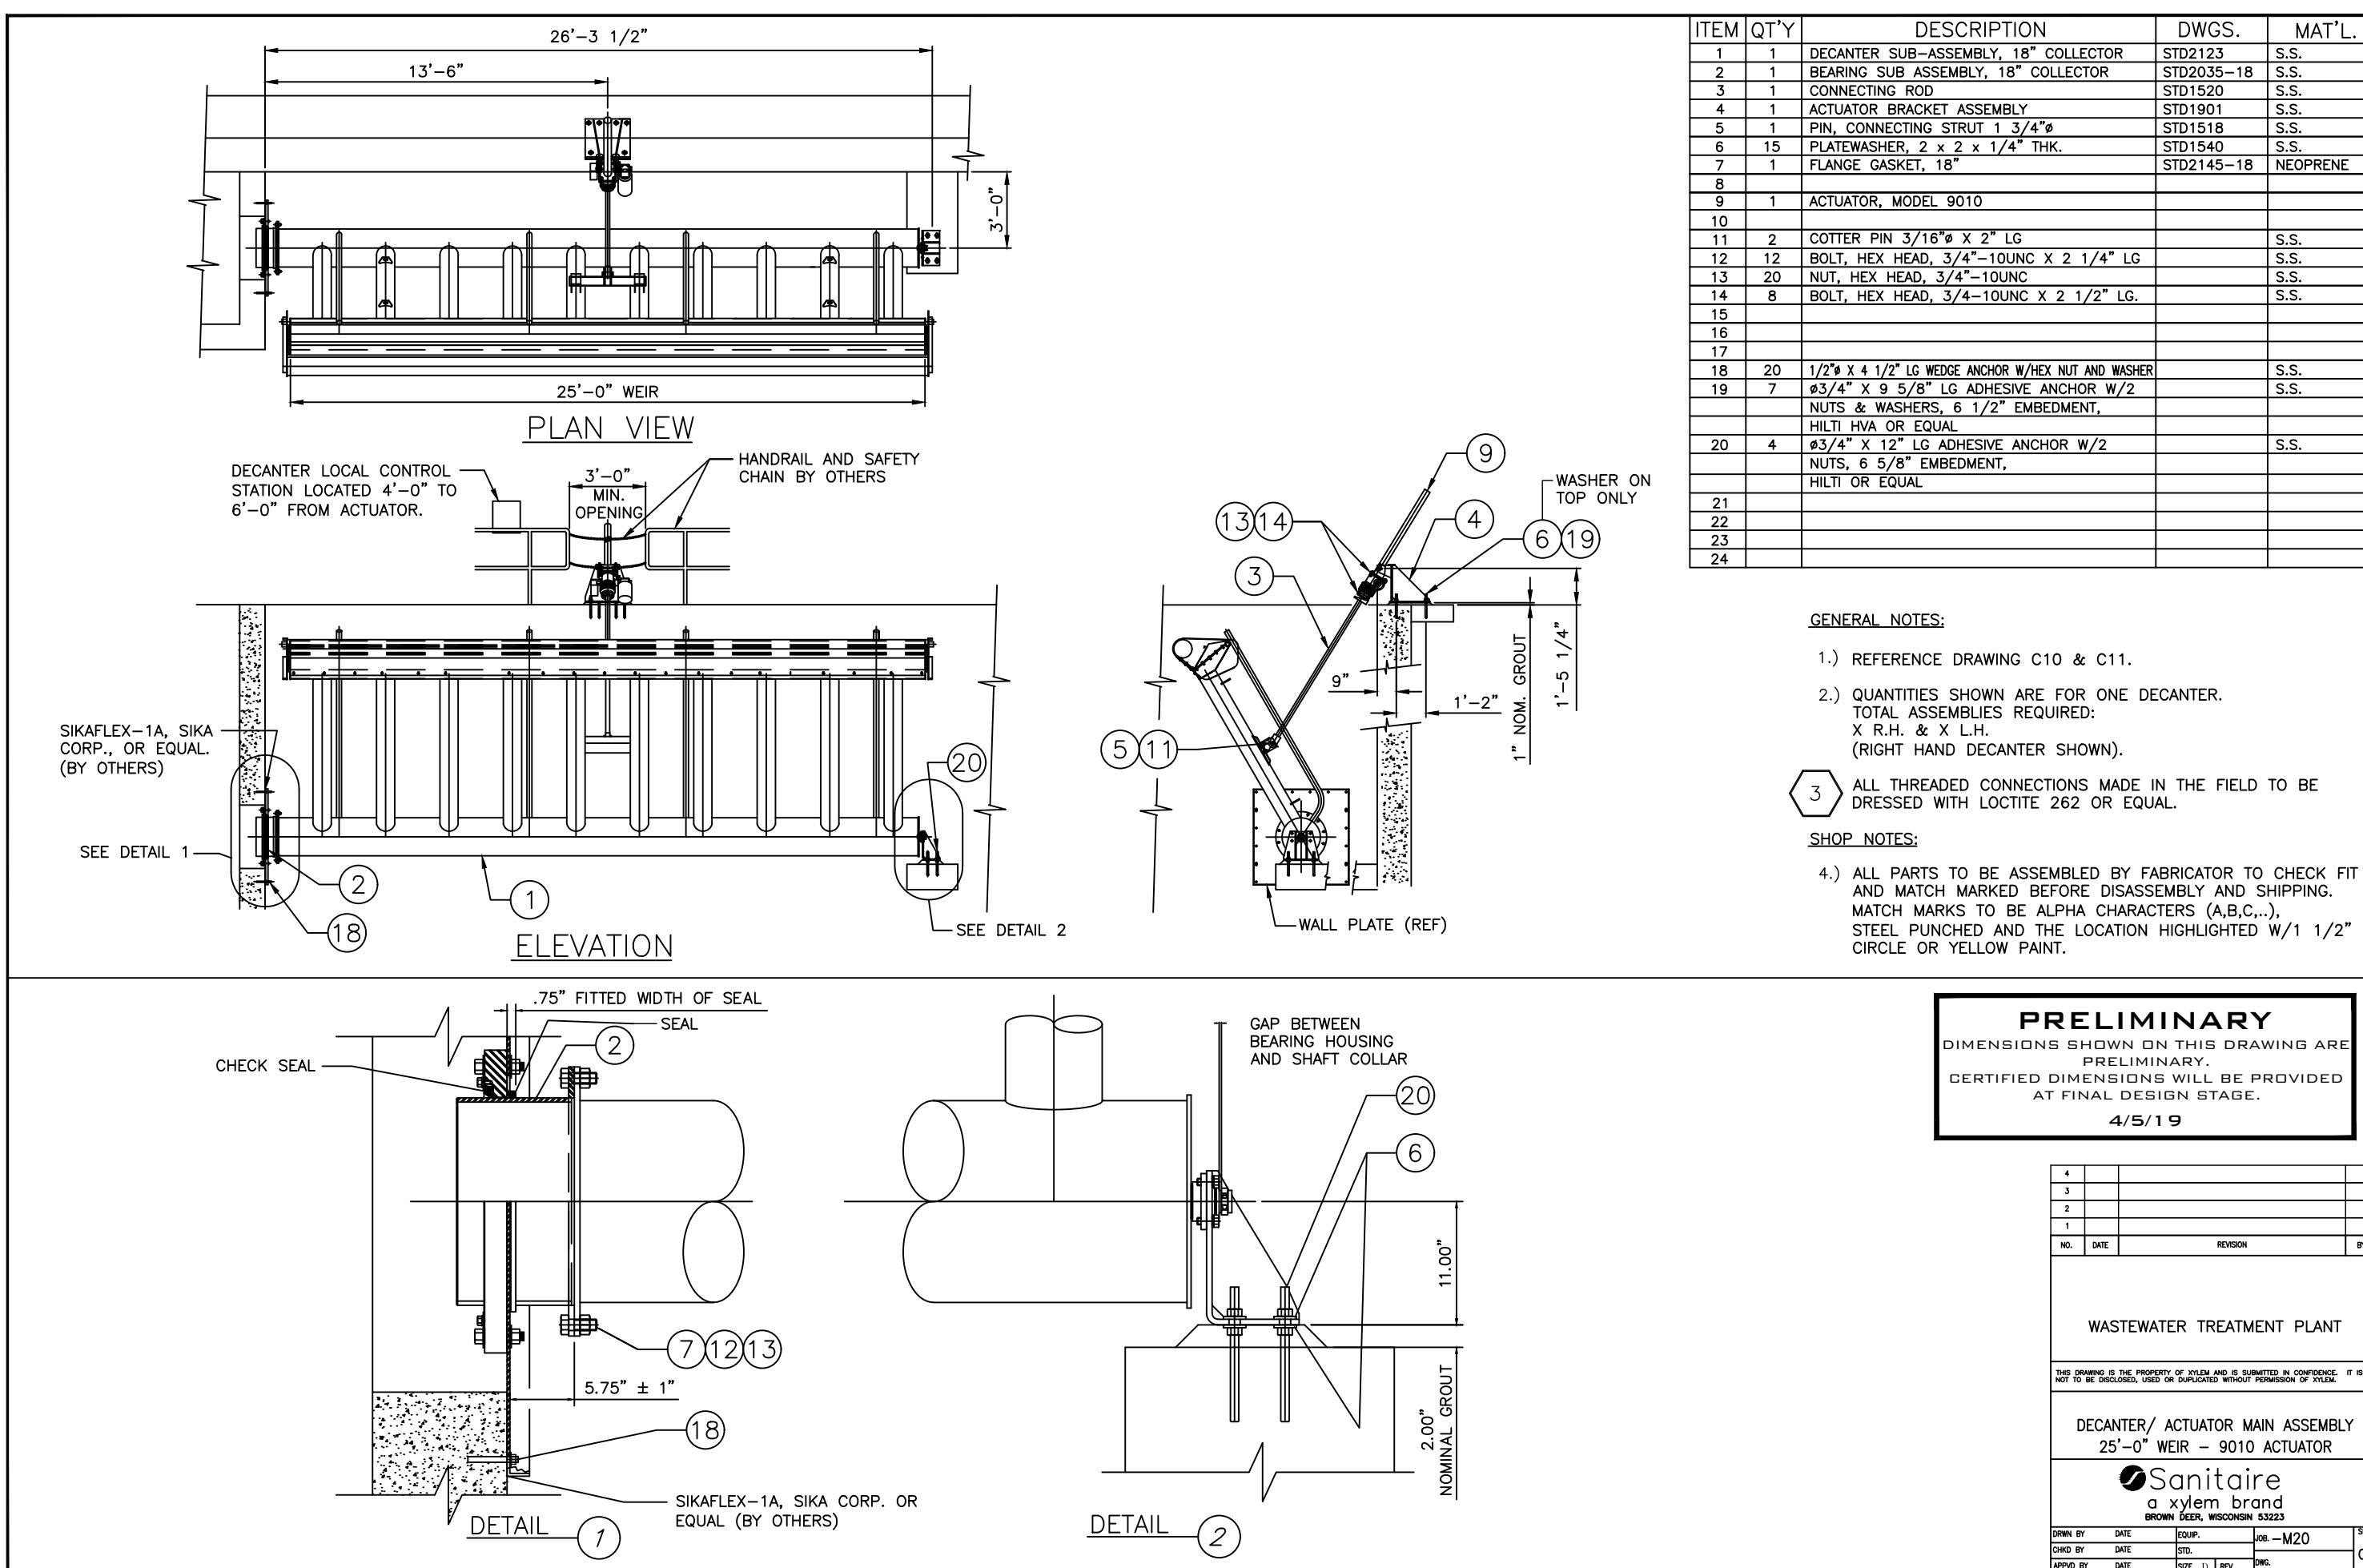

A diagram titled "Decanter Details" featuring two circles side-by-side. The left circle is labeled "M311" and the right circle is labeled "M312". Below the circles, the text "Not to Scale" is written.

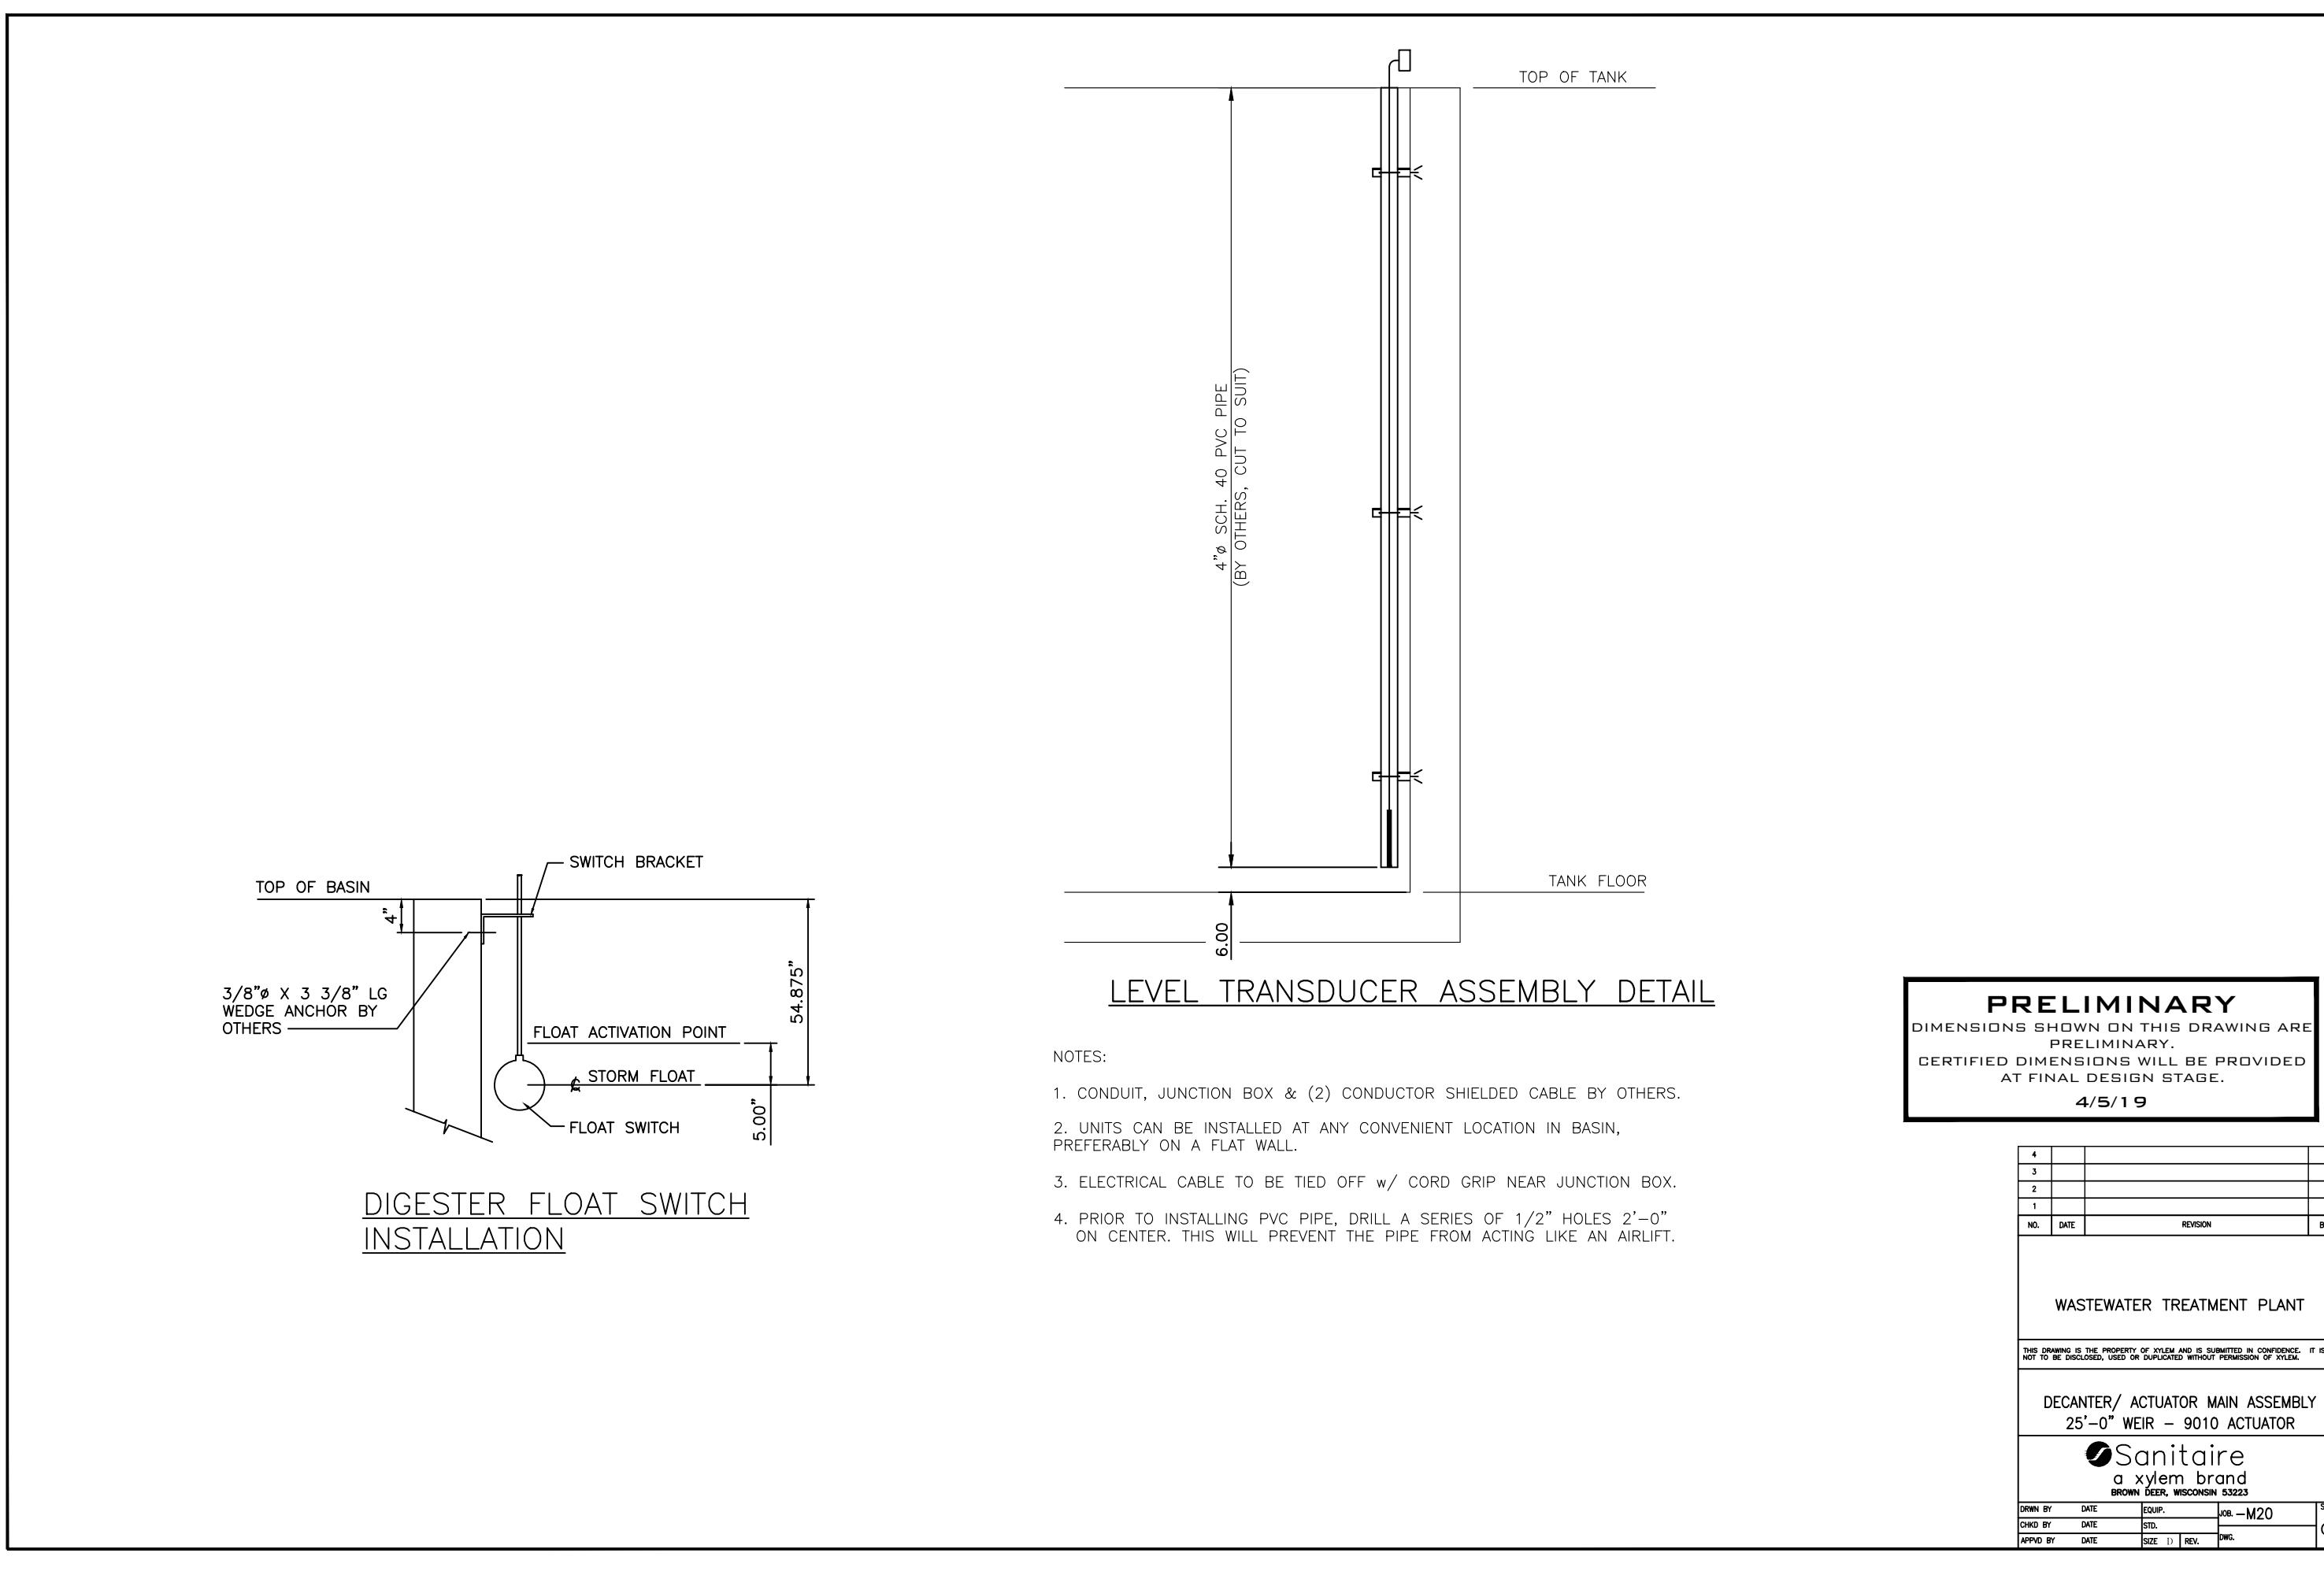


mp Pump Details

Not to Scale






{ 1.14 POOR QUALITY IMAGES REPLACED WITH BETTER QUALITY ONES }

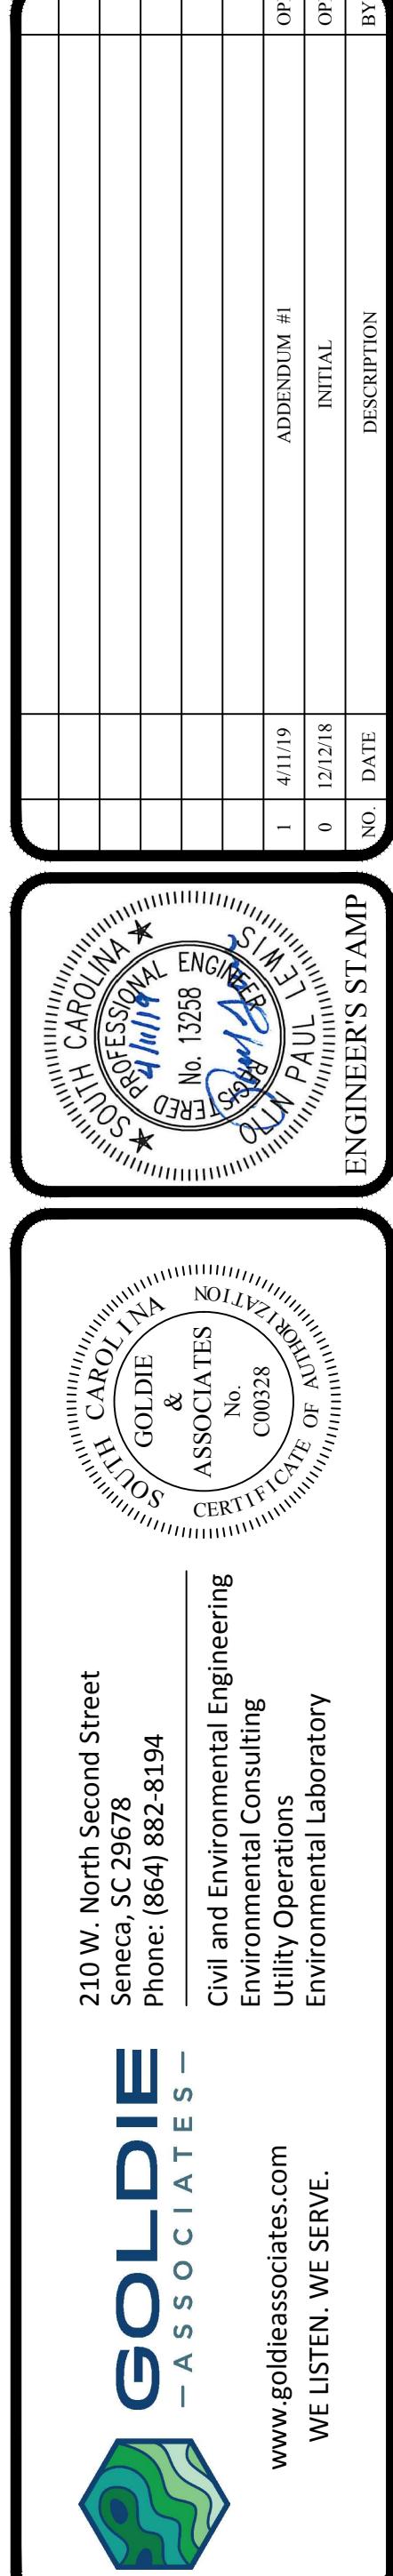



CLIENT CD:1 1

Vizman Mission WINE Estate

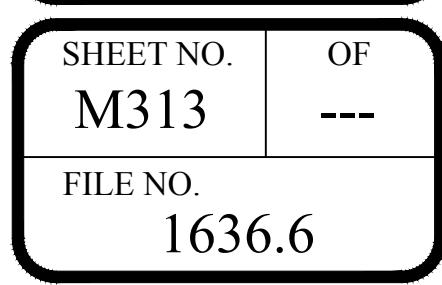


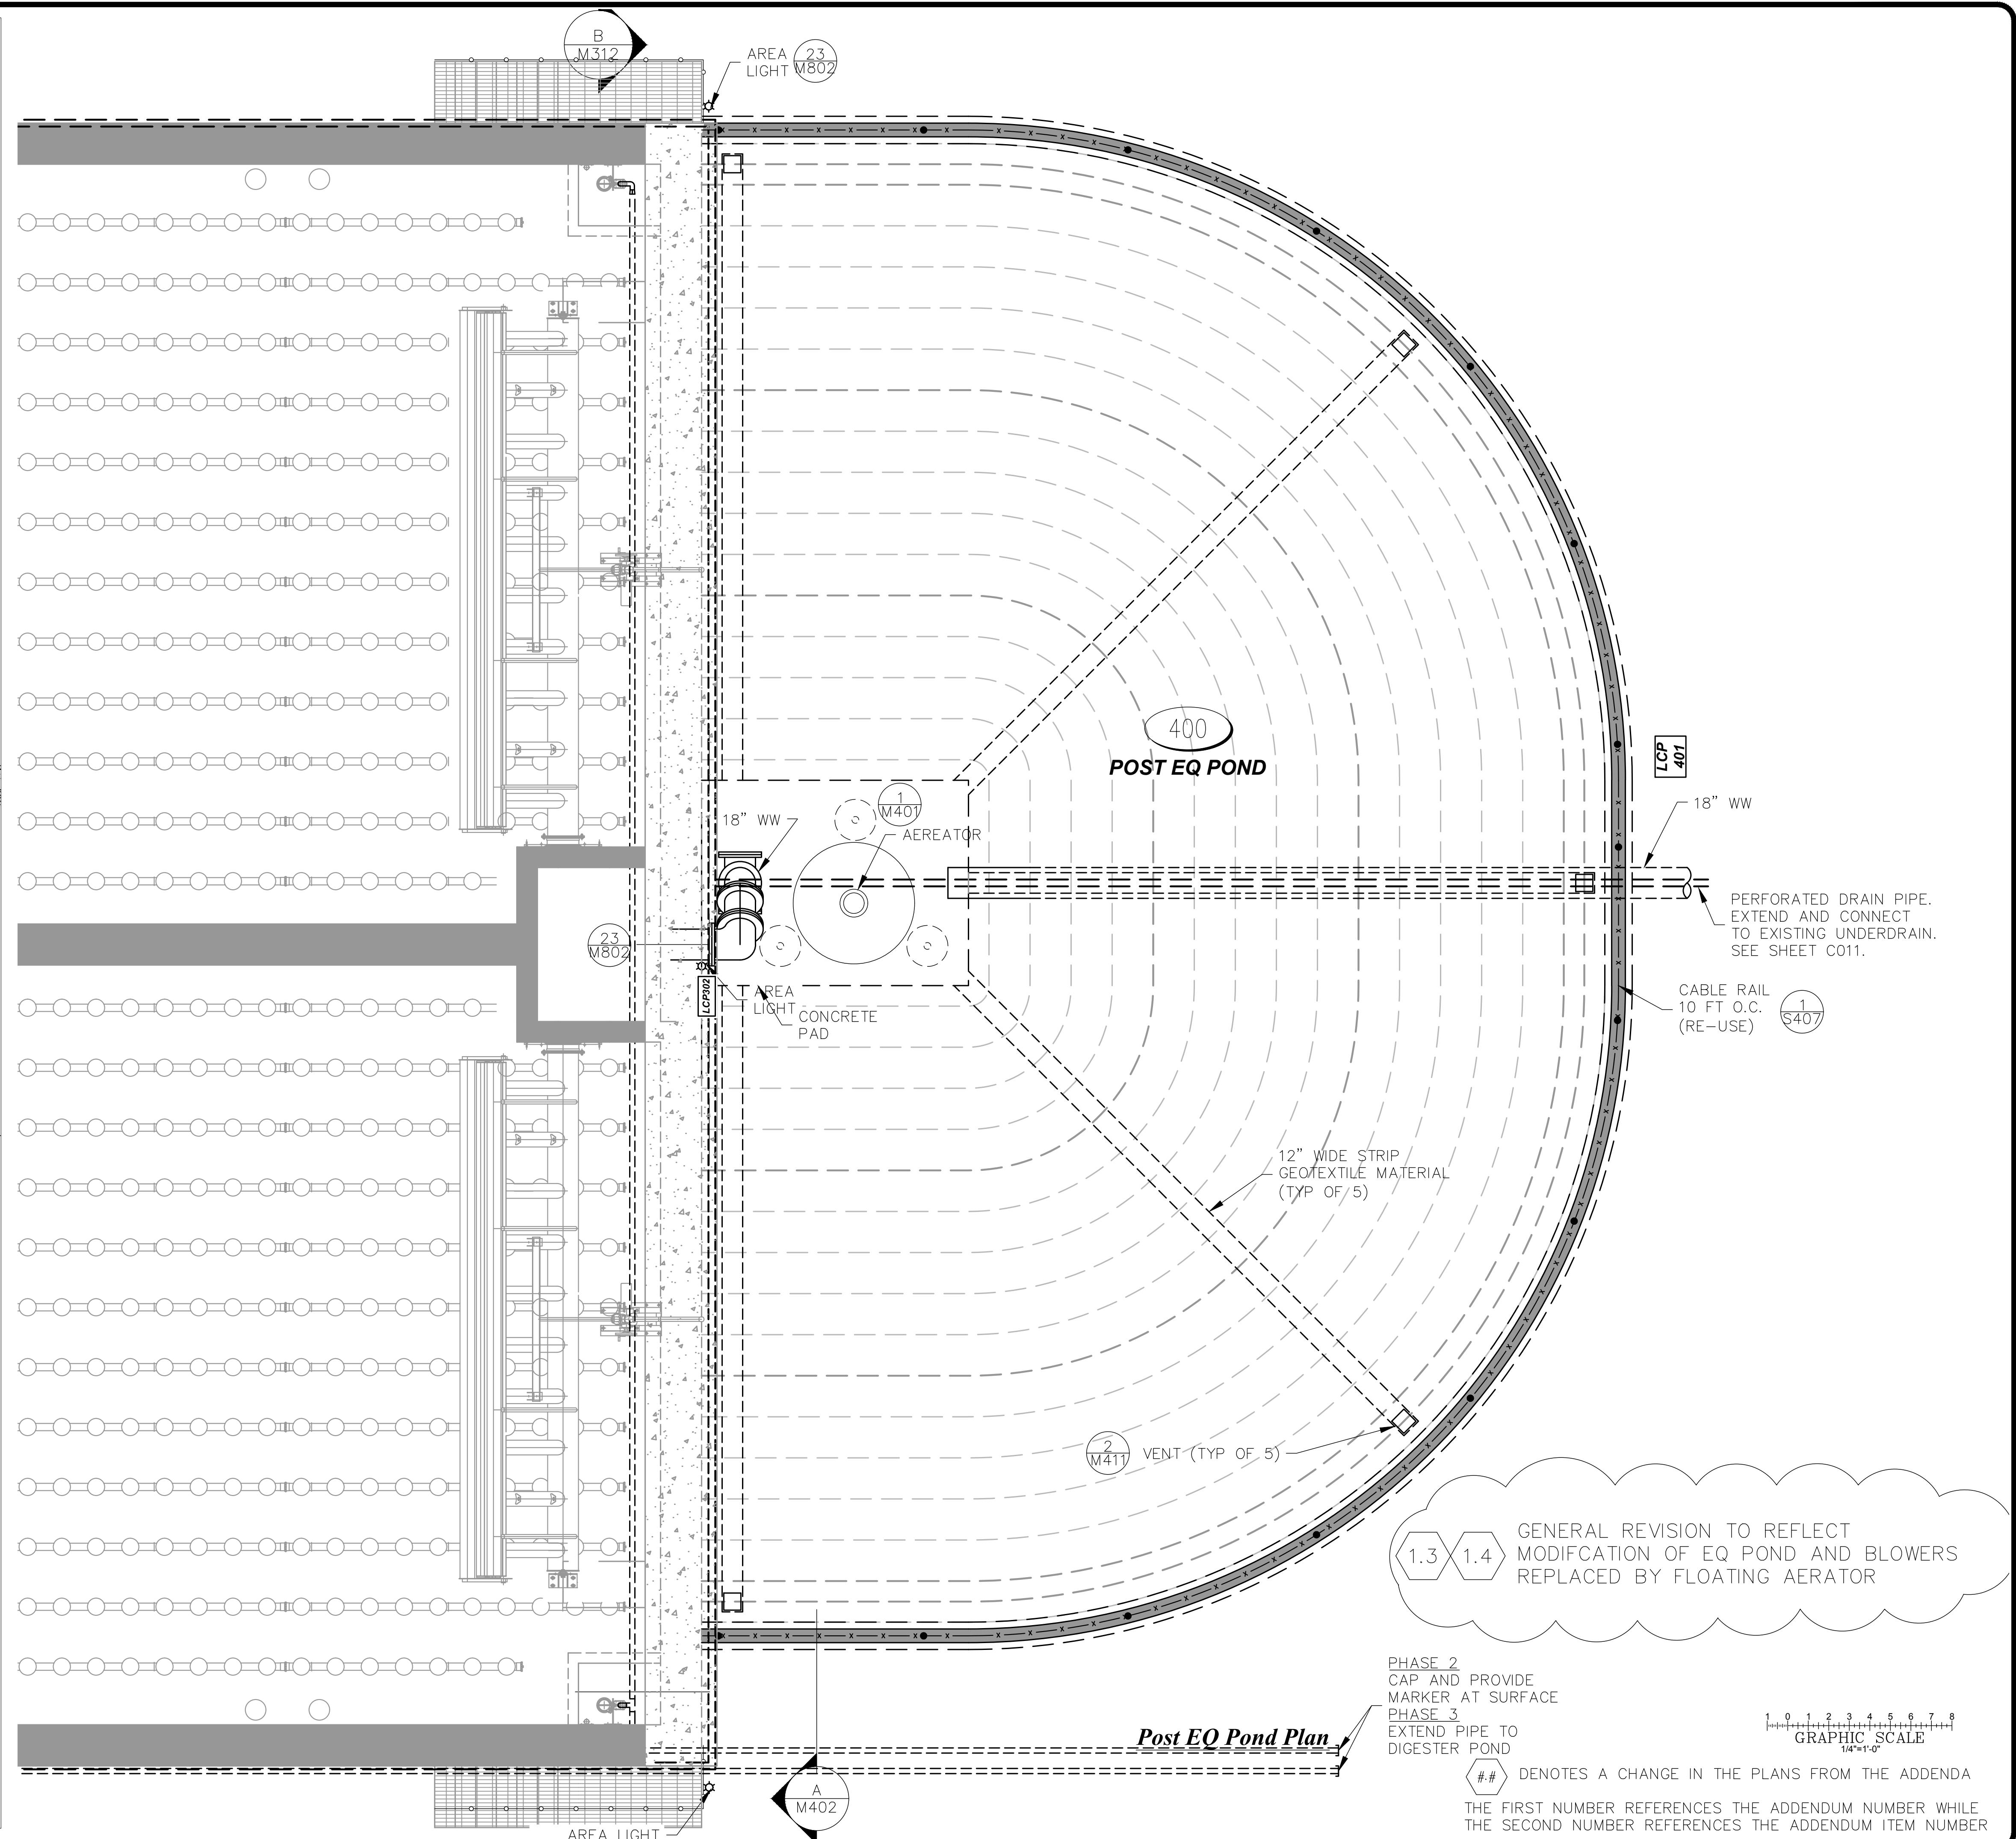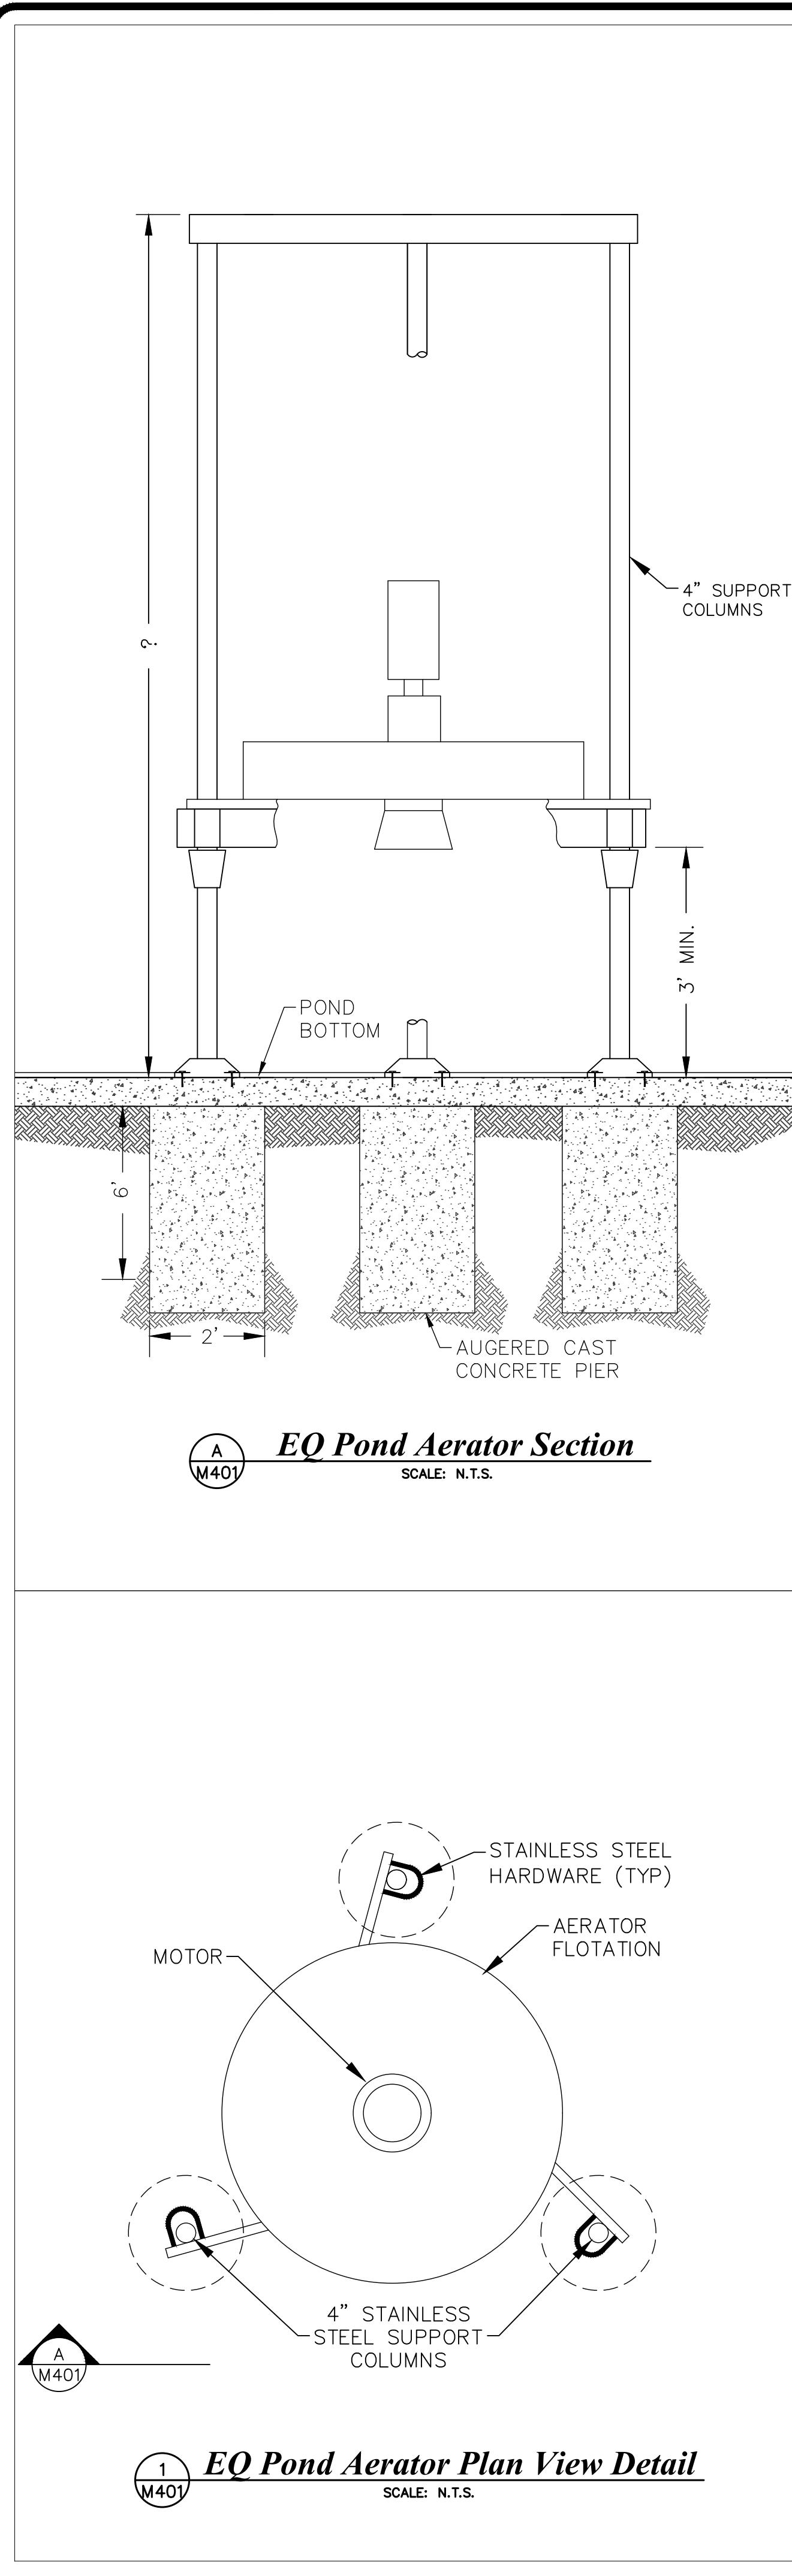



2	4/10/19	ADDITIONAL #1
1	12/2/18	GENERAL REVISION
0	8/1/18	INITIAL
		DESCRIPTION

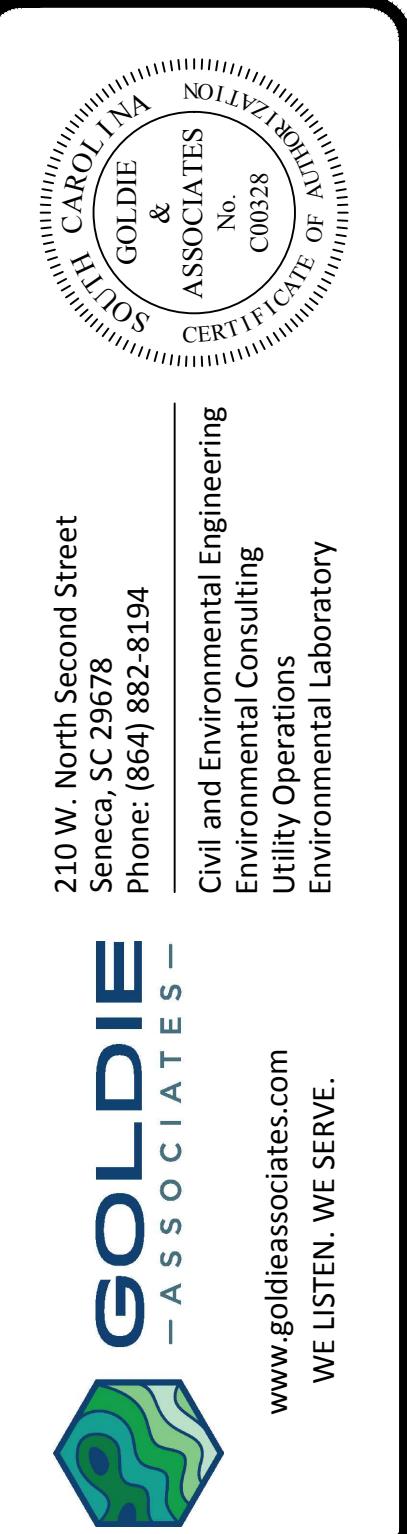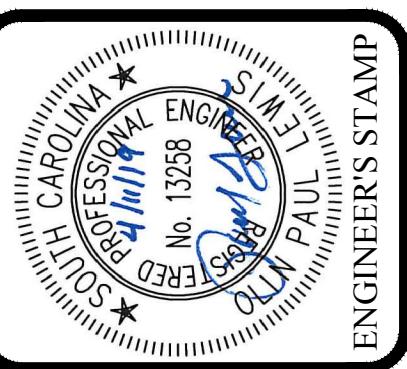

210 W. North Second Street Seneca SC 29678 Phone: (864) 382-3194
Civil and Environmental Engineering Utility Operations Environmental Laboratory
www.goldieassociates.com WE LISTEN. WE SERVE.

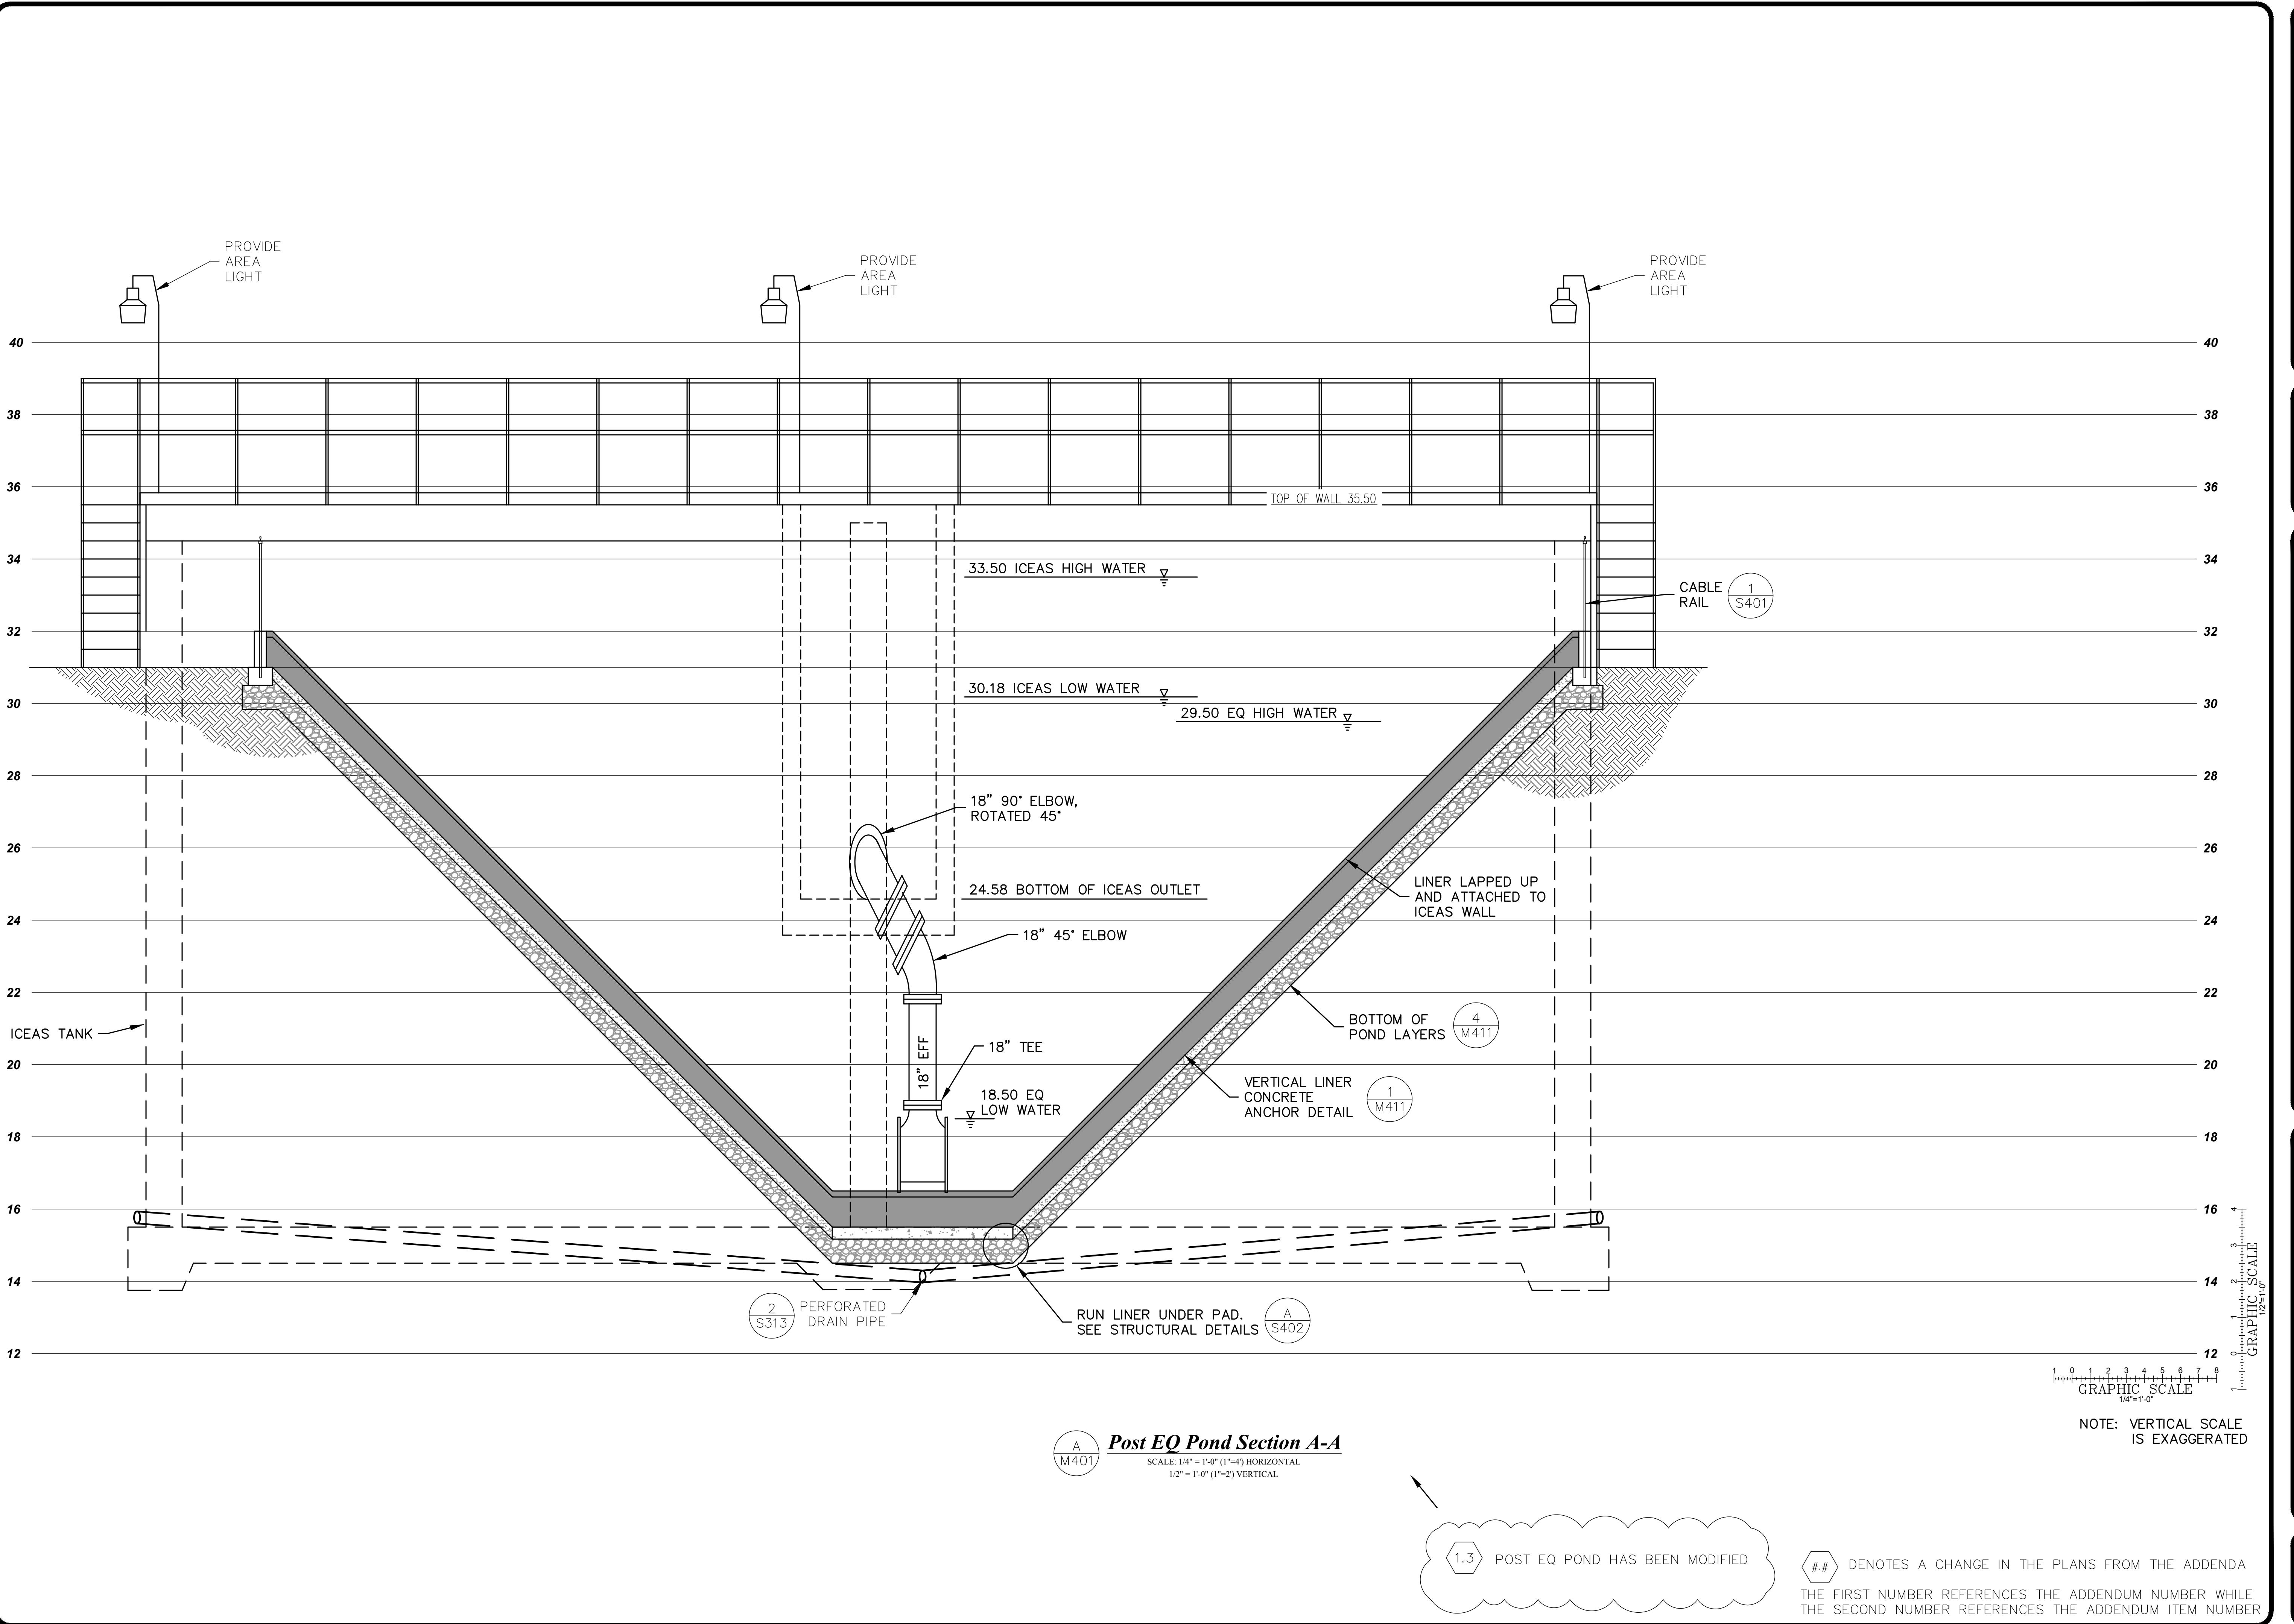

CLIENT	POST EQ POND SECTION AND DETAILS	PROJECT	JIMMY MIXSON WRF EXPANSION
SHEET TITLE		FILE NO.	M402
ADDENDUM #	1	OF	--
DATE	8/1/18	DESCRIPTION	1636.6
OPN	GENERAL REVIEW	OPN	INITIAL
OPN	INITIAL	OPN	BY

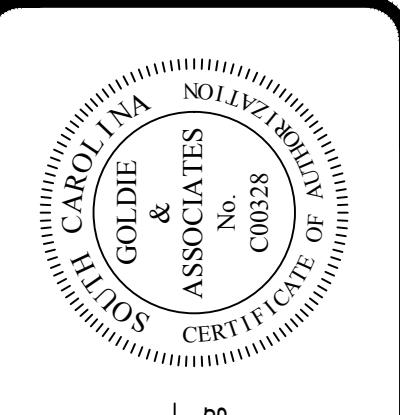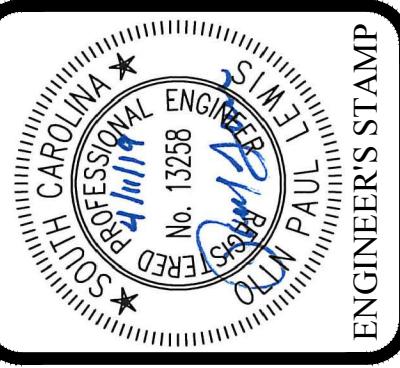

210 W. North Second Street
Seneca, SC 29678
Phone: (864) 882-8194
Civil and Environmental Engineering
Environmental Consulting
Utility Operations
Environmental Laboratory







CLIENT
Town of Ridgeland
PROJECT
Jimmy Mixson WRF Expansion
SHEET TITLE
Post EQ Pond Section and Details

SHEET NO.
M402

OF
--

FILE NO.
1636.6

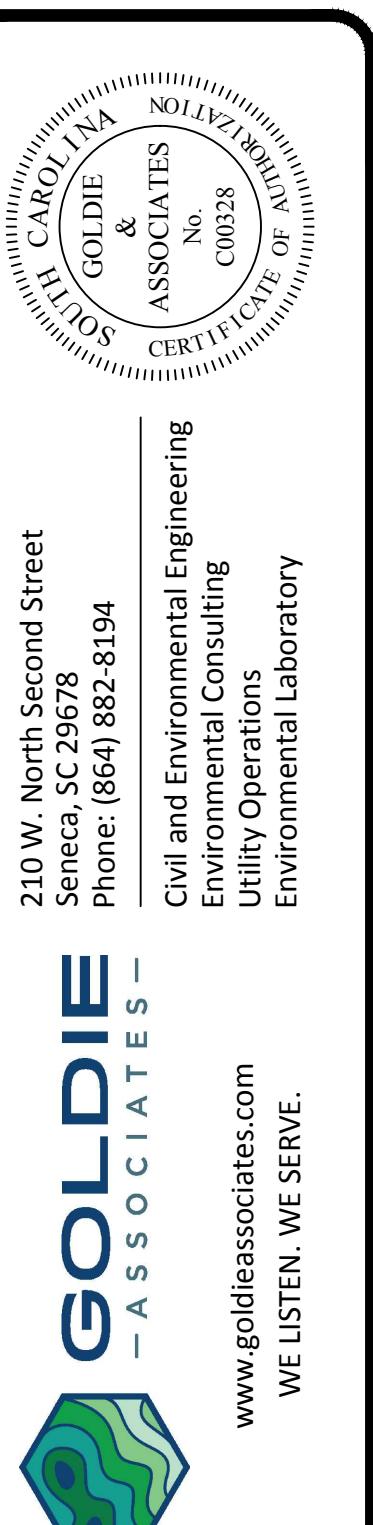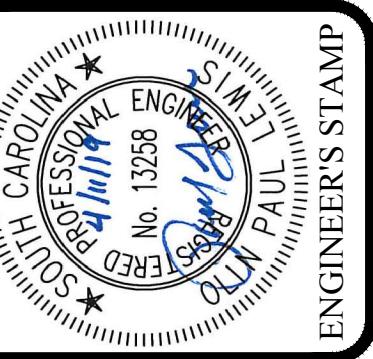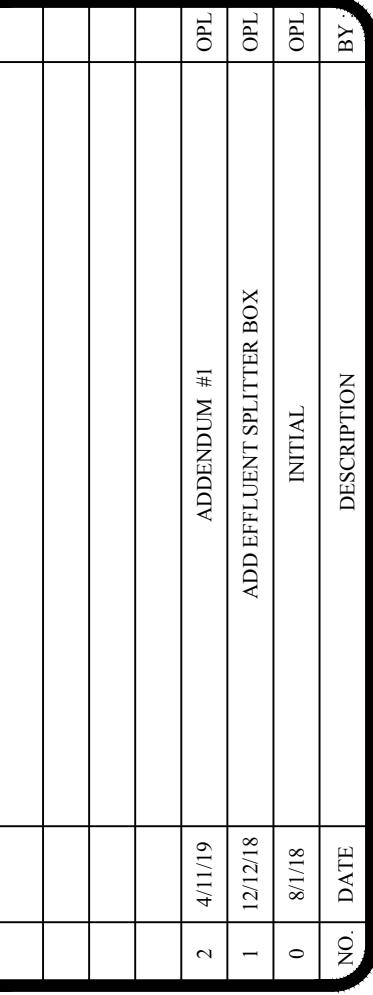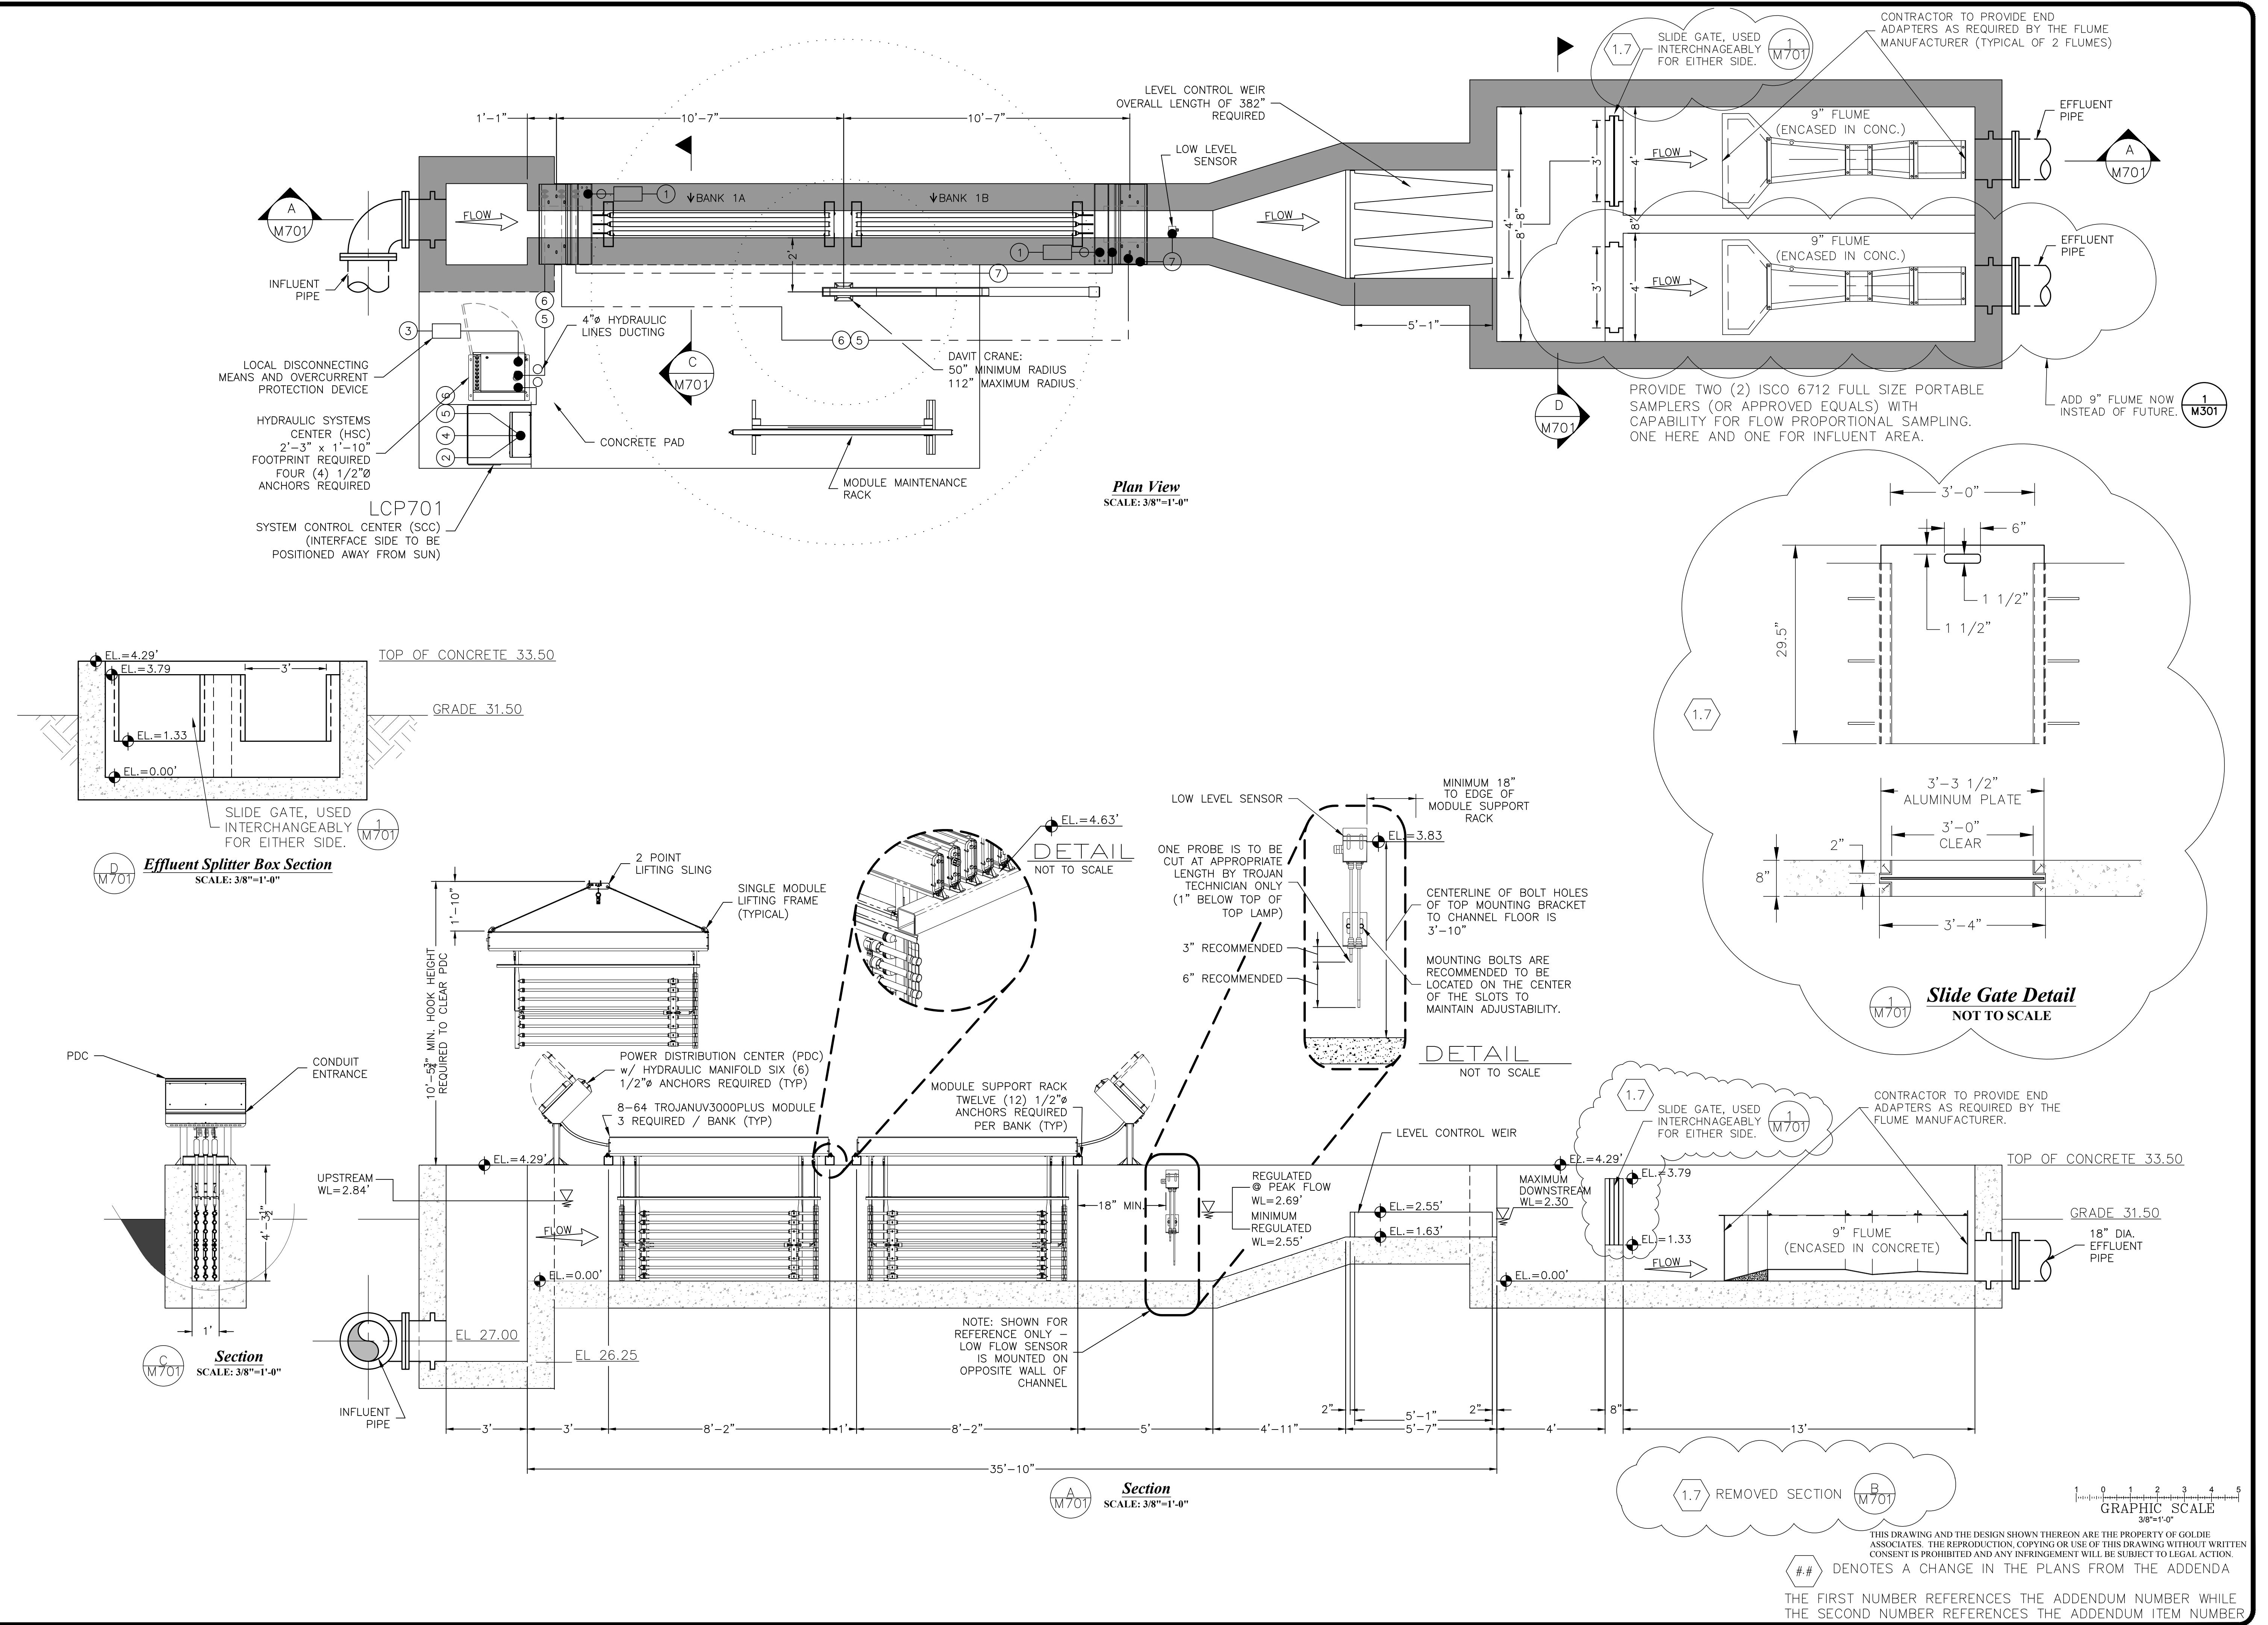

Town of Ridgeland





PROJECT

Jimmy Mixson WRF Expansion

SHEET TITLE

UV Disinfection and Effluent Flume

<i>Town</i>	<i>PROJECT</i>	<i>Jimmy</i>	<i>SHEET TIT</i>	<i>UV Dis</i>
SHEET NO.		OF		
M701		---		
FILE NO.				
1636.6				

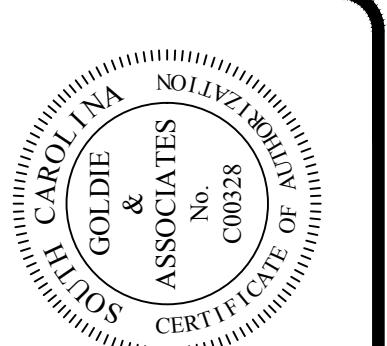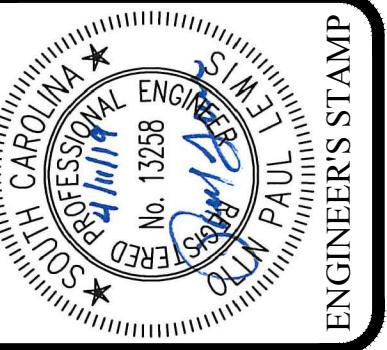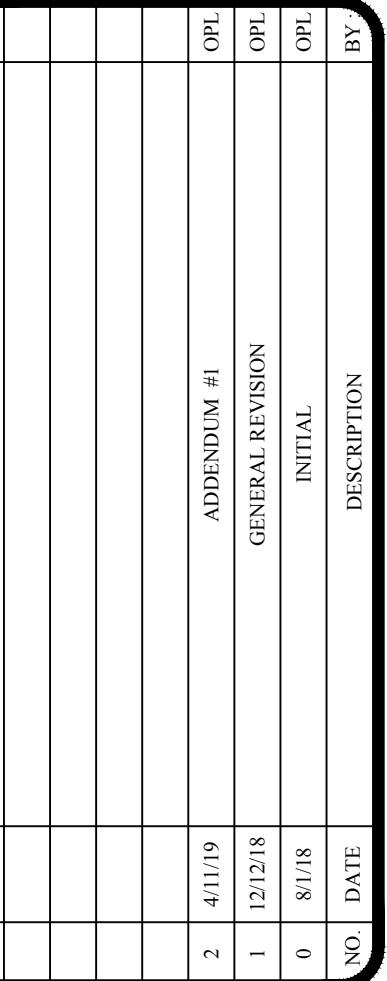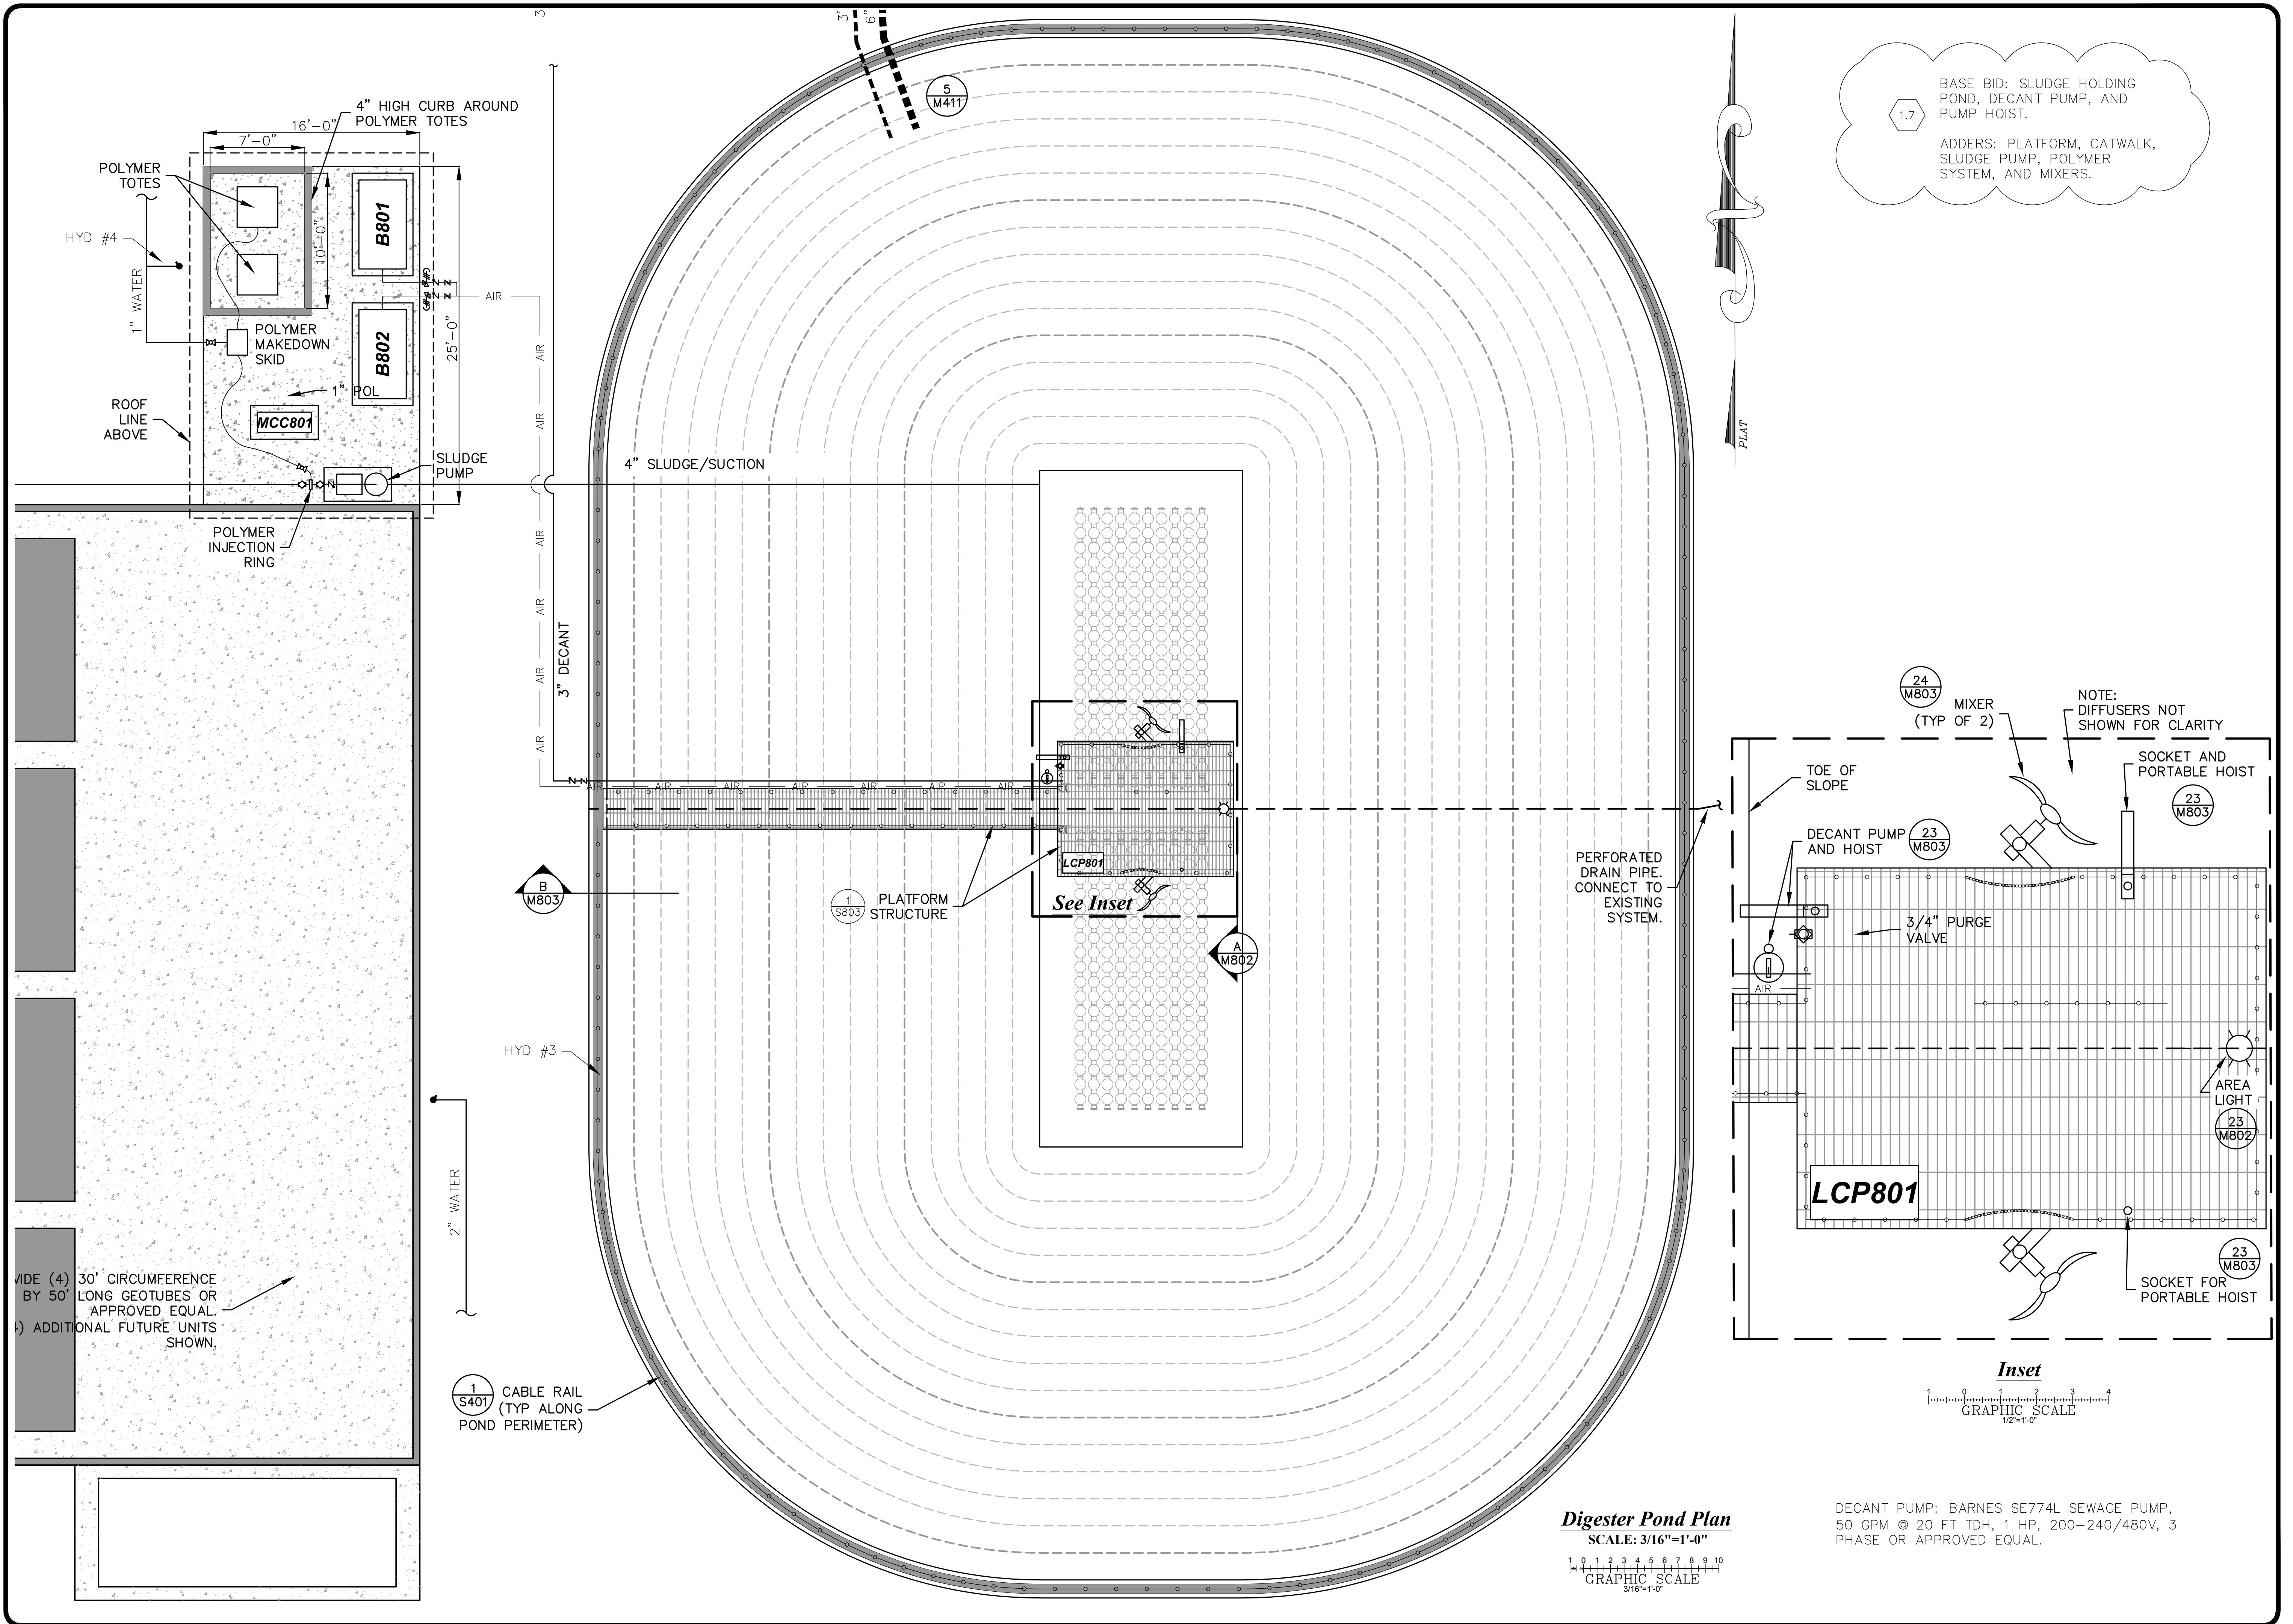

2110 W. North Second Street
Seneca, SC 29678
Phone: (864) 882-8194



Civil and Environmental Engineering
Environmental Consulting
Utility Operations
Environmental Laboratory




<i>Town of Ridgeland</i>	PROJECT	<i>Jimmy Mixson WRF Expansion</i>	SHEET TITLE	<i>Sludge Digester Pond Plan</i>
--------------------------	---------	-----------------------------------	-------------	----------------------------------

<i>Town</i>	<i>PROJECT</i>	<i>Jimmy</i>	<i>SHEET TIT</i>	<i>Sludge</i>
SHEET NO.		OF		
M801		---		
FILE NO.				
1636.6				

Sludge Digester Pond Plan

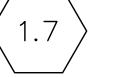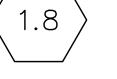
 1.7 BASE BID: SLUDGE HOLDING POND, DECENT PUMP, AND PUMP HOIST.
 ADDERS: MIXERS, DIFFUSERS, CATWALK, AREA LIGHT
 1.8 SLUDGE SUCTION PIPE.

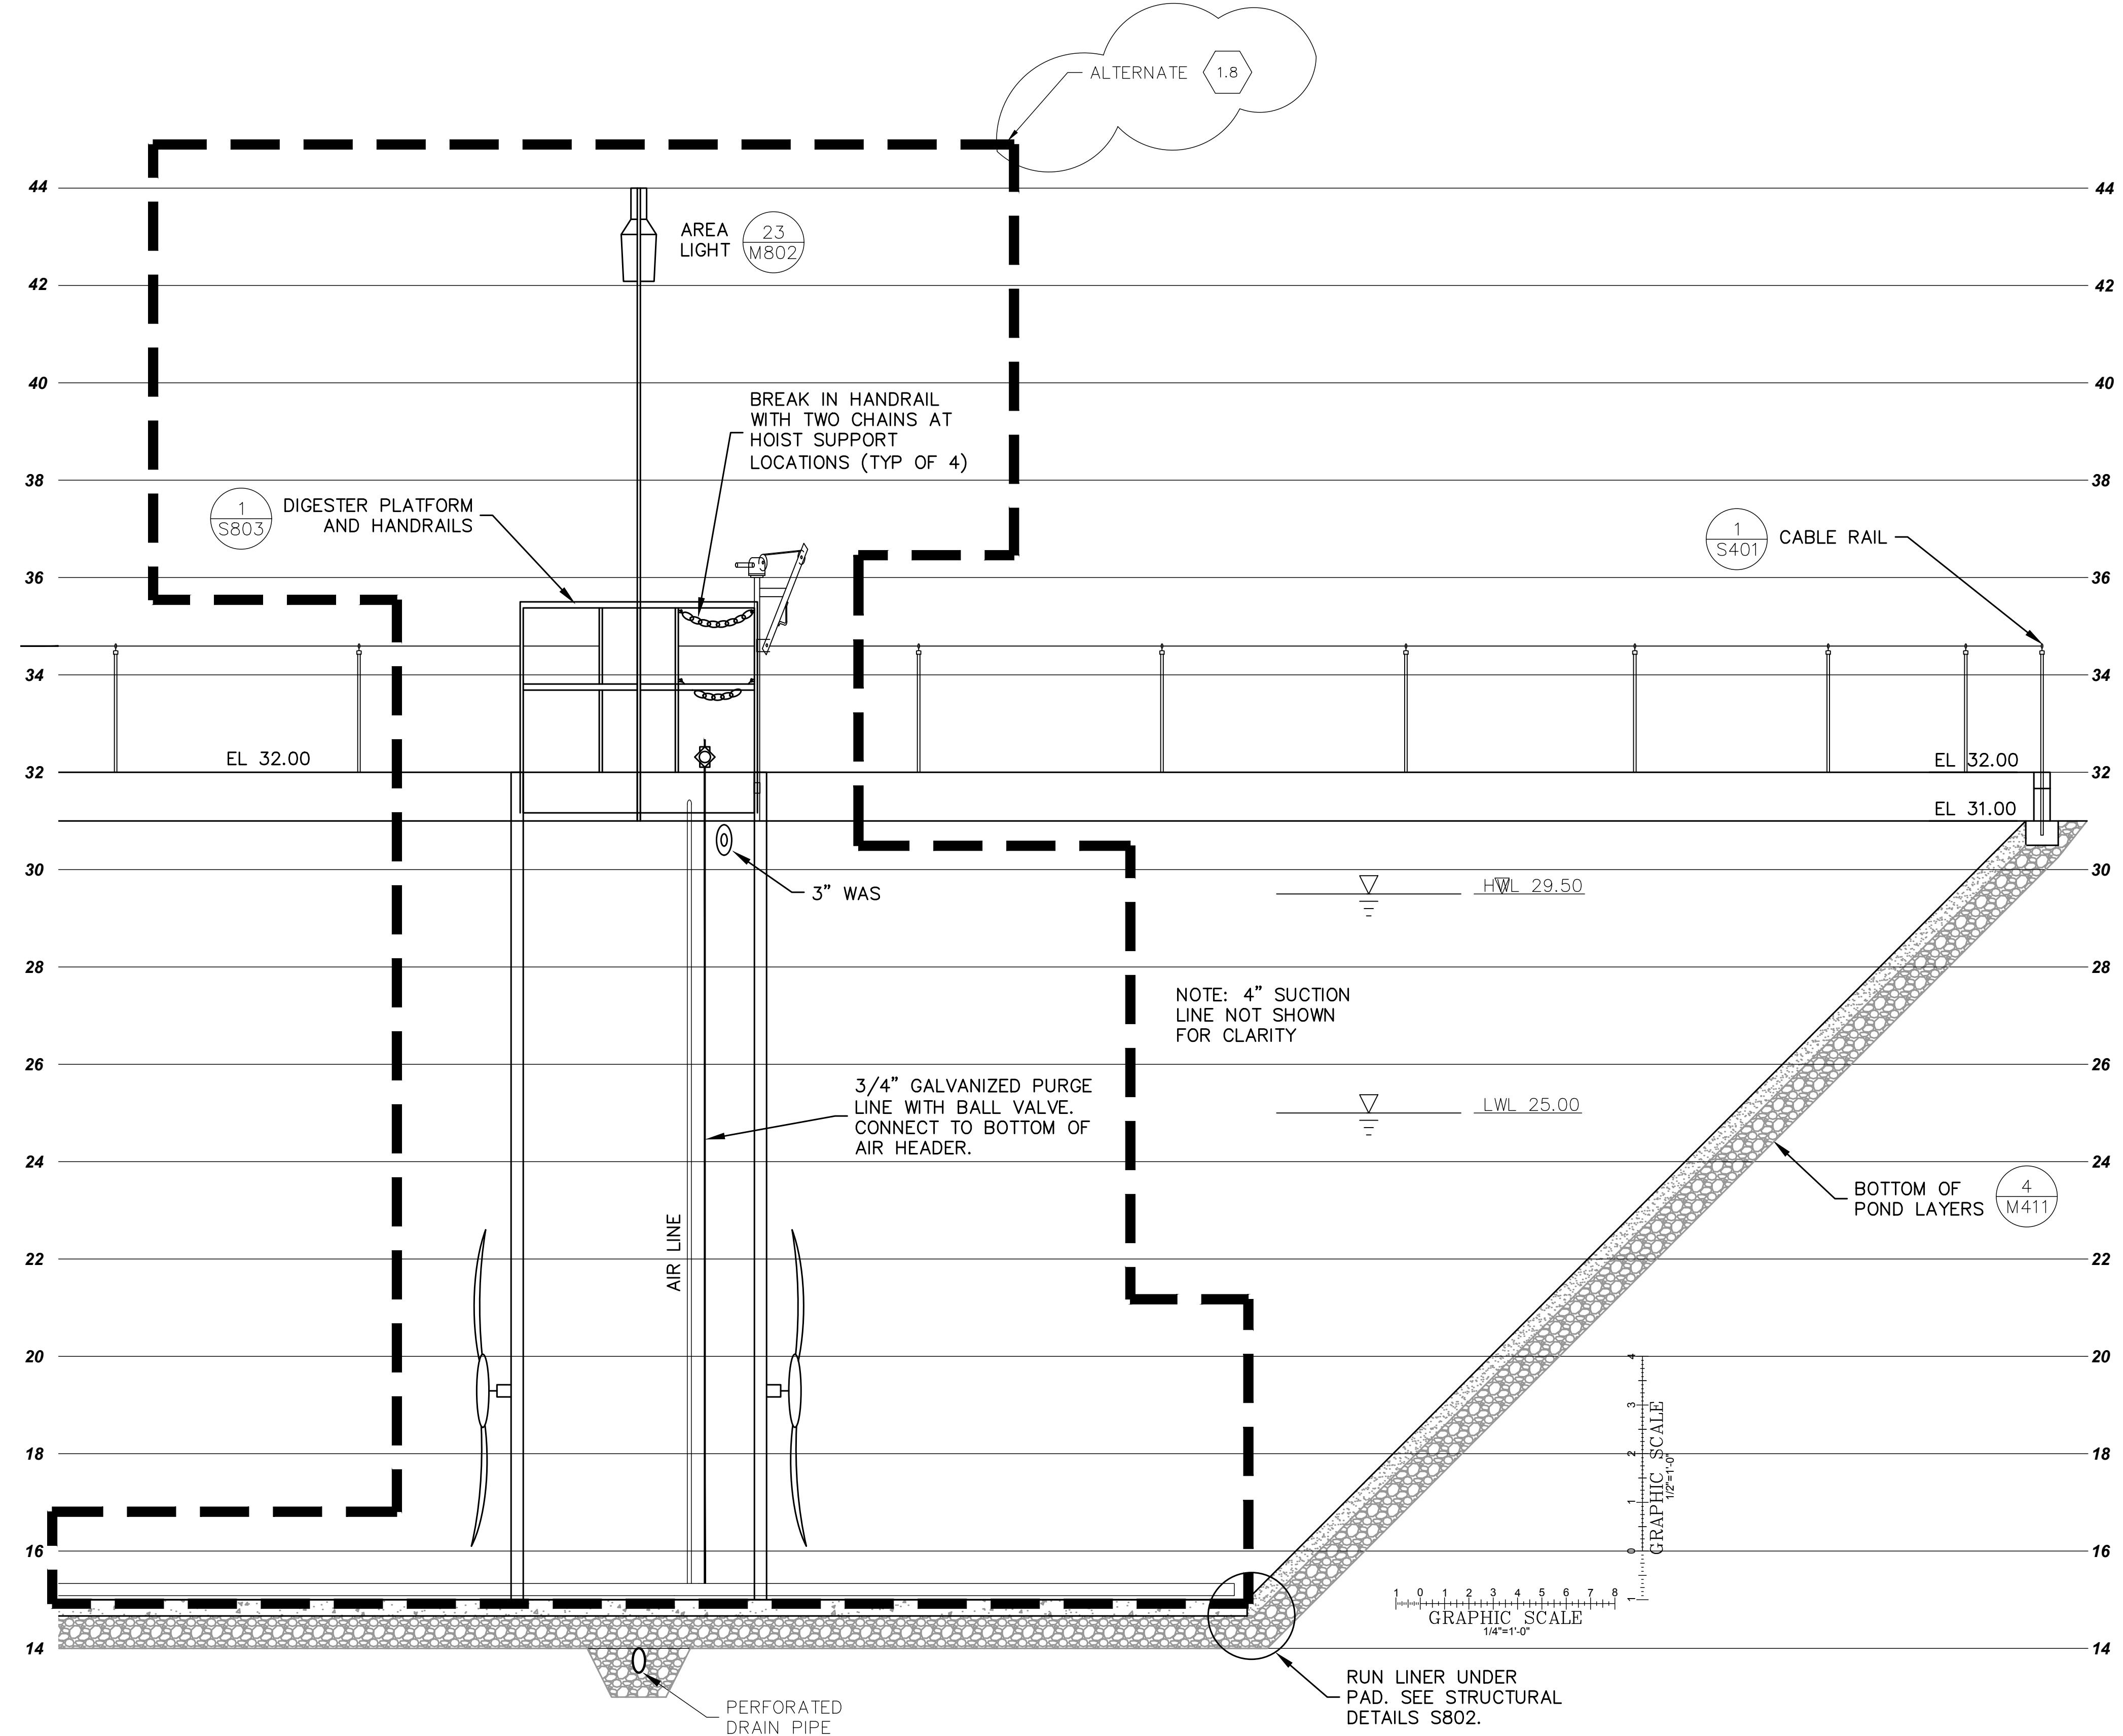


CLIENT: **Town of Ridgeland**
PROJECT: **Jimmy Mixson WRF Expansion**
SHEET TITLE: **Sludge Digester Pond**

SHEET NO.: **M802** OF: **--**
FILE NO.: **1636.6**
Sludge Digester Pond

2	4/10/19	APPENDIX #1
1	12/2/18	GENERAL REVISION
0	8/1/18	INITIAL
		DESCRIPTION

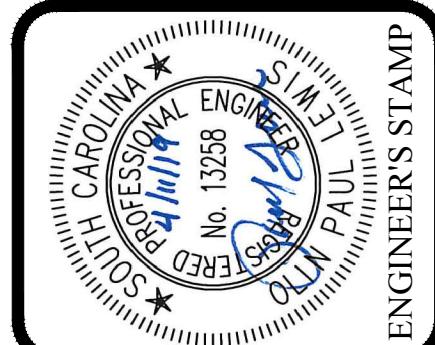


- 1.7 BASE BID: SLUDGE HOLDING POND, DECANT PUMP, AND PUMP HOIST.
- 1.8 SLUDGE SUCTION PIPE.

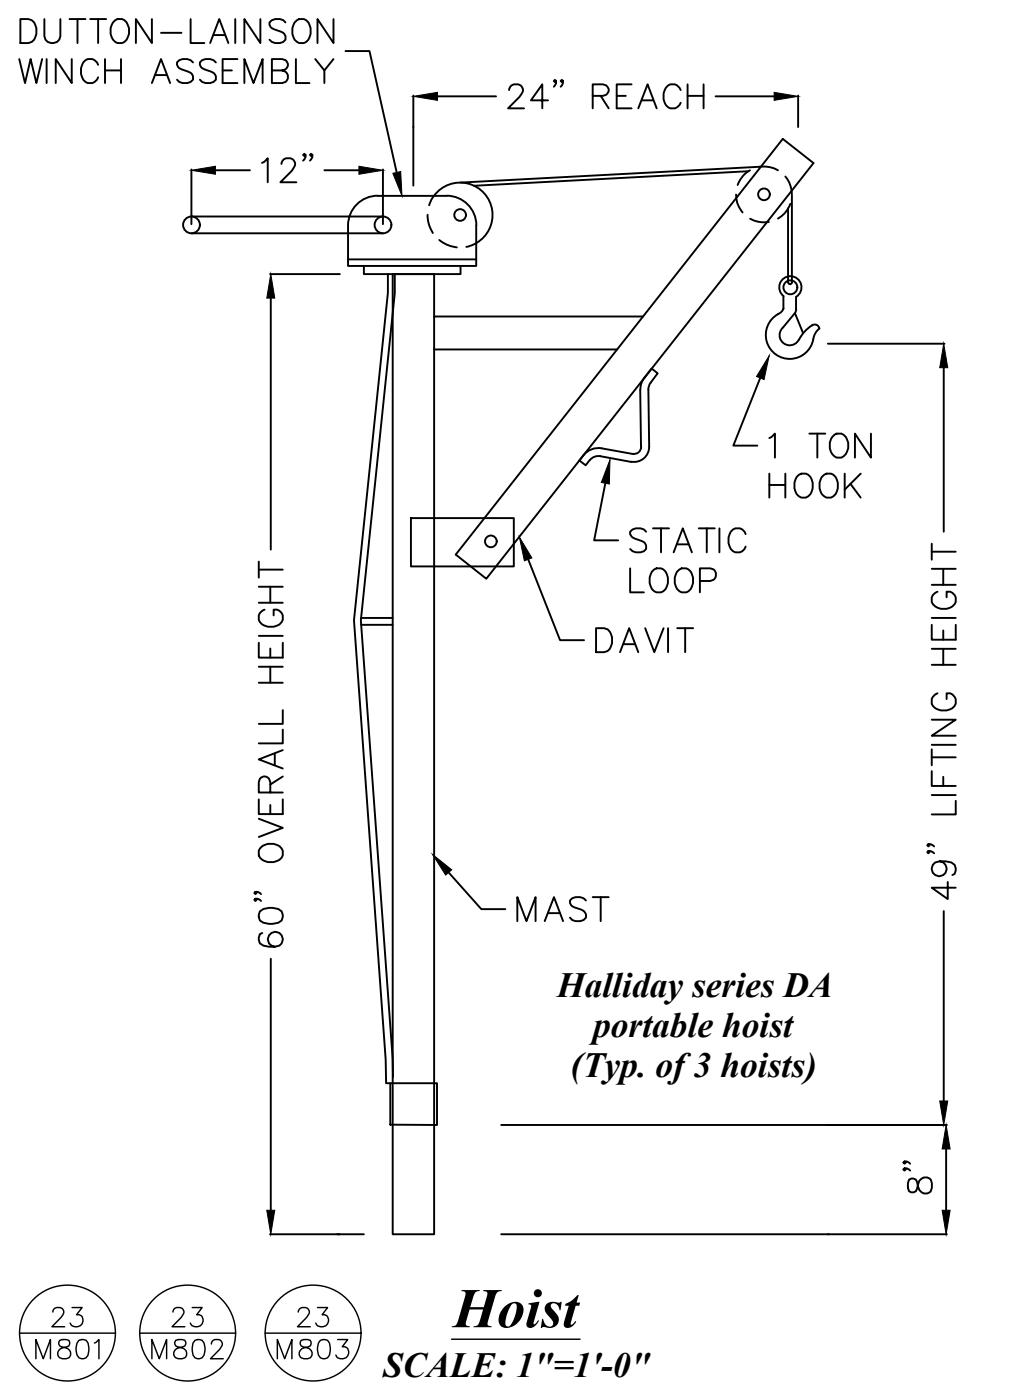


Hoist
SCALE: 1"=1'-0"

Hotst
SCALE: 1"=1'-0"

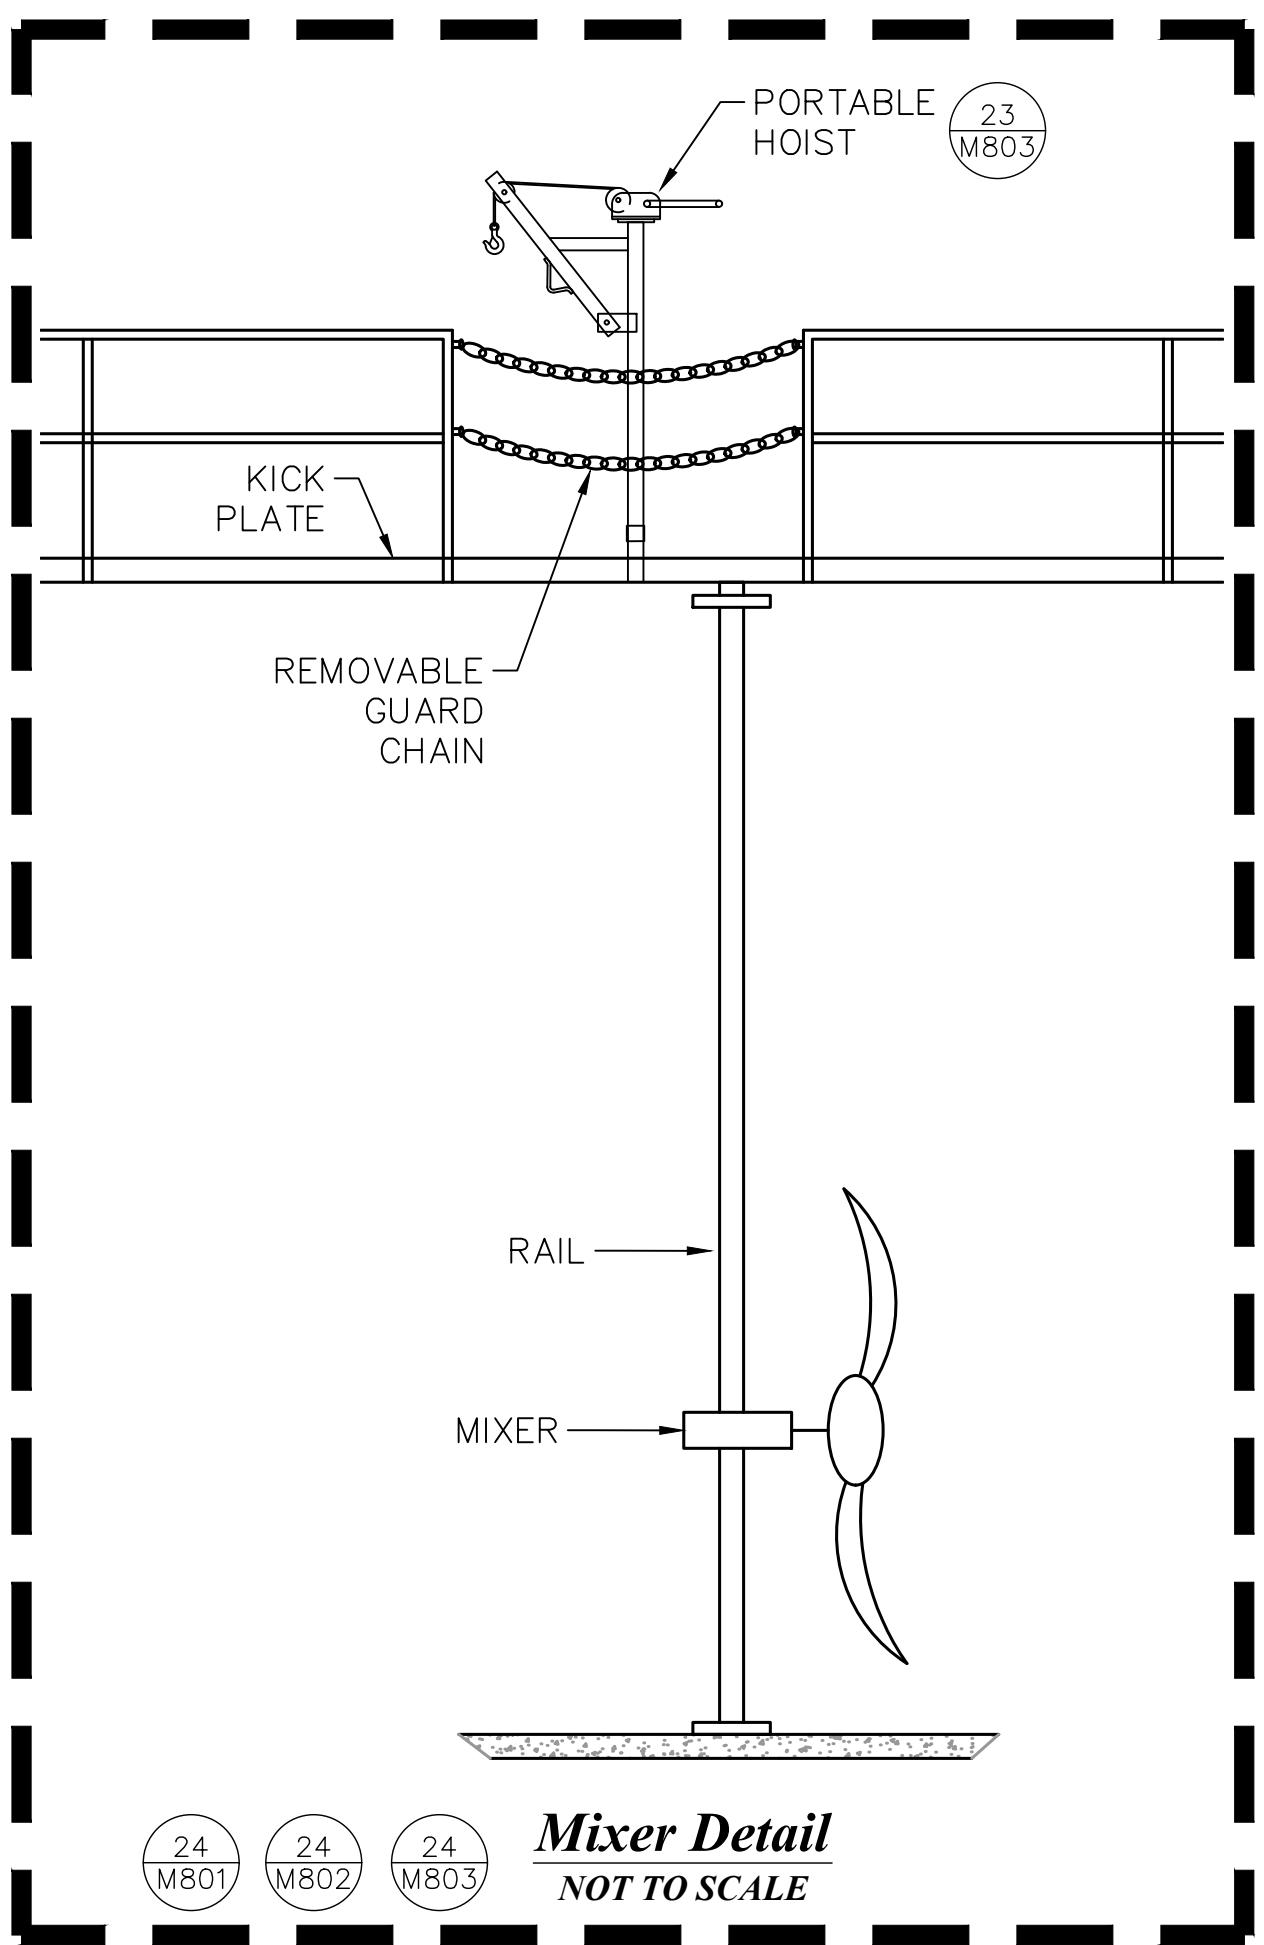

Mixer Detail
NOT TO SCALE

NOT TO SCALE

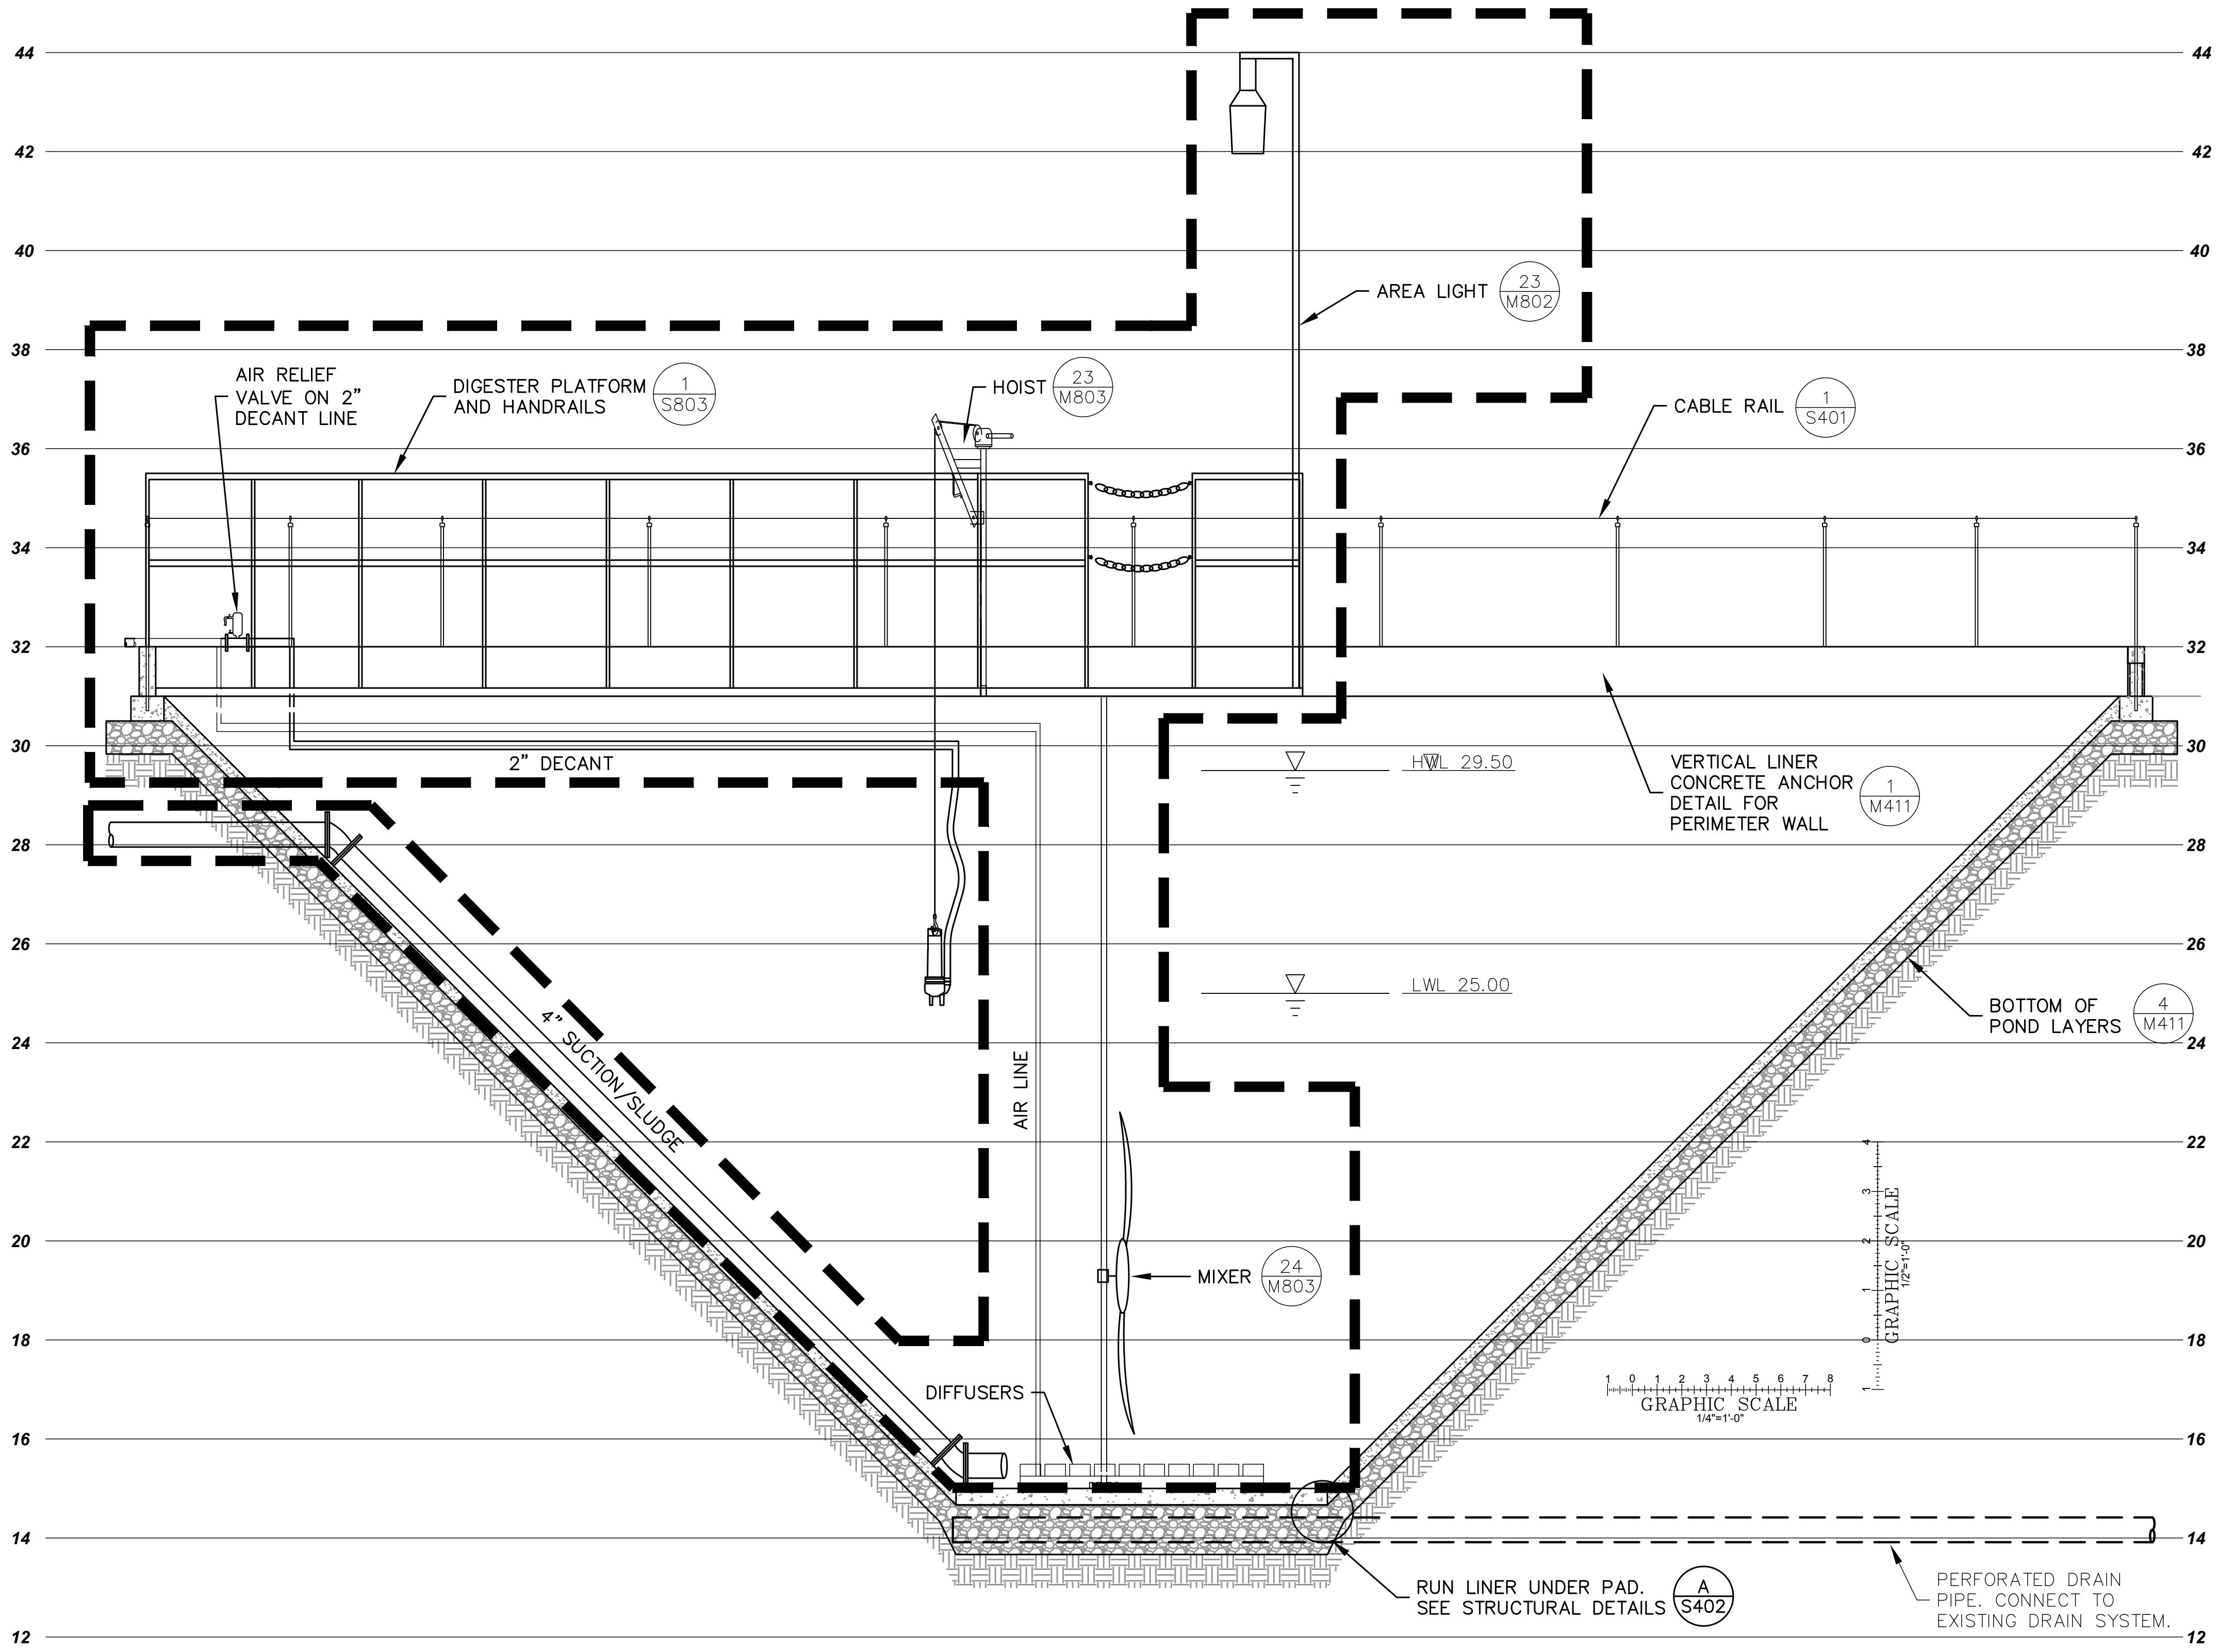

Digester Pond Section

**SCALE: 1/4"=1'-0" (1"=4') H
1/2"=1'-0" (1"=2') V**

CLIENT	<i>Town of Ridgeland</i>	<i>Jimmy Mixson WRF Expansion</i>	<i>Sludge Digester Pond</i>
PROJECT			SHEET TITLE


The logo for Goldie Associates consists of the word "GOLDIE" in large, bold, blue capital letters, followed by "- ASSOCIATES -" in smaller blue capital letters. Below this text is a stylized hexagonal graphic composed of concentric, wavy, green and blue lines, resembling a topographic map or a stylized eye.

NO.	DATE	DESCRIPTION	BY
2	4/11/19	ADDENDUM #1	OPL
1	12/12/18	GENERAL REVISION	OPL
0	8/1/18	INITIAL	OPL


SHEET NO.	OF
M803	---
FILE NO.	
1636.6	

Sludge Digester Pond


Manual

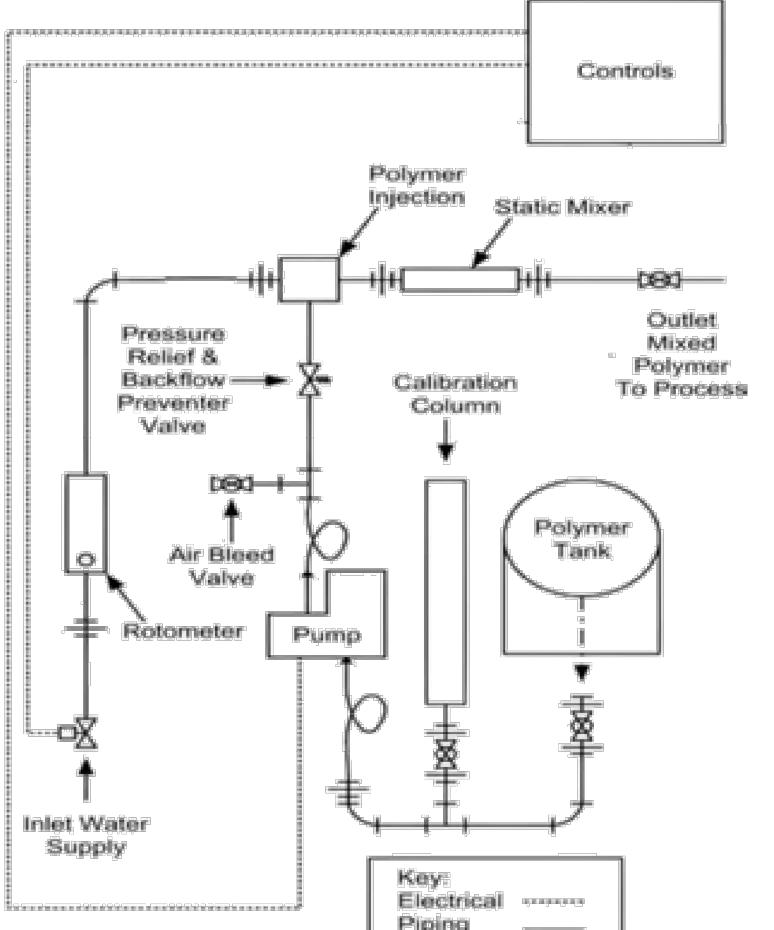

Dimensions Manual

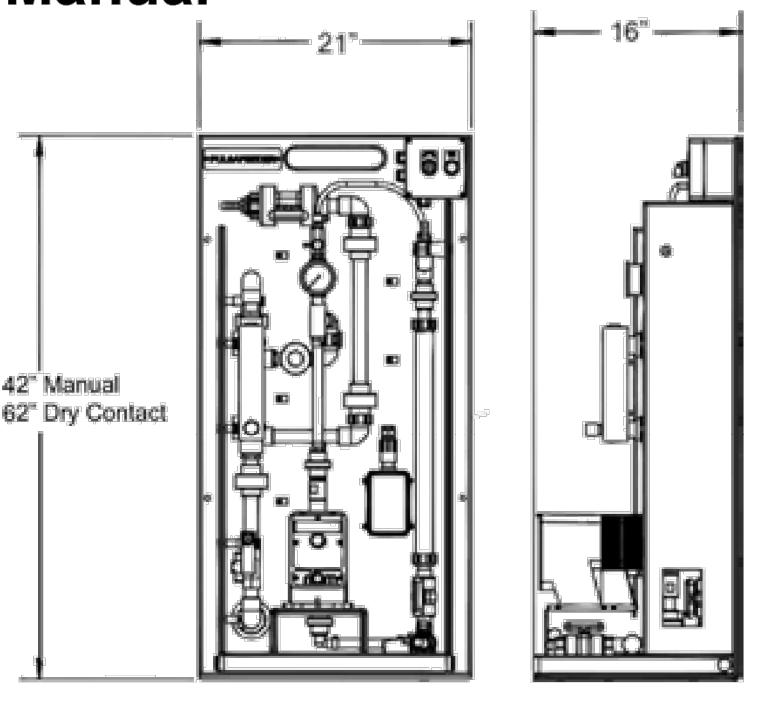

Polymer Makedown System NOT TO SCALE

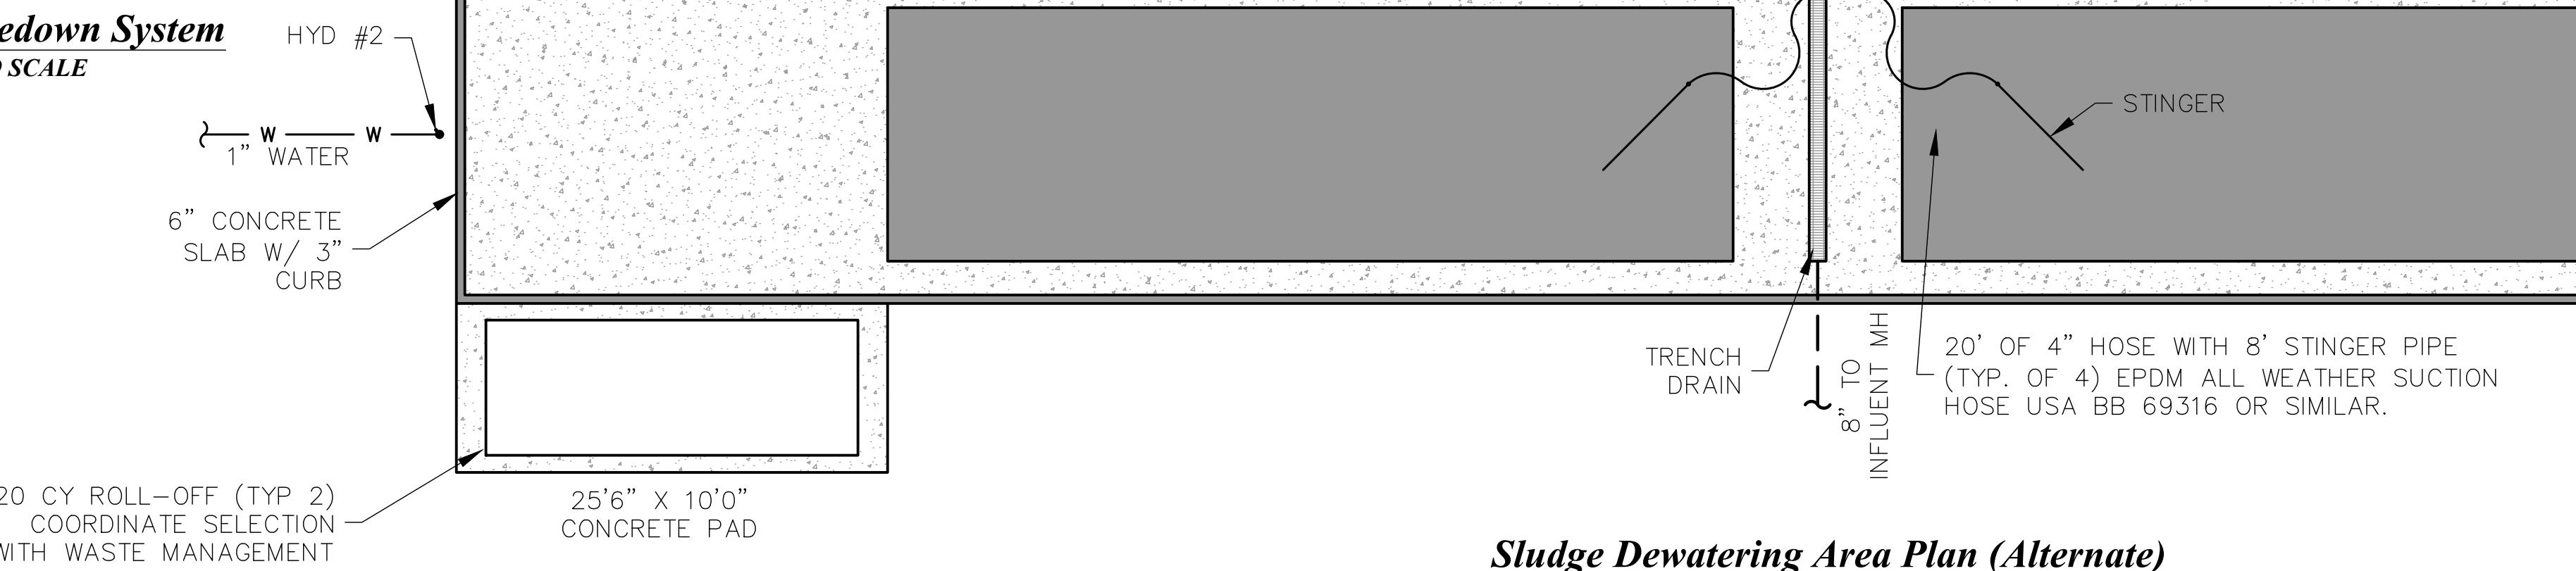


1.8 GEOTUBES ALTERNATE

POLYMER TOTE
(TYP OF 2)

1 M811
POLYMER MAKEDOWN SYSTEM
PULSAFEEDER MANUAL CONTROL SYSTEM
PESMCEVSBONN-XXX
POLYMER OUTPUT 4-10 GPH, WITH STOP
5-10 GPH. USABB #62089

4" SLUDGE

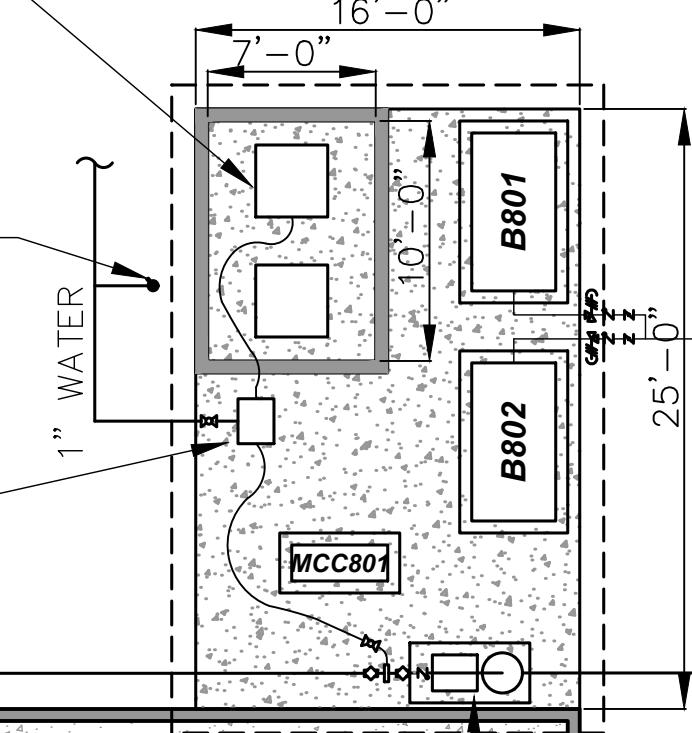

SLUDGE PUMP
GORMAN-RUPP T4 OR
APPROVED EQUAL. SEE
CS014 FOR PUMP
OPERATING POINT.
INSTALL WITH AIR
RELIEF VALVE.

3" DECAN

AIR — AIR

4" SLUDGE/SUCTION

AIR — AIR

3" DECANT

AIR — AIR

4" DRY

AIR — AIR