April 6, 2026

To: Effluent Filter and Pump Hoists Plan Holders
From: Blake Rodgers

Re: Addendum #1
Town of Ridgeland
Effluent Filter and Pump Hoists Project

Thanks to everyone who attended the pre-bid meeting. We appreciate your interest in the project.

Below are the Addendum #1 items for the project. If you have submitted a question or comment and do not see it addressed here, please resubmit it to us.

Addendum Reference #	Reference	Question / comment
1.0	Pre-Bid Sign In Sheet	Attached is the sign in sheet from the pre-bid meeting.
1.1	Plan Sheet 6	Q: What is the size, pipe material, and depth of the sanitary sewer line that needs to be rerouted around the influent jib crane base? A: It is a service lateral from the operations buildings. 6-inch PVC. The invert into the influent wetwell is approximately 5 feet below the top of the wetwell.
1.2	Plan Sheet 5	Q: Can you confirm that SCADA is not being paid by the contractor? A: The contractor's scope of work is to land CAT6 connections from the proposed effluent filter to the existing Effluent RTU, approximately 30 feet from the proposed effluent filter. The Owner's SCADA integrator will provide programming and software additions to the existing SCADA.
1.3	Section 00 41 00	Q: Please confirm if a SC General Contractor license with the WP classification is required to bid this project. A: Yes.

1.4	Section 01 45 00 Section 03 30 00	Q: Please confirm that owner is responsible for employing a material testing firm for this project. A: It will be the Owner's responsibility to employ and pay for testing services required for this project unless specified otherwise. The Contractor shall pay for samples required except those secured by the test lab. The Contractor shall reimburse the Owner for the costs of all retests required due to failure to meet specifications.
1.5	Section 00 73 00	Q: Please confirm that there are no Davis-Bacon, BABAA, or MWSBE requirements for this project. A: Davis-Bacon: Guidance from the funding agency, USDA RD RUS Bulletin 1780-26, states that RD does not require the use of Davis Bacon Wage rates. BABAA: Funding was allocated prior to the enactment of Build America, Buy America (BABA). Therefore, this project is not subject to BABA requirements. However, American Iron and Steel requirements apply. MWSBE: Refer to Section 00 73 00 Article 19.05 for Small, Minority and Women's Business requirements.
1.6	Section 46 61 43	Q: Please confirm that the contractor is to negotiate terms and conditions with the pre-selected equipment suppliers on negotiated terms and not the ones provided in the quote to the owner. A: The contractor is to negotiate terms and conditions with the pre-selected equipment supplier.
1.7	Section 00 41 00	Q: Are digital signatures for bid documents acceptable in lieu of wet ink signatures? A: No.
1.8		Q: In light of the unprecedented and unpredictable market conditions arising out of or relating to newly enacted or changed tariffs or other enactments and/or changes to laws, regulations, executive orders and other orders or decrees of government officers and authorities relating to ongoing and/or future trade in or with the United States, will the Owner modify the terms of the Contract to provide Contractor with reasonable equitable relief due to the unpredictable effect of such tariffs and market conditions on the cost or time for performance of the Work after the submission of bids or completed negotiations of price? A: The Owner makes no commitment to modifying the terms of the Contract regarding the conditions listed in the contractor's question.

1.9		Q: Would the owner consider an administrative NTP if the contractor receives extended lead times for materials and equipment that would threaten the ability to complete the project within the provided contract times? A: The Owner is willing to issue an administrative NTP, within in reason and with agreement from the Funding Agency.
1.10	Section 00 21 13 Article 21 SCDOR Exemption Certificate	Q: Please confirm that all equipment and materials needed for this project are tax exempt. A: The Owner holds an SCDOR Exemption Certificate, attached.
1.11	Section 41 22 13.19	Q: Please provide a specification for the jib cranes. A: See attached specification Section 41 22 13.19 – Jib Crane.
1.12	Plan Sheets 3 and 7	Q: Is it the intention to depict all existing piping with dashed lines and new piping with solid lines? If so, please clarify if the piping exiting the effluent pump station is existing as shown in page 3. Or new as shown in page 7. A: The intention is to depict all existing piping with dashed lines and proposed piping with solid lines. All effluent filter underground piping exists. See Effluent Filter existing conditions photo log.
1.13		Q: If the piping exiting the effluent pump station is new, please clarify whether it is to be configured as shown on page 3 by splitting off with a tee, or as shown on page 7, splitting off with a cross and additional valve. A: See Addundum item 1.12.
1.14	Plan Sheet 3 Section 40 23 00	Q: Please provide a valve schedule as there is no indication of valve type for proposed valves in the drawings. A: See revised Plan Sheet 3 for valve schedule included in Plan Set Release B.
1.15	Section 00 41 00 – Bid Form	Q: Please confirm whether electrical and SCADA pricing is to be itemized within bid form items 2, 3, 4, and 5, or if all electrical and SCADA costs should be consolidated under bid form item #5. A: Interconnection of the proposed Effluent Filter into the existing SCADA Effluent RTU pricing shall be included in bid form item #2. Pricing for electrical work of bid form items 2, 3, and 4 shall be reported as bid form item #5.
1.16	Plan Sheets 6 and 7 Section 03 30 00	Q: Please confirm that the concrete material for the jib crane bases is to be 3,000 psi per the notes in the drawings, and not 4,000 or 4,500 as described in the specs. A: Jib crane foundations are to be 3,000 psi concrete as shown on the plans. Section 03 30 00 provides 3,000 psi design mix.

1.17	Section 00 26 00	Q: Are there any other approved manufacturers for the jib cranes or electric hoists? A: Plans are based on Gorbel jib cranes and Harrington electric hoists. If other manufacturers are proposed, it will be the responsibility of the contractor to achieve design requirements including but not limited to clearances and capacities, meeting the criteria of Section 00 26 00 – Substitution Procedures. The final determination of approved substitutions will be by the engineer.
1.18		Q: Please clarify when Qualifications of Bidders are due. In Article 3 – Qualifications of Bidders, 3.01 indicates they are due within 5 days of the Owner's request and in Article 2 of the Bid Form, 2.01.F, requires the Qualifications Statements to be submitted with the bid as a condition of the bid. A: The Qualification Statement does not have to be submitted with the bid. However, the Owner reserves to right to request submittal of Qualifications of Bidder after submission of a bid. If the Qualifications of Bidder is requested by the Owner, the bidder shall submit the Qualifications of Bidder within 5 days of request.
1.19	Section 00 21 13 SCDOR Exemption Certificate	Q: Can you confirm that the contractor does not have to pay taxes on equipment. If so, can y'all provide documents communicating this to our vendors? A: See attached SCDOR Exemption Certificate.
1.20		Q: Can you confirm if a new safety switch is needed or not? A: A safety switch is not needed for the proposed Effluent Filter.
1.21		Q: Is there a budget number for this job? A: No.
1.22	Section 26 05 00	Q: Is there any OCAL required for our scope of work? A: OCAL, PVC coated rigid steel conduit, is not required.
1.23	Plan Sheet 5	Q: Are contractors required to provide breakers for disk filters? A: Contractors are to provide all necessary electrical equipment so that the Project Work is complete and functional.

If you have any questions, comments, or need further information, please email me at blake@goldieassociates.com.

Sincerely,
Goldie Associates

Blake Rodgers, PE
Senior Engineer

Attachments: Pre-Bid meeting sign in sheet
Plan Set Release B
SCDOR Exemption Certificate
Jib Crane Specification Section 41 22 13.19
Effluent Filter existing conditions photo log

TOWN OF RIDGELAND

EFFLUENT FILTER AND PUMP HOISTS

JIMMY MIXSON WATER RECLAMATION FACILITY

PRE-BID ATTENDEES
MARCH 31, 2026, 1:00PM

Company Name	Contact Name	Phone # & Email Address
Goldie Associates	Blake Rodgers	864-882-8194 x 118 blake@goldieassociates.com
Town of Ridgeland	Cecil Humbert	843-694-4032 chumbert@ridgelandsc.gov
Town of Ridgeland	Dennis Averkin	843-726-7504 daverkin@ridgelandsc.gov
Ashmore Concrete Pumping	Bryson Ashmore	843-300-2264 bryson@ashmoreconcrete.com
AAA Utility & Construction	Jay Talbot	803-213-9261 jtalbot@AAAUAC.com
Harper GC	Sarah Phillips	864-979-0848 sarah.phillips@harpergc.com

Effluent Filter and Pump Hoists

JIMMY MIXSON WASTEWATER RECLAMATION FACILITY
TOWN OF RIDGELAND, JASPER COUNTY, SOUTH CAROLINA

[redacted]

GENERAL DRAWING SYMBOLS

SECTION LETTER IDENTIFICATION
SHEET WHERE THE SECTION IS DRAWN

SECTION LETTER IDENTIFICATION
SHEET WHERE THE SECTION IS CALLED OUT

DETAIL NUMBER IDENTIFICATION
SHEET WHERE THE DETAIL IS DRAWN

DETAIL NUMBER IDENTIFICATION
SHEET WHERE THE DETAIL IS CALLED OUT

[redacted]

TABLE OF CONTENTS

Contractor's Scope of Work (Effluent Filter):

1. *Provide and install one (1) effluent disk filtration system.*
2. *Provide and install all necessary pipes, fittings, and valves.*
3. *General electrical work and SCADA interconnection.*
4. *System startup and testing.*

Contractor's Scope of Work (Pump Hoists):

1. *Provide and install jib crane and electric hoist at the influent pump station including concrete foundation and general electrical work.*
2. *Reconfigure existing gravity sewer lateral from operations building.*
3. *Provide and install jib crane and electric hoist at the effluent pump station including concrete foundation, canopy footer modifications, and general electrical work.*

VICINITY MAP

TOWN HALL
1 TOWN SQUARE
RIDGELAND, SC 29936

JIMMY MIXSON WRF
366 PREACHER ROAD
RIDGELAND, SC 29936
LAT: 32°29'01.59"N
LONG: 80°58'22.72"W

RELEASE HISTORY

RELEASE	DATE	SHEETS INCLUDED	SHEETS REVISED	DESCRIPTION
A	2/12/26	Sheets 1-8	Sheets 1-8	Issued for Bidding
B	4/6/26	Sheets 1-8	Sheets 1, 3	Addendum #1

Note: These plans have been developed to print on 11x17 paper.

[redacted]

DEVELOPMENT REFERENCE

OWNER / APPLICANT/ PRIMARY PERMITEE:	*Town of Ridgeland* *One Town Square* *Ridgeland, SC 29936*
CIVIL ENGINEER:	*Goldie Associates* *210 W. North Second St.* *Seneca, SC 29678* *(864) 882-8194*

SCDS Construction Permit 41480-WW

USDA Rural Development
Committed to the future of rural communities.

811 Know what's below. Call before you dig.

NOT FOR CONSTRUCTION

NO	DATE	DESCRIPTION	INITIAL	BY
1	4/6/26	RELEASE B		BAR
0	2/12/26			BAR

ENGINEER'S STAMP

GOLDIE ASSOCIATES
210 W. North Second Street
Seneca, SC 29678
Phone: (864) 882-8194
Civil and Environmental Engineering
Environmental Consulting
Utility Operations
Environmental Laboratory
www.goldieassociates.com
WE LISTEN. WE SERVE.

CLIENT *Town of Ridgeland*
PROJECT *Effluent Filter and Pump Hoists*
SHEET TITLE *Cover*

SHEET NO. 1 OF 8
FILE NO. 1636.6.15

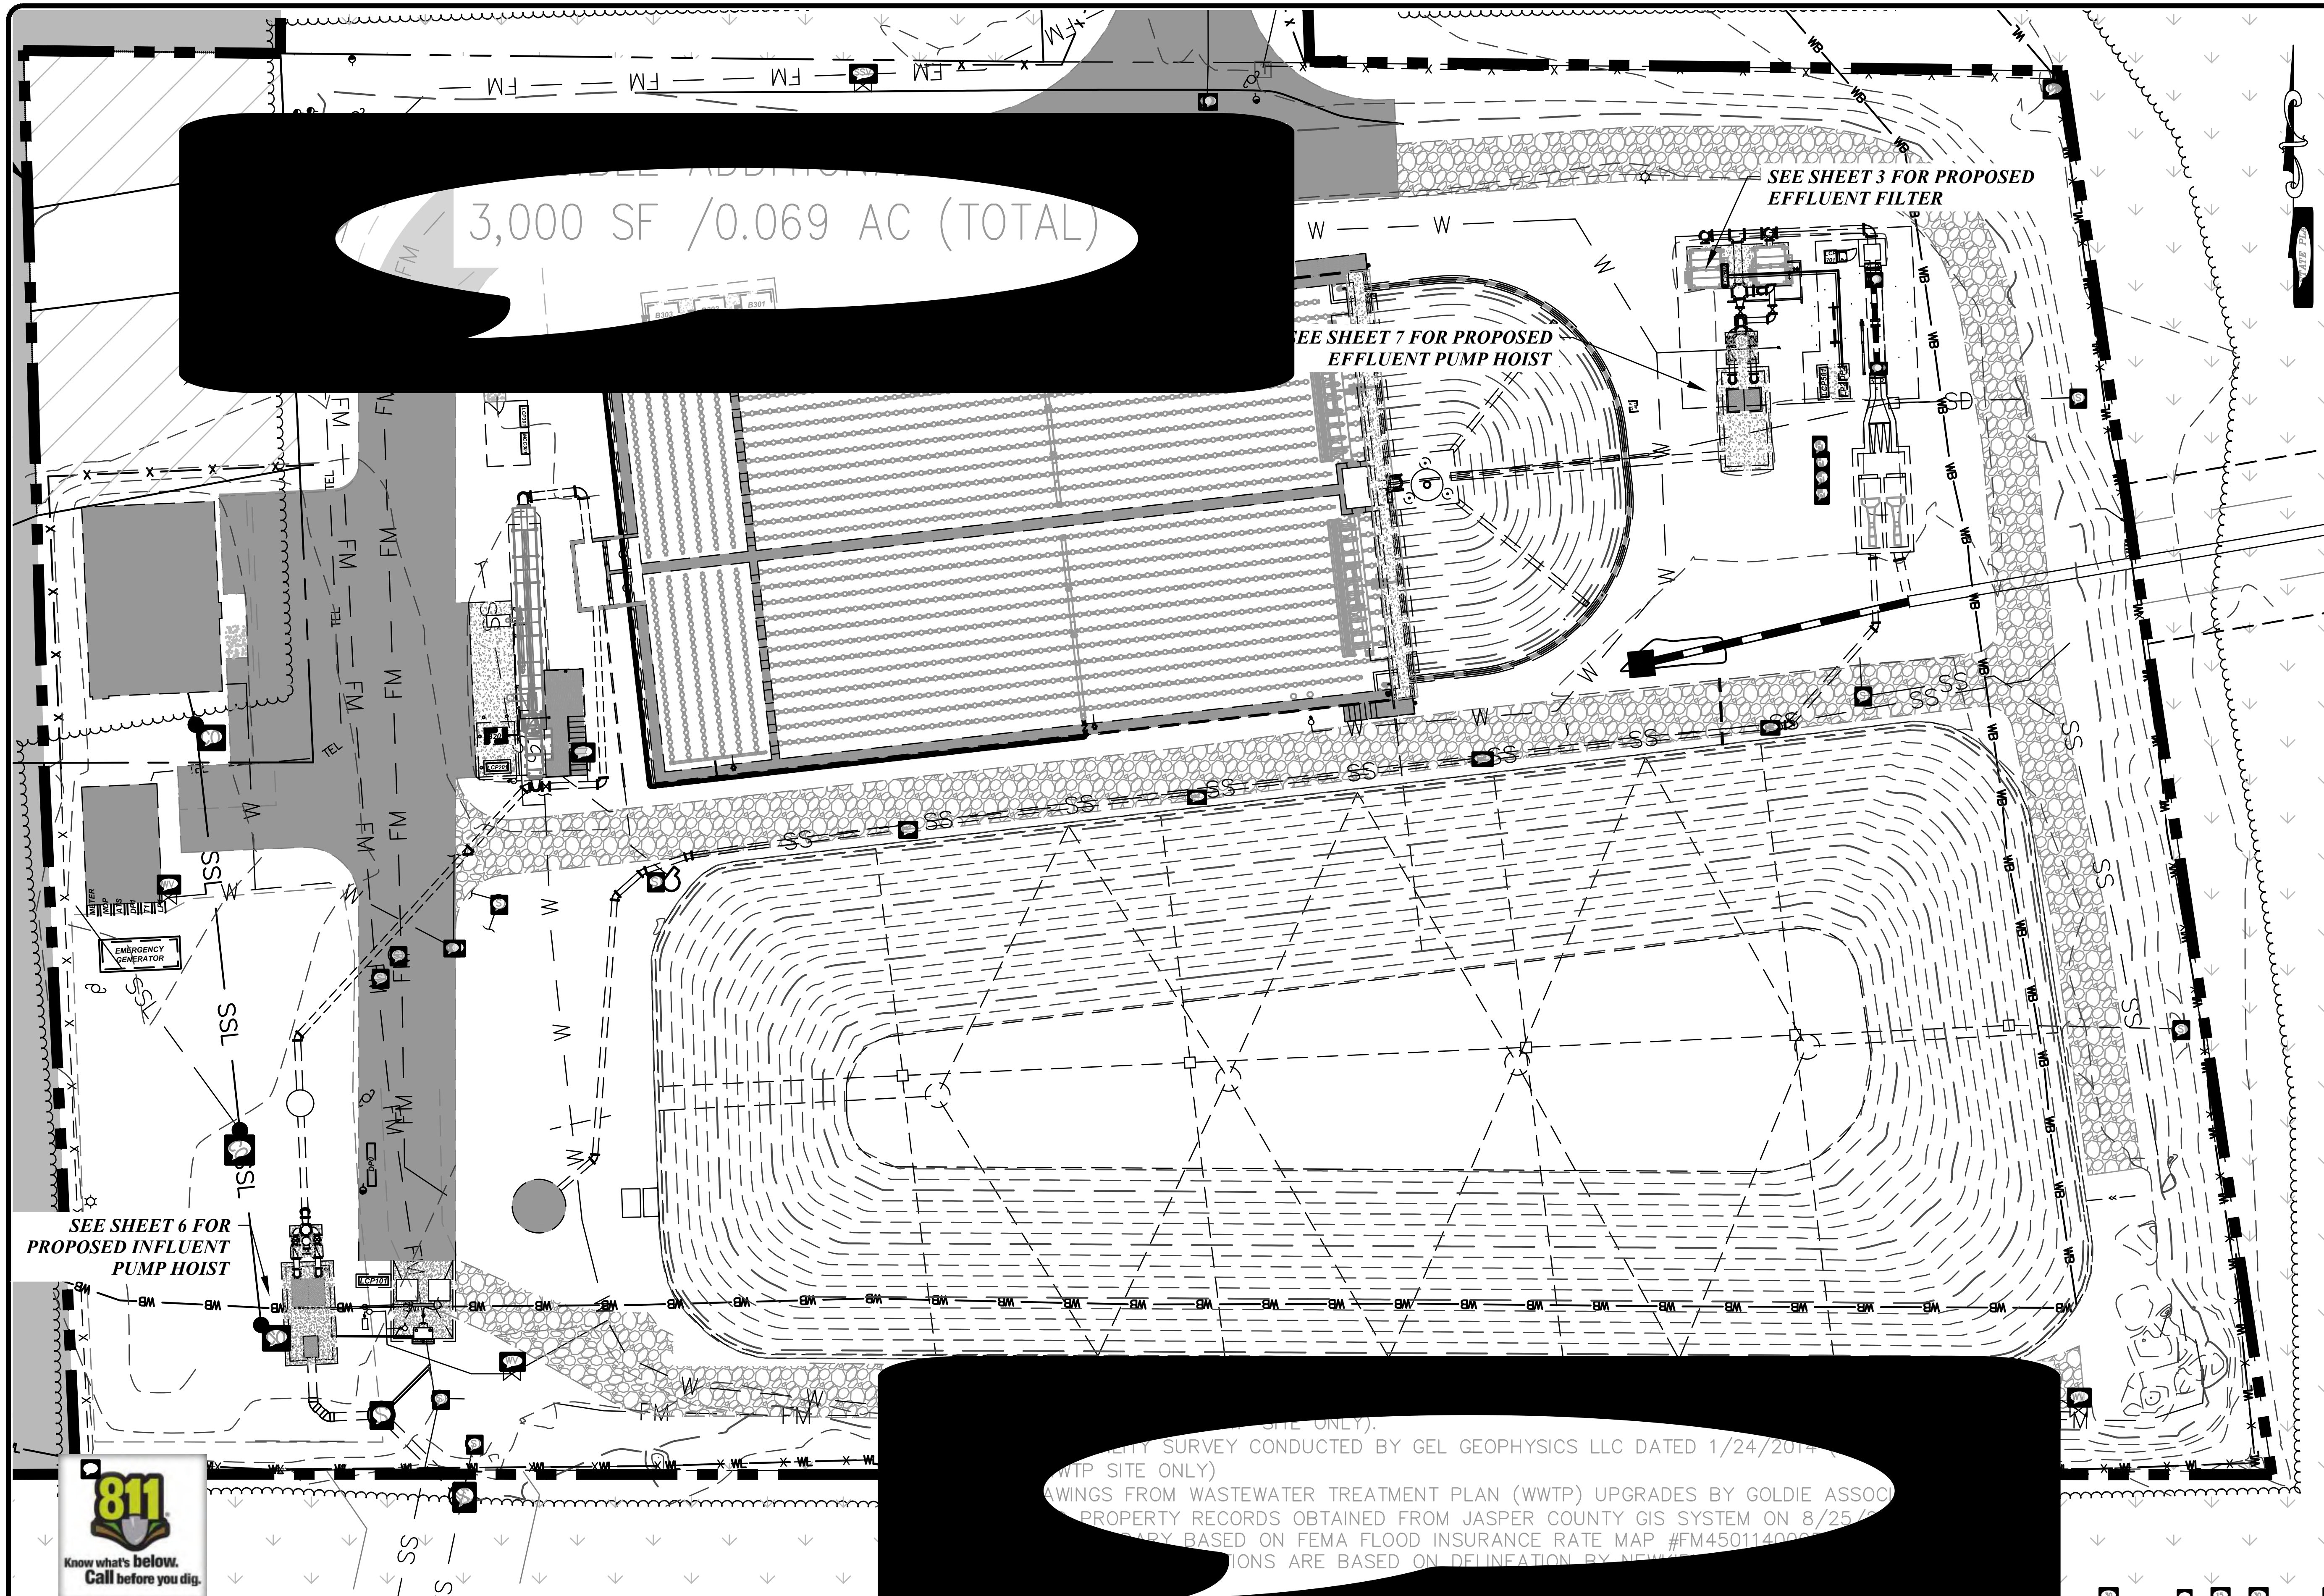

NOT FOR CONSTRUCTION

NO.	DATE	DESCRIPTION	BY
0	2/12/26	INITIAL	BAR

ENGINEER'S STAMP

SOUTH CAROLINA LICENSED PROFESSIONAL ENGINEER No. 40178 BLAKE RODGERS 2/12/26

SOUTH CAROLINA CERTIFICATE OF AUTHORIZATION GOLDIE & ASSOCIATES No. C00328

GOLDIE ASSOCIATES
210 W. North Second Street
Seneca, SC 29678
Phone: (864) 882-8194
Civil and Environmental Engineering
Environmental Consulting
Utility Operations
Environmental Laboratory
www.goldieassociates.com
WE LISTEN. WE SERVE.

CLIENT
Town of Ridgeland

PROJECT
Effluent Filter and Pump Hoists

SHEET TITLE
Existing Conditions Plan

SHEET NO. 2 OF 8

FILE NO. 1636.6.15

Valve Schedule					
Mark	Spec	Size	Service	Type	Actuator
V601	40 23 00	12"	Effluent Filter #1 Inlet	Butterfly	Handwheel
V608	40 23 00	3"	Filter #1 Sediment Drain	PVC Ball	
V609	40 23 00	3"	Filter #1 Backwash Reject	PVC Check	
V610	40 23 00	3"	Filter #1 Backwash Reject	PVC Ball	

 

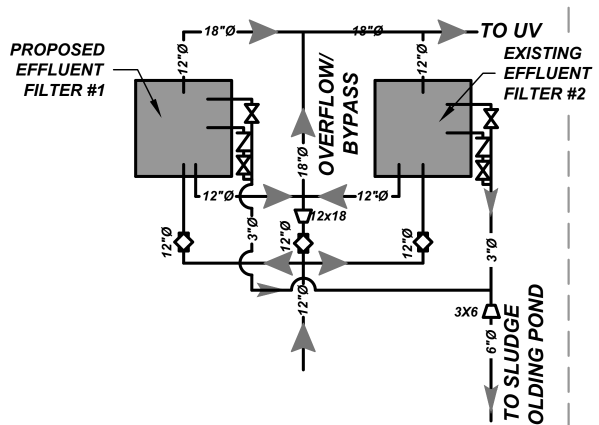

Backwash and Sediment Drain Schematic

NOT TO SCALE

Effluent Filters Plan

SCALE: 1/4" = 1'-0"

NOT FOR CONSTRUCTION

NO	DATE	DESCRIPTION	BY
1	4/6/26	LABEL VALVES AND ADD SCHEDULE	BAR
0	2/12/26	INITIAL	BAR

ENGINEER'S STAMP

GOLDIE
ASSOCIATES
210 W. North Second Street
Seneca, SC 29678
Phone: (864) 882-8194
Civil and Environmental Engineering
Environmental Consulting
Utility Operations
Environmental Laboratory
www.goldieassociates.com
WE LISTEN. WE SERVE.

CLIENT
Town of Ridgeland

PROJECT
Effluent Filter and Pump Hoists

SHEET TITLE
Effluent Filters Plan

SHEET NO.	OF
3	8

FILE NO.
1636.6.15

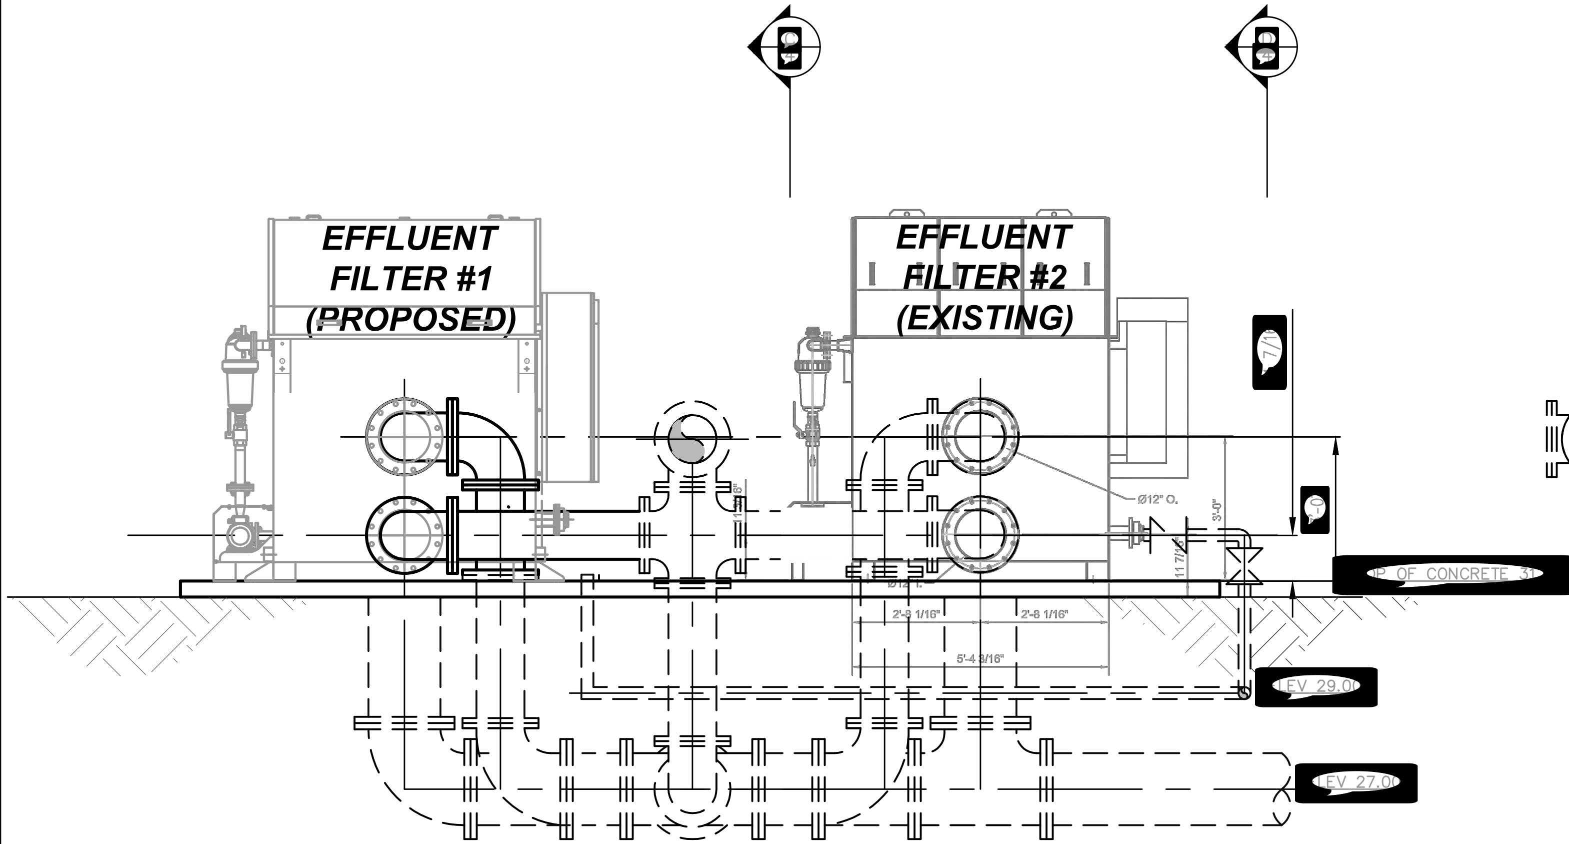

Filter Section
SCALE: 1/2 " = 1'-0"

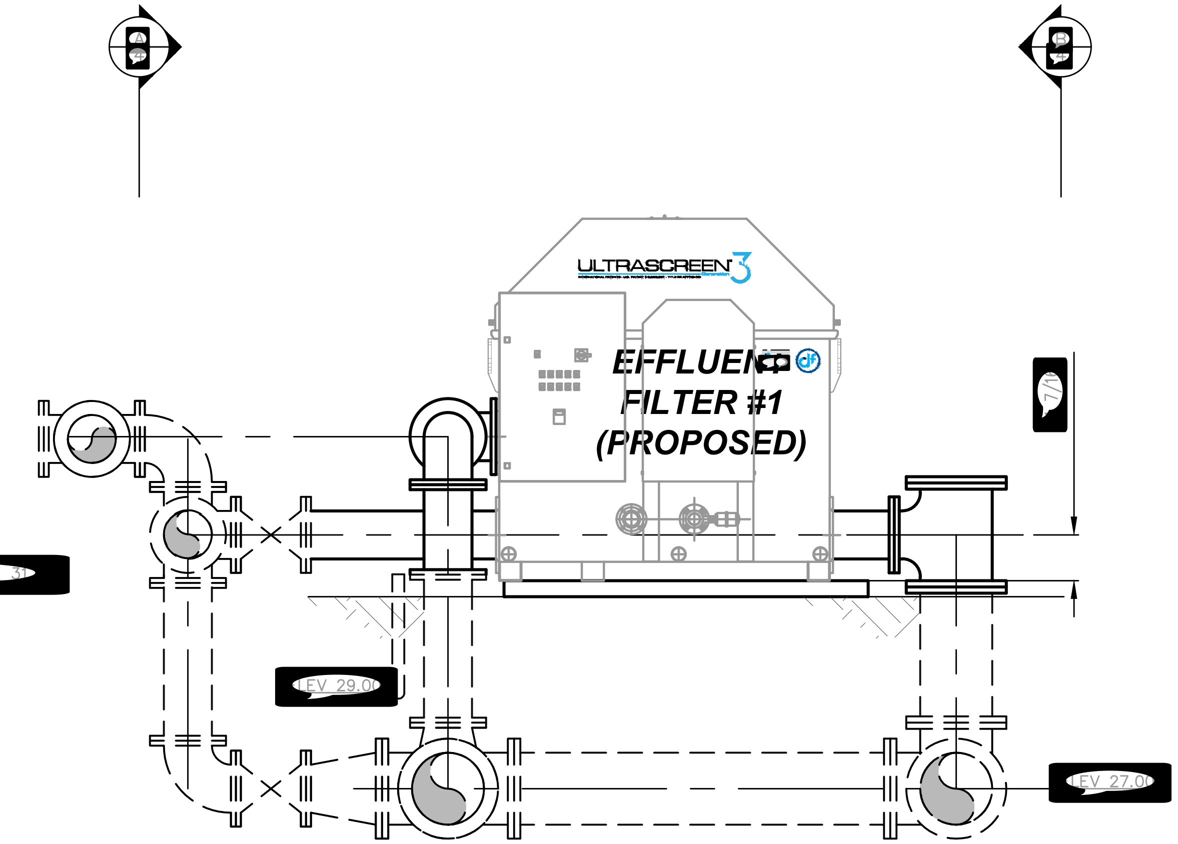

Filter Section
SCALE: 1/2 " = 1'-0"

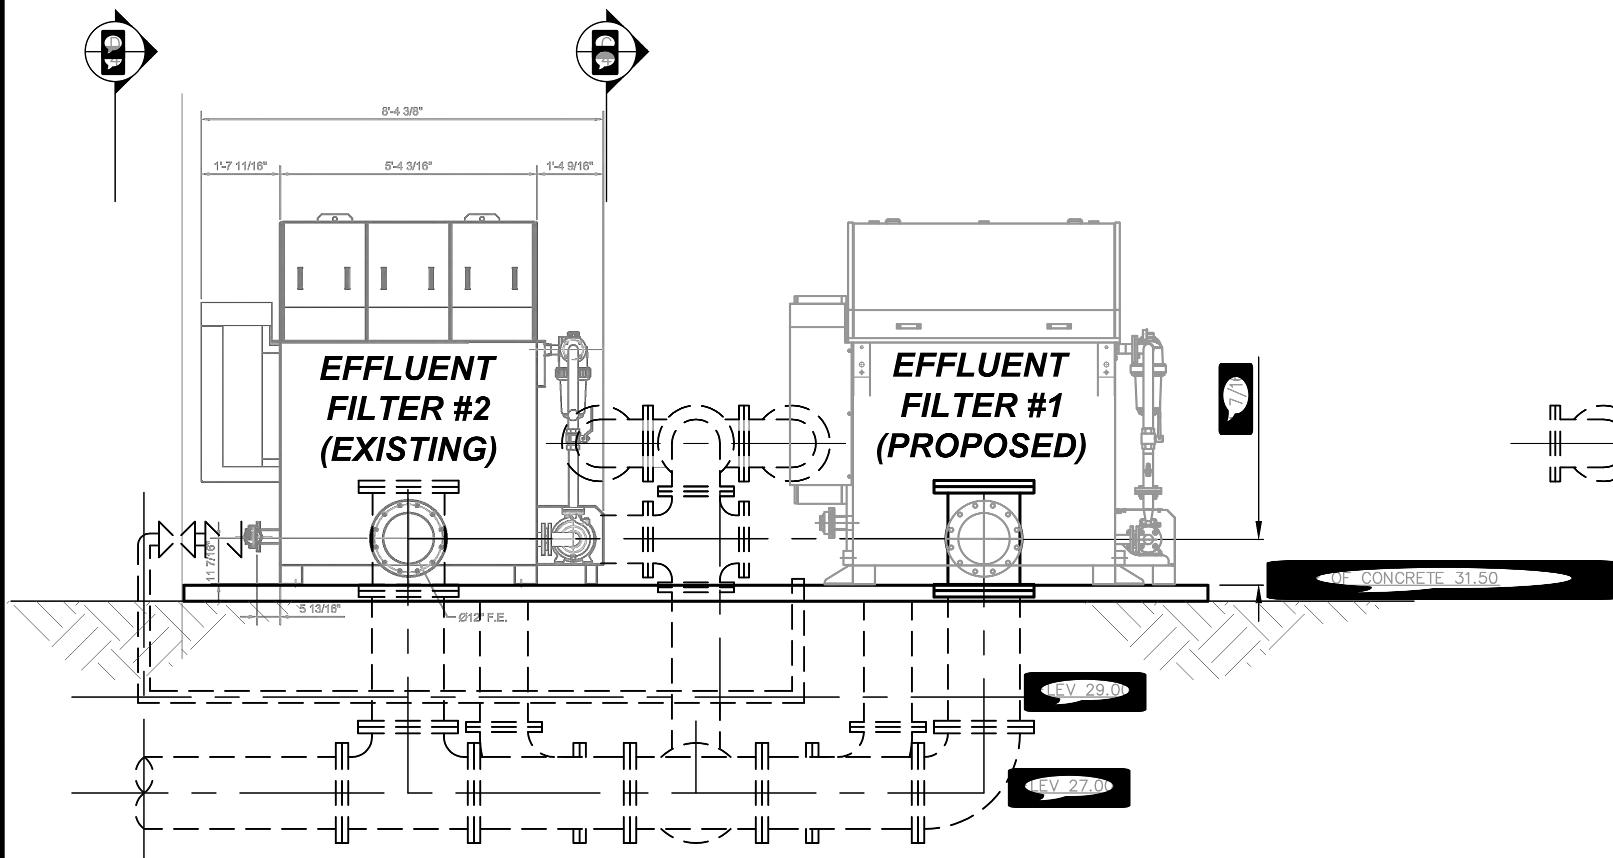

Filter Section
SCALE: 1/2 " = 1'-0"

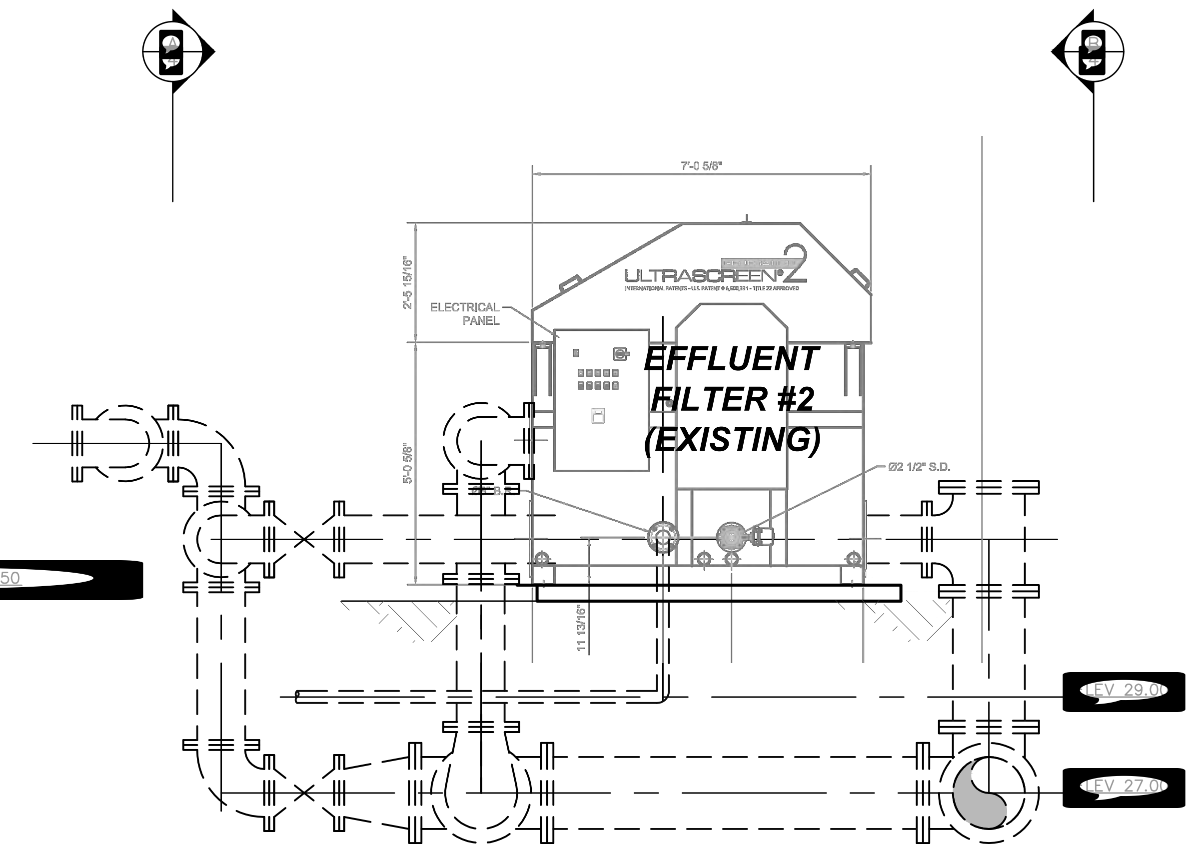

Filter Section
SCALE: 1/2 " = 1'-0"

1/4"=1'-0"

NOT FOR CONSTRUCTION

NO.	DATE	DESCRIPTION	INITIAL	BY
0	2/12/26			

ENGINEER'S STAMP

GOLDIE ASSOCIATES
210 W. North Second Street
Seneca, SC 29678
Phone: (864) 882-8194
Civil and Environmental Engineering
Environmental Consulting
Utility Operations
Environmental Laboratory
www.goldieassociates.com
WE LISTEN. WE SERVE.

CLIENT
Town of Ridgeland

PROJECT
Effluent Filter and Pump Hoists

SHEET TITLE
Effluent Filters Sections

SHEET NO. 4 OF 8

FILE NO. 1636.6.15

Effluent Filters Sections

 

[redacted]

[redacted]

 

Effluent Filter Electrical [redacted]*an*

SCALE: 1" = 10'-0"

GRAPHIC SCALE [redacted]

NO.	DATE	DESCRIPTION	INITIAL	BY	BAR
0	2/12/26				

NOT FOR CONSTRUCTION

ENGINEER'S STAMP

GOLDIE ASSOCIATES

210 W. North Second Street
Seneca, SC 29678
Phone: (864) 882-8194

Civil and Environmental Engineering
Environmental Consulting
Utility Operations
Environmental Laboratory

www.goldieassociates.com
WE LISTEN. WE SERVE.

CLIENT *Town of Ridgeland*

PROJECT *Effluent Filter and Pump Hoists*

SHEET TITLE *Electrical Layout Plan and 1-Line Diagram*

SHEET NO.	OF
5	8

FILE NO. 1636.6.15

 

1 0 1 2 3 4 5 6 7 8

[redacted]

1/4"=1'-0"

NOT FOR CONSTRUCTION

NO.	DATE	DESCRIPTION	INITIAL	BY
0	2/12/26	INITIAL		BAR

ENGINEER'S STAMP

GOLDIE ASSOCIATES
210 W. North Second Street
Seneca, SC 29678
Phone: (864) 882-8194
Civil and Environmental Engineering
Environmental Consulting
Utility Operations
Environmental Laboratory
www.goldieassociates.com
WE LISTEN. WE SERVE.

CLIENT
Town of Ridgeland

PROJECT
Effluent Filter and Pump Hoists

SHEET TITLE
Influent Pump Hoist Plan and Section

SHEET NO.	OF
6	8

FILE NO.
1636.6.15

 

NOT FOR CONSTRUCTION

NO.	DATE	INITIAL	DESCRIPTION	BY
0	2/12/26			BAR

ENGINEER'S STAMP

210 W. North Second Street
Seneca, SC 29678
Phone: (864) 882-8194

Civil and Environmental Engineering
Environmental Consulting
Utility Operations
Environmental Laboratory

GOLDIE ASSOCIATES

www.goldieassociates.com
WE LISTEN. WE SERVE.

CLIENT
Town of Ridgeland

PROJECT
Effluent Filter and Pump Hoists

SHEET TITLE
Effluent Pump Hoist Plan and Section

SHEET NO. 7 OF 8

FILE NO. 1636.6.15

Influent Pump Station

 

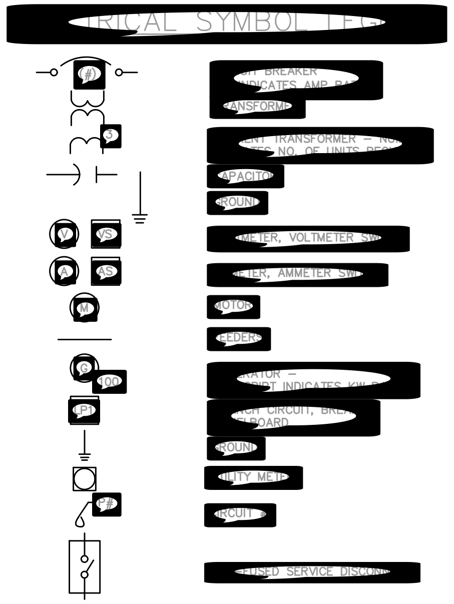

[redacted]

Effluent Pump Station

 

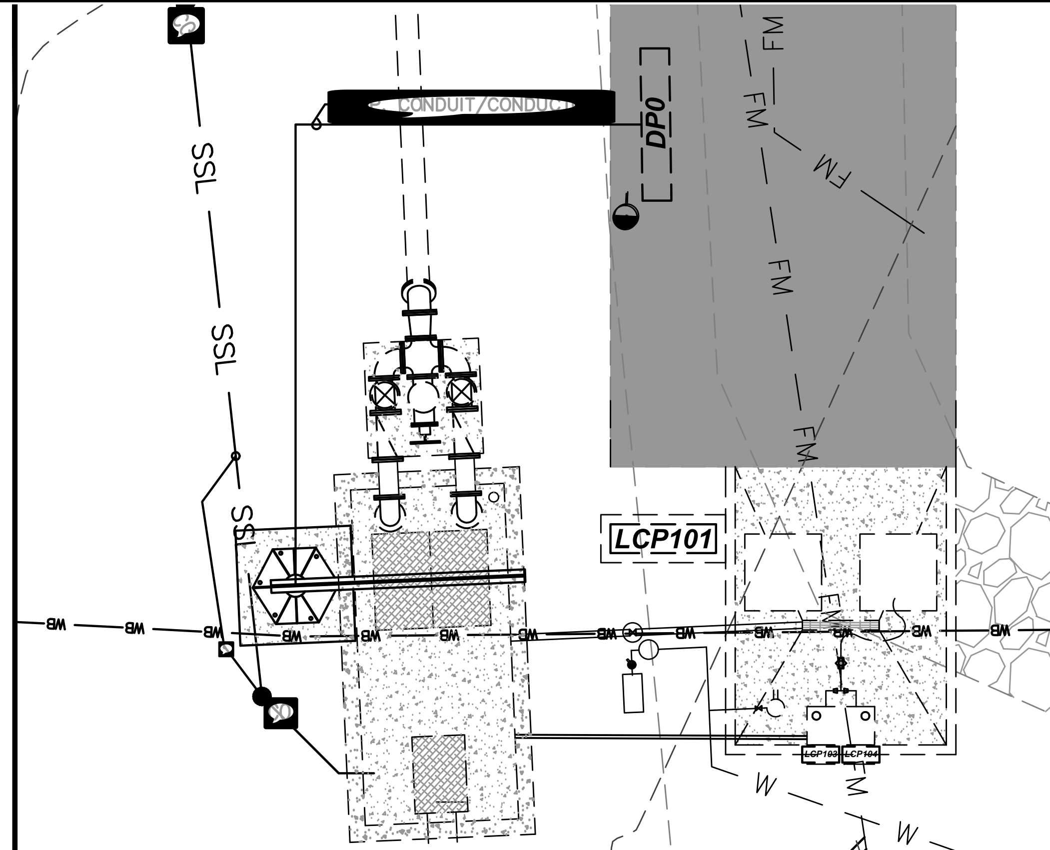

Influent Wetwell Pump Hoist Plan

SCALE: 1" = 10'-0"

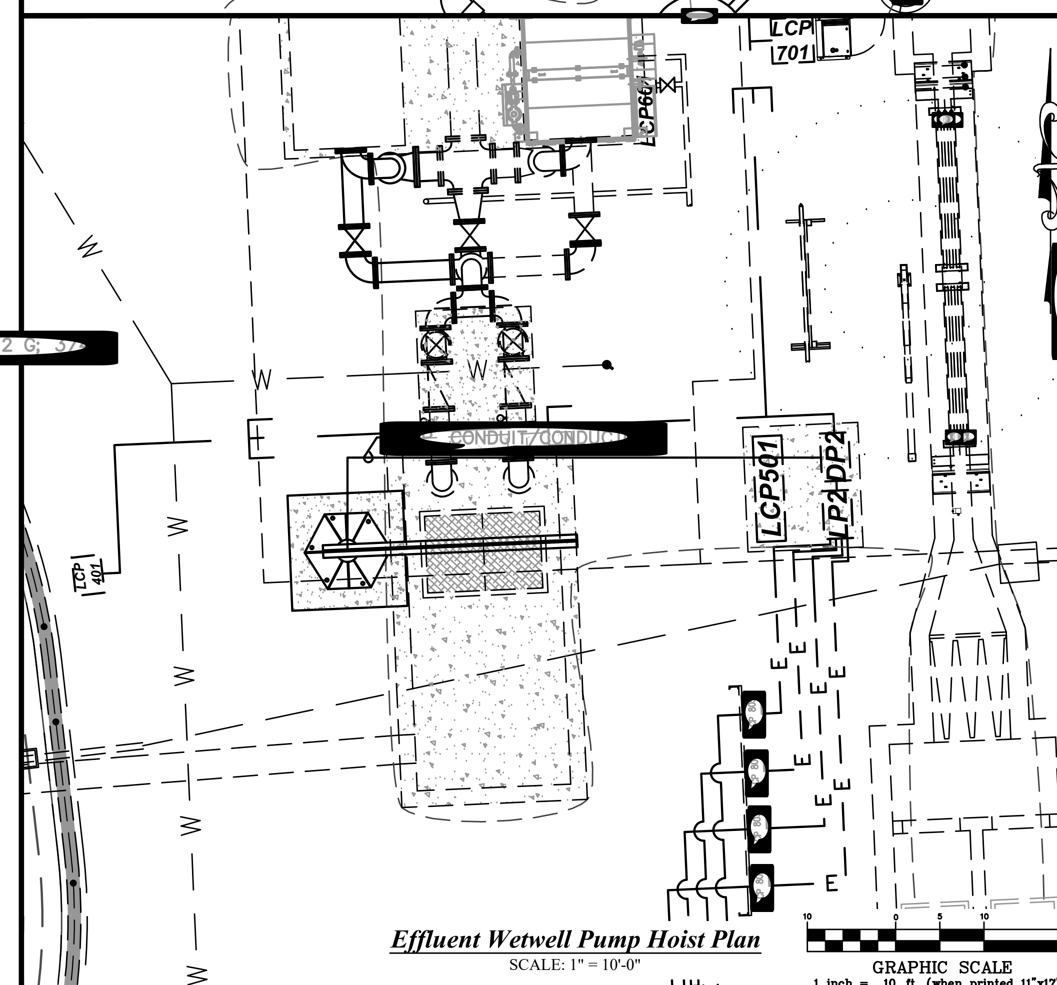

Effluent Wetwell Pump Hoist Plan

SCALE: 1" = 10'-0"

NOT FOR CONSTRUCTION

NO.	DATE	INITIAL	DESCRIPTION	BY	BAR
0	2/12/26				

ENGINEER'S STAMP

SOUTH CAROLINA GOLDIE & ASSOCIATES No. C00328 CERTIFICATE OF AUTHORIZATION

GOLDIE — ASSOCIATES —
210 W. North Second Street
Seneca, SC 29678
Phone: (864) 882-8194
Civil and Environmental Engineering
Environmental Consulting
Utility Operations
Environmental Laboratory
www.goldieassociates.com
WE LISTEN. WE SERVE.

CLIENT
Town of Ridgeland

PROJECT
Effluent Filter and Pump Hoists

SHEET TITLE
Pump Hoist Electrical Plans and One-Line Diagrams

SHEET NO.	OF
8	8

FILE NO.
1636.6.15

STATE OF SOUTH CAROLINA
DEPARTMENT OF REVENUE
EXEMPTION CERTIFICATE

ST-9
(Rev. 01/17/17)
5011

NOT VALID WHEN EXTENDED TO CONSTRUCTION CONTRACTORS THEIR SUB-CONTRACTORS, OR THEIR MATERIAL SUPPLY MEN.

This certificate is issued in accordance with Section 12-36-2120 of Article 21, Section 12-36-120 of Article 1, Section 12-36-2510 of Article 25 of Chapter 36 of title 12, Section 58-25-80 of title 58, or Section 44-96-160(V)(1) of title 44 of the Code of Laws of South Carolina 1976, as amended.

Letter ID: L0006742569

TOWN OF RIDGELAND
PO BOX 1119
RIDGELAND SC 29936-2619

CERTIFICATE ISSUED TO:
TOWN OF RIDGELAND
1 TOWN SQUARE
RIDGELAND SC 29936

CERTIFICATE NUMBER: 1472689

EXEMPTION START DATE: see date(s) below

EXEMPTIONS: 12-36-2120(9)(a-d),(17),(19); 12-36-120(2)

NOTICE: If there is a number in parentheses, which is a part of your certificate number, it has a reference to the specific type(s) of exemptions granted by this certificate. **Should this property be diverted to a taxable use, liability for payment of the tax thereon rests with your company. In the event the nature of your operations changes, you should notify the Department of Revenue immediately as this could affect the validity of this certificate.**

It will be necessary for you to return the original Certificate to this office if your account is ever closed or cancelled.

SCHEDULE OF EXEMPTION UNDER SECTION 12-36-2120 of Article 21

May 15, 2018 (9)(a-d) Coal, coke, or other fuel for manufacturers, transportation companies, electric power companies, and processors

May 15, 2018 (17) Machines used in manufacturing, processing, recycling, compounding, mining, or quarrying tangible personal property for sale. This includes certain machines used to prevent or abate air, water, or noise pollution caused by machines used in manufacturing, processing, recycling, compounding, mining, or quarrying tangible personal property for sale

May 15, 2018 (19) Electricity used to manufacture, process, mine, or quarry tangible personal property for sale or used by cotton gins to manufacture tangible personal property for sale

EXCLUSIONS UNDER SECTION 12-36-120 of Article 1

May 15, 2018 (2) Sales of tangible personal property to a manufacturer or compounder as an ingredient or component part of the tangible personal property or product manufactured or compounded for sale.

JP:8963E:03244S:010IN:0A#:A20684988955J:000010583

SECTION 41 22 13.19

JIB CRANE

PART 1 GENERAL

1.01 SUMMARY
This section specifies the requirements for furnishing and installing two (2) free-standing jib cranes, including mast column, boom, trolley, foundation, and all associated hardware. The crane shall be a Gorbel Model FS300-12-W10, or approved equal.

1.02 REFERENCES
The following standards and codes form part of this specification to the extent referenced herein. In case of conflict between the referenced standards and this specification, the more stringent requirement shall govern.

1. OSHA 29 CRF 1910.179 – Overhead and Gantry Cranes
2. ASME B30.11 – Monorails and Underhung Cranes
3. ASME BTH-1 – Design of Below-the-Hook Lifting Devices
4. AISC 360 – Specification for Structural Steel Buildings
5. ACI 318 – Building Code Requirements for Structural Concrete
6. AWS D1.1 – Structural Welding Code – Steel
7. CMAA Specification No. 74 – Top Running and Under Running Single Girder Electric Overhead Travel Cranes
8. Section 01 33 00 – Submittals
9. Section 09 90 05 – Painting & Protective Coatings

1.03 SUBMITTALS
Submittals shall be in accordance with Section 01 33 00 – Submittals and include the following for review and approval prior to fabrication:

A. Shop drawings showing all dimensions, connection details, base plate geometry, anchor bolt layout, and boom configuration.
B. Structural calculations sealed by a Professional Engineer registered in the state where the project is located.
C. Foundation design drawings and calculations, confirming compatibility with the site geotechnical report.
D. Manufacturer’s product data including crane rated capacity, component specifications, finish information, and installation instructions.
E. Manufacturer’s warranty documentation.
F. Load test certificates upon completion of installation.

1.04 QUALITY ASSURANCE
The crane manufacturer shall be regularly engaged in the design and fabrication of jib cranes and shall have a minimum of ten (10) years of experience producing equipment of the type specified. All welding shall conform to AWS D1.1. The crane system shall be designed, manufactured, and tested in accordance with the applicable provisions of OSHA, ASME, and CMAA standards referenced herein.

1.05 Warranty
The manufacturer shall provide a minimum one (1) year warranty covering defects in materials and workmanship from the date of substantial completion. Structural components shall carry a minimum five (5) year warranty against structural failure under normal use within the rated capacity.

PART 2 PRODUCTS

2.01 CRANE EQUIPMENT
The jib crane shall be a Gorbel Model FS300-12-W10 free-standing type, or approved equal meeting the performance parameters specified herein. The crane shall have the following characteristics:

Parameter	Requirement
Manufacturer	Gorbel
Model	FS300-12-W10
Type	Free-standing, full-cantilever jib crane
Rated Capacity	1 Ton (2,000 lbs)
Boom Span	12’-0”
Trolley Travel	10’-3 3/4”
Height Under Boom (H.U.B.)	10’-0”
Overall Height	10’-11 15/16” (10.996 ft)
Rotation	360 degrees

2.02 STRUCTURAL COMPONENTS

A. Mast Column
The mast column shall be a W10 x 26 structural steel wide-flange section conforming to ASTM A992/A992M, Grade 50. The column shall be shop-fabricated with the base plate and hub assembly pre-welded. The hub assembly shall be located at 10’-0” above the top of the base plate (grout line).

B. Boom

The boom shall be a structural steel member spanning 12’-0” from the center of the mast, providing an effective trolley travel of 10’-3 3/4”. The boom shall be designed for 360-degree rotation about the mast and shall incorporate thrust bearings at the hub connection.

C. Base Plate

The base plate shall be 1-1/4” thick structural steel. The anchor bolt pattern shall be as follows:

Parameter	Requirement
Bolt Circle Diameter	24”
Number of Anchor Bolts	6
Anchor Bolt Diameter	1-1/4”
Bolt Offset (typical)	2”
Base Plate Dimensions	12 3/4” x 8 1/2” (at anchor bolt location)

2.03 TROLLEY AND HOIST
The trolley shall be a manual push-type suited for operation on the boom profile. The hoist shall be provided by others unless otherwise indicated in the contract documents. The hoist shall not exceed the 1-ton rated capacity of the crane and shall be compatible with the trolley and boom configuration. The Contractor shall verify hoist compatibility with the crane manufacturer prior to procurement.

2.04 FINISH
All structural steel components shall receive a shop-applied primer coat conforming to SSPC-SP6 surface preparation (commercial blast cleaning) with a minimum dry film thickness of 3.0 mils. Field touchup of primer shall be performed at all areas damaged during shipping and erection. Final finish coating shall be as specified Section 09 90 05 – Painting & Protective Coatings.

PART 3 EXECUTION

3.01 FOUNDATION
The foundation shall be designed and constructed in accordance with the crane manufacturer’s requirements and the project geotechnical report. The following minimum parameters, taken from the supplier drawing, shall apply:

Parameter	Requirement
Foundation Plan Dimensions	6’-0” x 6’-0” (square)
Foundation Depth	4’-0”
Concrete Compressive Strength (f’c)	3,000 psi minimum
Allowable Soil Bearing Pressure	2,500 psf minimum
Reinforcing (Top)	No. 5 bars (#5, 5/8” dia.) at 12” on center, each way
Reinforcing (Bottom)	No. 6 bars (#6, 3/4” dia.) at 12” on center, each way
Grout Pad	1” non-shrink grout under base plate

Anchor bolts shall be cast-in-place and set to the dimensions and tolerances indicated by the manufacturer. Anchor bolt projection, embedment depth, and edge distances shall be verified against the manufacturer’s requirements.

3.02 INSTALLATION

Installation shall be performed by an experienced rigging contractor familiar with jib crane erection. Installation shall conform to the crane manufacturer's written installation instructions and the following requirements:

A. The foundation shall be installed in accordance with Section 03 30 00 – Cast In Place Concrete
B. The foundation shall achieve a minimum of 75 percent of the specified 28-day compressive strength before erection of the crane column.
C. The mast column shall be plumbed to within 1/8" per 10 feet of height, or the manufacturer's tolerance, whichever is more stringent.
D. Non-shrink grout shall be placed to a depth of 1" between the base plate and the top of the concrete pedestal. Grout shall be mixed and placed in accordance with the grout manufacturer's recommendations.
E. All anchor bolts shall be torqued to the crane manufacturer's specified values using a calibrated torque wrench.
F. The boom shall rotate freely through 360 degrees without binding, interference, or excessive deflection.
G. Do not scale from the supplier drawing. All field dimensions shall be verified against the actual equipment received.

3.03 LOAD TESTING

Upon completion of installation, the crane shall be load tested in accordance with ASME B30.11. The test shall include the following:

A. A rated load test at 100 percent of the crane's rated capacity (1 ton), with the load traversed the full length of the boom and rotated through 360 degrees.
B. An overload test at 125 percent of the rated capacity (2,500 lbs), held in the most adverse position for a minimum of 10 minutes.
C. Verification that no permanent deformation, structural distress, or excessive deflection has occurred following the overload test.

Load test results shall be documented and submitted to the Engineer. The crane shall not be placed into service until the load test has been completed satisfactorily and the test report has been accepted.

3.04 FIELD QUALITY CONTROL

The Contractor shall inspect all welds, bolted connections, and structural members for compliance with the contract documents and referenced standards. All field welds shall be performed by certified welders and shall comply with AWS D1.1. The Engineer reserves the right to require independent third-party inspection of critical connections.

3.05 CLOSEOUT

Upon completion and acceptance of load testing, the Contractor shall submit the following closeout documentation:

A. As-built drawings reflecting actual installed conditions.
B. Load test certificates and inspection reports.
C. Manufacturer’s operation and maintenance manuals.
D. Manufacturer’s warranty certificate.
E. Spare parts list and recommended maintenance schedule.

[END OF SECTION]


GENERATION
ULTRASCREEN® 2
INTERNATIONAL PATENTS - U.S. PATENT # 6,500,331 - TITLE 22 APPROVED


GENERATION
ULTRASCREEN® 2
INTERNATIONAL PATENTS - U.S. PATENT # 6,500,331 - TITLE 22 APPROVED